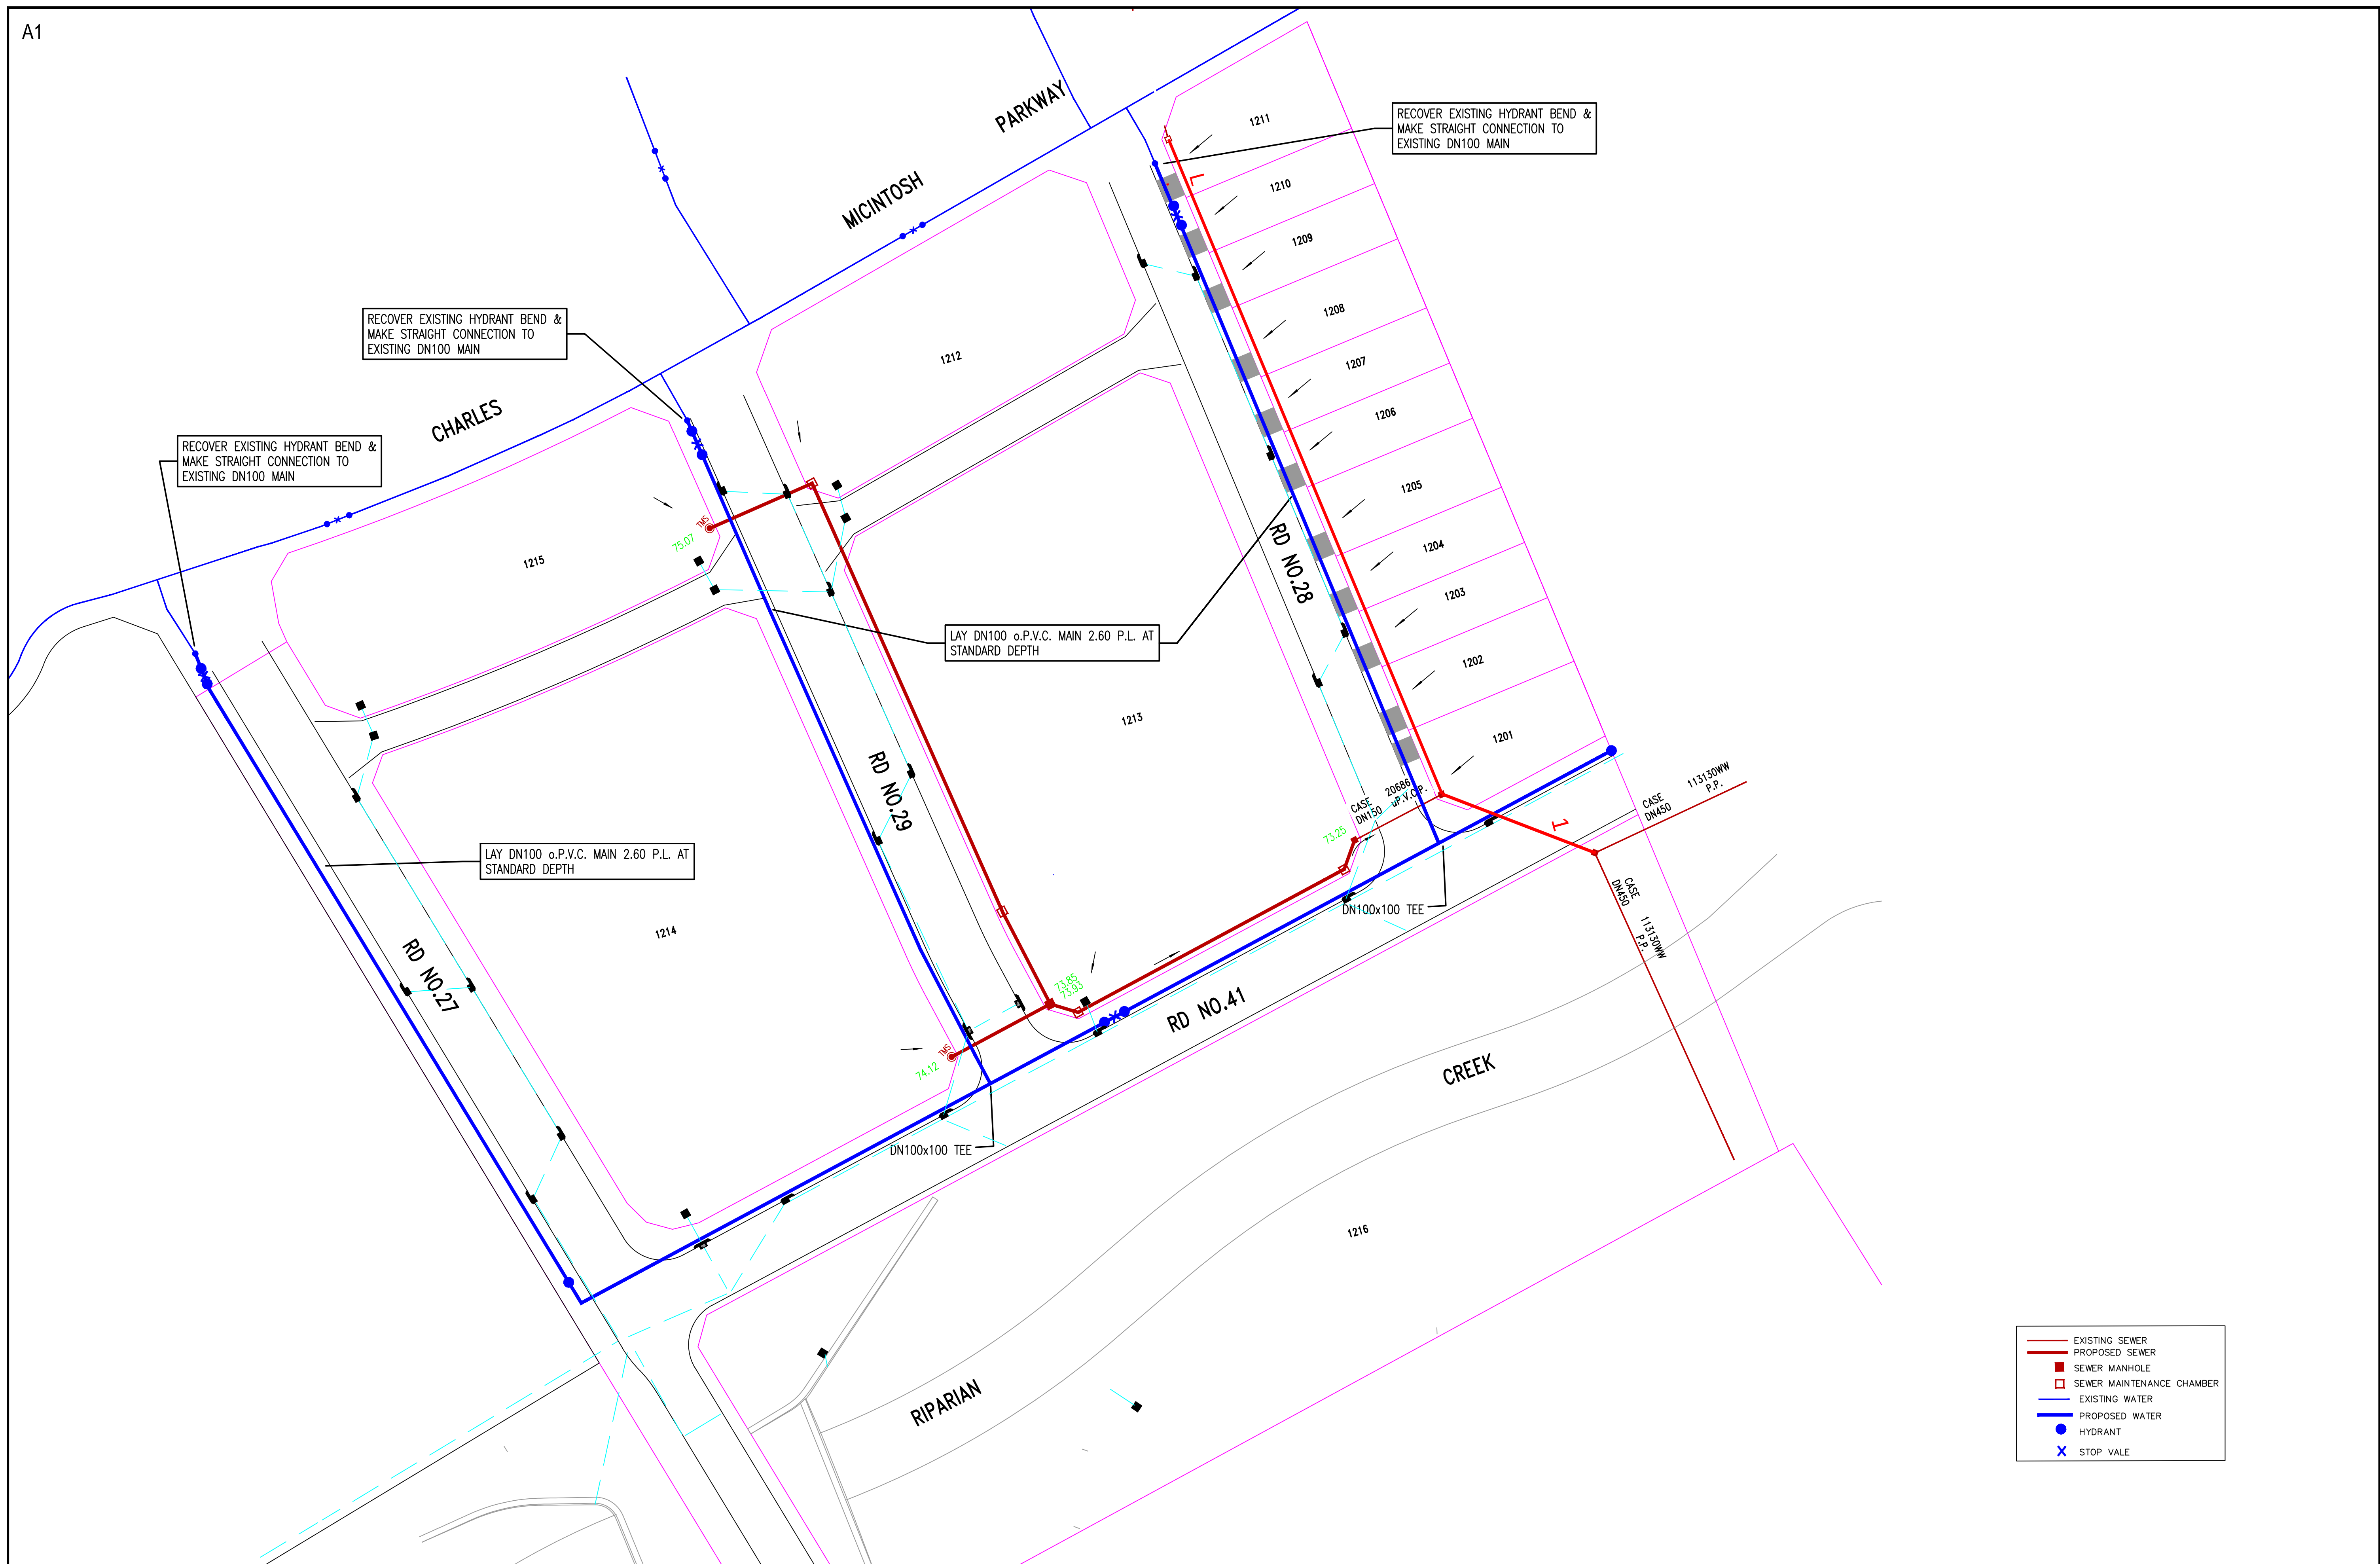




EXISTING SEWER

PROPOSED SEWER

SEWER MANHOLE

SEWER MAINTENANCE CHAMBER

EXISTING WATER

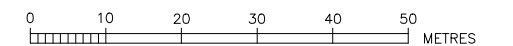
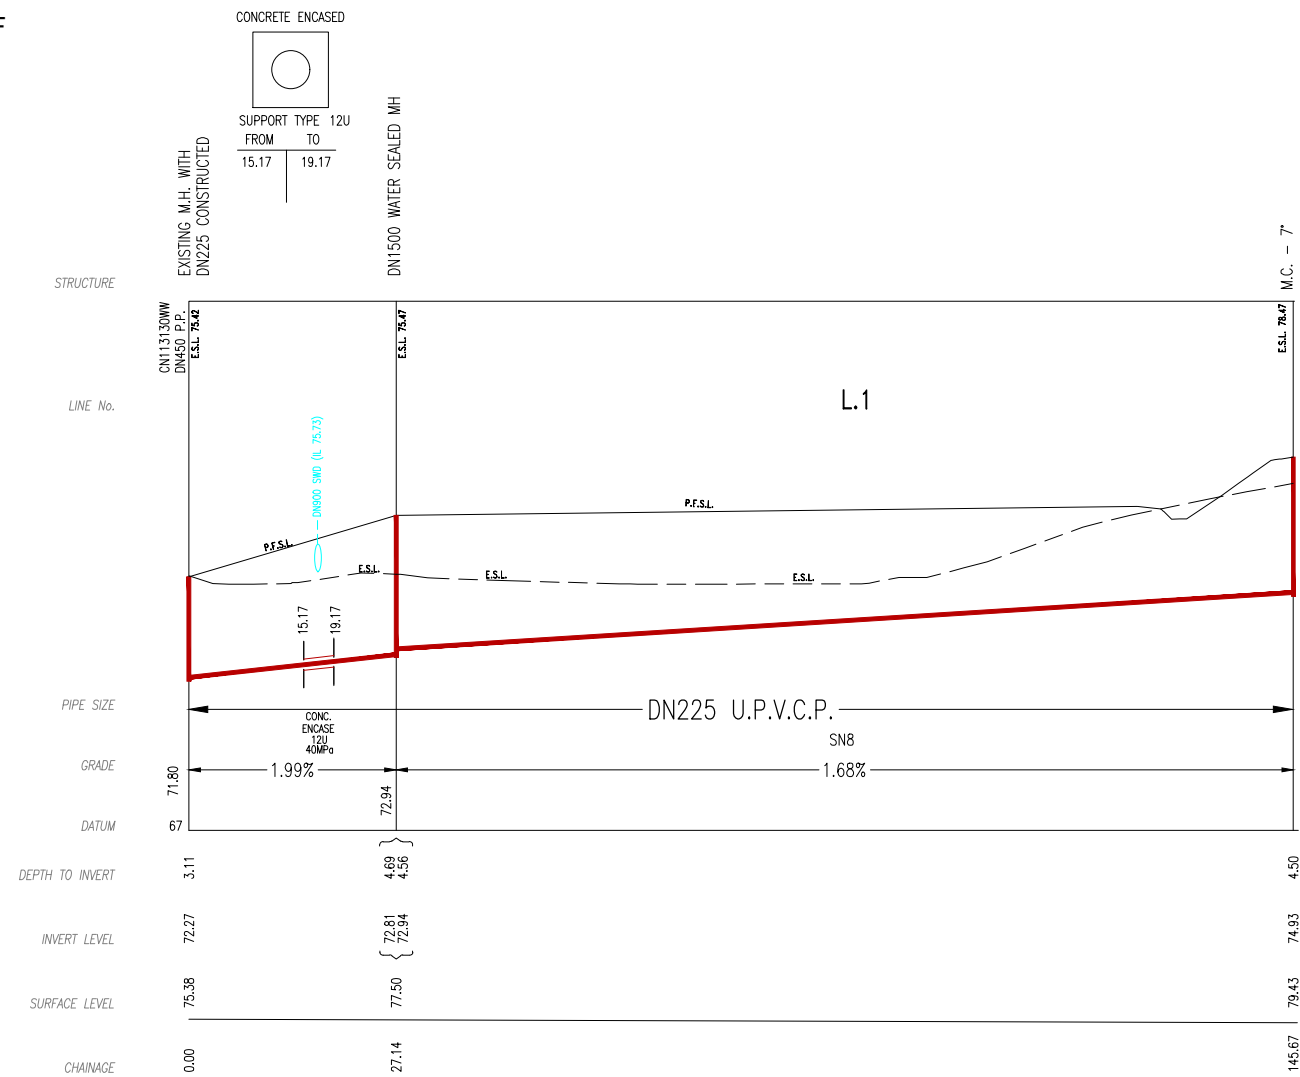
PROPOSED WATER

HYDRANT

STOP VALE

EXISTING LOTS (Proposed Development of)				DEVELOPMENT TYPE		NUMBER OF PROPOSED LOTS / UNITS	PRE ALLOCATED PLAN NUMBER	U.B. DIRECTORY		Water Service Co-Ordinator: Orion Consulting Engineers Pty Ltd Suite 4.04, 12 CENTURY CCT NORWEST NSW 2153 Ph. (02) 8860 0035
(1)		(7)		CONCEPT				SCALE 1:500		
(2)		(8)				Total Lots	0			
(3)		(9)				MUNICIPALITY	Total Units	0		
(4)		(10)								
(5)		(11)						SHEET 1 OF 1	eDeveloper Case No.	
(6)		(12)								

A1F

DEVELOPER CONTRACT PLAN
WORK-AS-CONSTRUCTED

5	WORK AS CONSTRUCTED	RA	16.12.24
4	AMENDED PROP SWD TO SUIT CLEARANCE TO EXISTING SEWER MAIN	RA	03.06.24
3	CONCRETE ENCASMENT ADDED TO EXISTING MAIN	RA	29.04.24
2	UPDATED CATCHMENT,ADDRESSED SWC COMMENTS	RA	26.03.24
1	ISSUE FOR TENDER	RA	29.11.23
No.	AMENDMENT DESCRIPTION	BY	DATE

WORK AS CONSTRUCTED CERTIFICATION		Sydney WATER SYDNEY WATER CORPORATION	
DEVELOPER	MIRIAM HOMES (NSW) PTY LTD	Case No. 206861WW SHT 2 OF 2 SHTS.	
W.S.C.	ORION CONSULTING ENGINEERS PTY. LTD.		
CONSTRUCTOR	CAREY CONSTRUCTION PTY. LTD.		
COMPLETED	21-11-2024		
W.A.C. PREPARED	16.12.2024		
DESIGNER . . . ORION CONSULTING ENGINEERS PTY. LTD.		SYDNEY WATER CORPORATION	
I CERTIFY THAT THE WORKS HAVE BEEN CONSTRUCTED IN ACCORDANCE WITH THE WORK AS CONSTRUCTED DRAWINGS		FOR DETAILS OF SERVICES SEE SHEET 1	

2
1
1
4
5