Prepared by:

ORION

CONSULT AUSTRALIA
Member Firm

Prepared for:

mirvac

LGA:

camden council

DA/2023/215/1

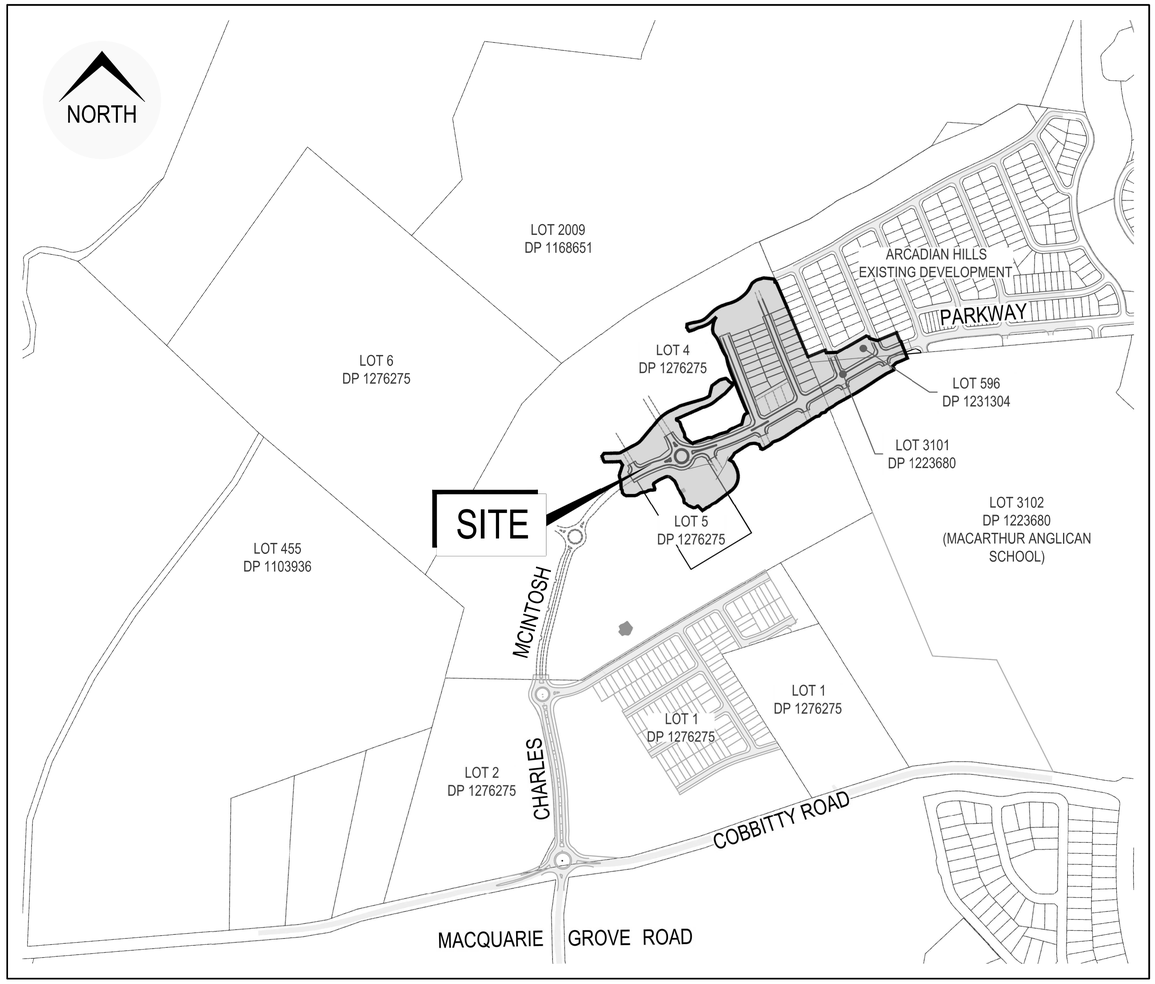

SITE / LOCATION (Image courtesy of Nearmap 12.08.2023)

WORKS AS EXECUTED
WORKS AS EXECUTED INFORMATION SHOWN IN RED.
DATE: 07/02/2025
REGISTERED SURVEYOR ID: 8890
ORION GROUP

CAMDEN COUNCIL
Approved by the Council of Camden under the provisions of the Environment Planning and Assessment Act 1979
APPROVAL

22/03/2024

SUBDIVISION WORKS CERTIFICATE

DA/2023/215/1 SWC.16.2023.215.1

LOT 4, 5 & 6, D.P. 1276275
LOT 596, D.P. 1231304
LOT 3101, D.P. 1223680

589, 591 & 593 COBBITTY ROAD, COBBITTY (TRANCHE 4, STAGE 3a.)

ROAD & DRAINAGE DESIGN

ISSUED FOR SUBDIVISION WORKS CERTIFICATE

Project No. 23-0563 Set No. 01 Milestone SWC Plan 000 Revision G

NORTH

LOT 2009
DP 1168651

LOT 143

LOT 142

ROAD 30

ROAD 40

ROAD 40A

ROAD 24

ROAD 27

ROAD 29

ROAD 28

CHARLES

MCINTOSH

HOOK STREET

WISTERIA RISE

PARKWAY

TEMPORARY
BASIN PD01A

ARCADIAN HILLS
EXISTING DEVELOPMENT

LOT 3102, DP 1223680
(MACARTHUR ANGLICAN SCHOOL)
INDICATIVE FUTURE DESIGN

A 007 — B 007 — C 008 — D 008

CAMDEN COUNCIL
Approved by the Council of Camden under the provisions of the Environment Planning and Assessment Act 1979
APPROVAL

02/07/2024

SUBDIVISION WORKS CERTIFICATE

DA/DA/2023/215/2 SWC.16.2023.215.2

WORKS AS EXECUTED

WORKS AS EXECUTED INFORMATION SHOWN IN RED.
DATE: 07/02/2025

REGISTERED SURVEYOR ID: 8890
ORION GROUP

BEFORE YOU DIG
www.byda.com.au
Zero Damage - Zero Harm

UTILITIES SHOWN ARE DIAGRAMMATIC ONLY AND MAY NOT INCLUDE ALL SERVICES WITHIN THE LIMIT OF WORKS.

IT IS THE RESPONSIBILITY OF THE CONTRACTOR TO VERIFY, LOCATE AND AVOID DAMAGE TO THEM AS SPECIFIED BY EACH UTILITIES EXCAVATION GUIDE LINES/STANDARDS.

ISSUED FOR SUBDIVISION WORKS CERTIFICATE

Rev	Drawn	Design	Check	Appd.	Date	Revision Description
B	WP	LMc	AP	AP	19/06/2024	RE-ISSUED FOR SWC MOD APPROVAL
A	RL	LMc	AP	AP	24/05/2024	ISSUED FOR SWC MOD APPROVAL

Disclaimer and Copyright:
ALL DIMENSIONS TO BE CHECKED ON SITE BY THE CONTRACTOR PRIOR TO CONSTRUCTION.
USE WRITTEN DIMENSIONS ONLY, DO NOT SCALE.
THESE DRAWINGS, PLANS, AND SPECIFICATIONS AND THE COPYRIGHT ARE THE PROPERTY OF ORION CONSULTING ENGINEERS PTY LTD AND MUST NOT BE REPRODUCED OR COPIED WHOLLY OR IN PART WITHOUT THE PERMISSION OF ORION CONSULTING ENGINEERS PTY LTD

Scale:
0 10 20 30 40 50 60 70 80 90 100
SCALE 1:1000 (A1) SCALE 1:2000 (A3)

For: mirvac

By: ORION

ABN:25 604 069 981 PO Box:7936, BAULKHAM HILLS NSW 2153 T:(02) 8660 0035 E:info@theoriongroup.au

Project:
589, 591 & 593 COBBITTY ROAD,
COBBITTY
(TRANCHE 4, STAGE 3a.)
ROAD & DRAINAGE DESIGN

Title:
SITE REGRADING
ALIGNMENT PLAN

Project No.	Set No.	Milestone	Plan	Revision
23-0563	02	MOD	005	B

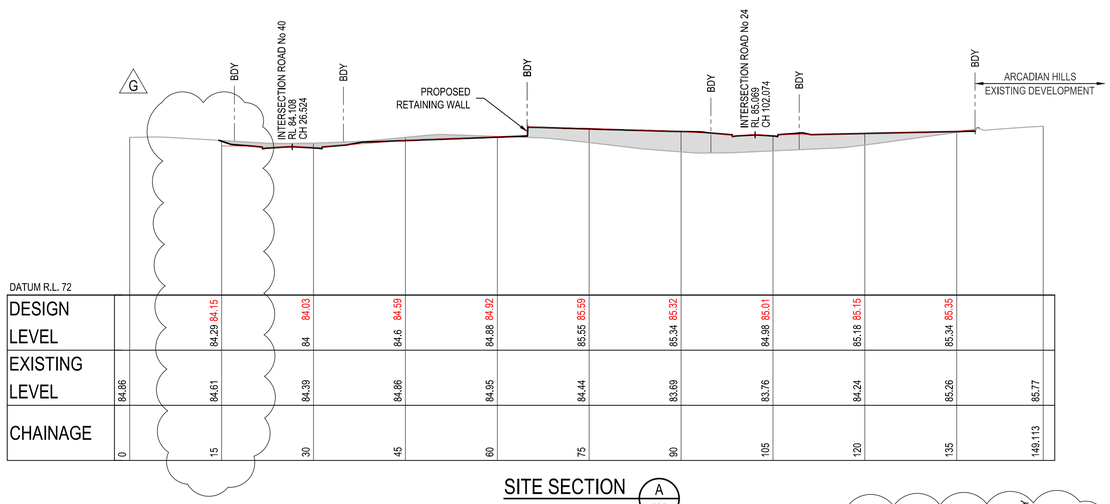

DATUM R.L. 72

DESIGN LEVEL		84.29	84.15	84	84.03	84.6	84.59	84.88	84.92	85.55	85.59	85.34	85.32	84.98	85.01	85.18	85.15	85.34	85.35		
EXISTING LEVEL	84.86	84.61		84.39		84.86		84.95		84.44		83.69		83.76		84.24		85.26		85.77	
CHAINAGE	0	15		30		45		60		75		90		105		120		135		149.113	

SITE SECTION A
SCALE: 1:500 (H)
SCALE: 1:250 (V)
005

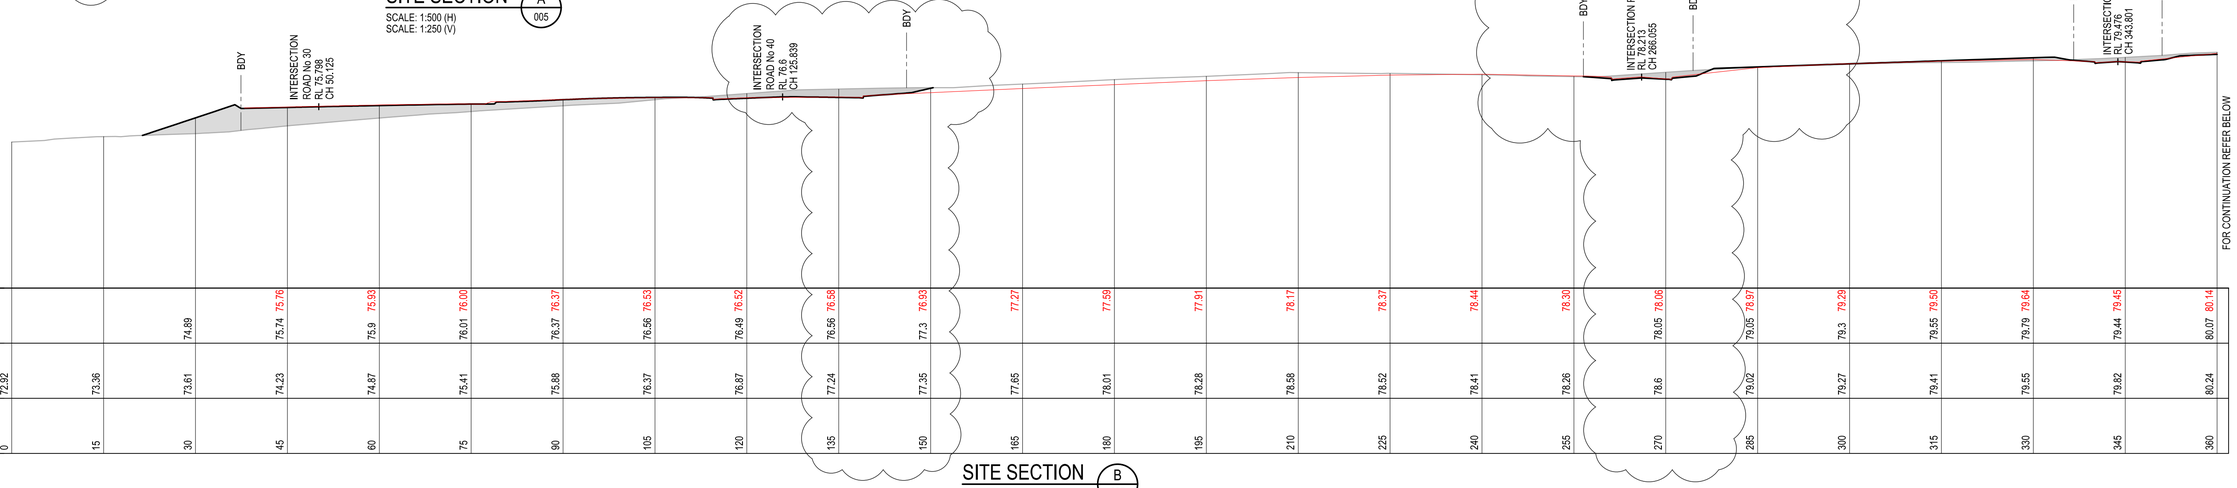

DATUM R.L. 61

| | | | | | | | | | | | |

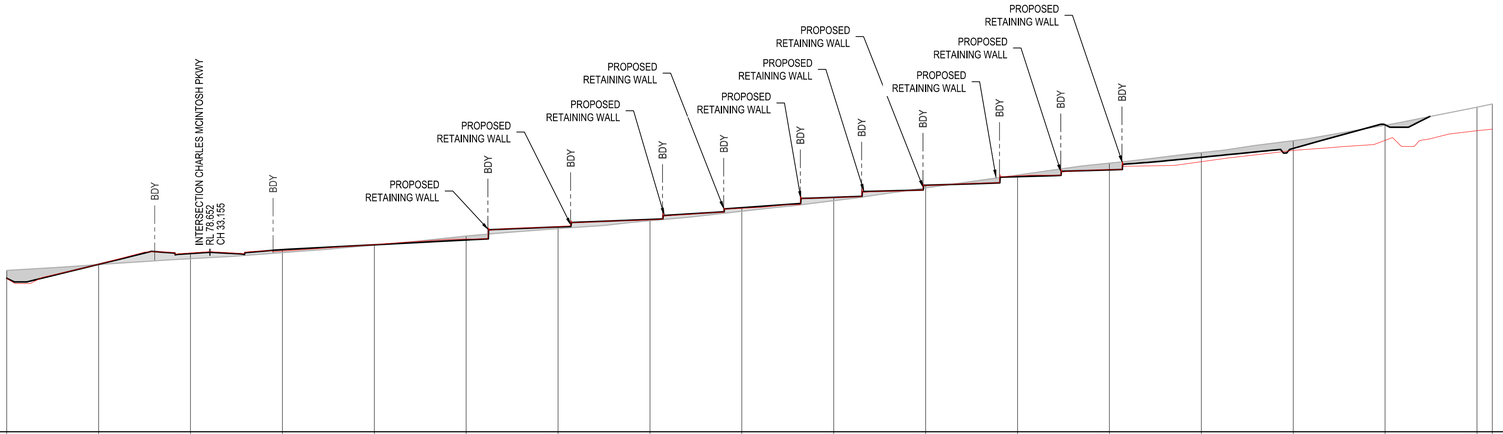
BDY
INTERSECTION CHARLES MCINTOSH PKWY
RL 78.652
CH 33.155
PROPOSED RETAINING WALL

| | | |

LEGEND

	EXISTING	PROPOSED	FUTURE
UTILITY - ELECTRICITY GAS SEWER WATER TELECOMS NBN OPTIC FIBRE	E(C) G(C) S(C) W(C) C(C) NBN OF(C)	E G S W C NBN OF	
CONTOUR LINE & LABEL	19.0	20.0	
LOT NUMBER & BOUNDARY	LOT #	LOT #	LOT #
DENOTES ROOF WATER CONNECTION TO KERB. REFER DRG 203 FOR DETAILS			
DENOTES ROOF WATER CONNECTION TO REAR OF PIT. REFER DRG 203 FOR DETAILS			
APPROXIMATE LIMIT OF WORKS OR STAGE			
ROAD, NUMBER, CONTROL LINE, CHAINAGE & CHAINAGE MARK	CH # ROAD	CH # ROAD	CH # ROAD
COUNCIL STANDARD KERB & GUTTER OR ROLL KERB		K&G RK	
COUNCIL STANDARD KERB ONLY		KO	
COUNCIL STANDARD MOUNTABLE KERB		MK	
INDICATIVE DRIVEWAY LOCATION (NOT CONSTRUCTED AS PART OF CIVIL WORKS)			
COUNCIL STANDARD CONCRETE FOOTPATH & KERB RAMP			
STORMWATER DRAINAGE PIPE AND STRUCTURE			
STORMWATER DRAINAGE PIPE AND STUB			
TEMPORARY STORMWATER DRAINAGE PIPE AND STRUCTURE			
EASEMENT (REFER LEGEND)	(A) (B) (C)	(A) (B) (C)	
SUBSOIL DRAIN & FLUSHING POINT		SS FP	
DIVERSION SWALE			
RETAINING WALL		RW1	
MASONRY WALL			
BATTER			
EXISTING TREE TO BE RETAINED			
EXISTING TREE TO BE REMOVED			
ELECTRICAL SUBSTATION			
TEMPORARY TURNHEAD			
FARM DAM EXTENT			
100 YEAR ARI INTERIM POST DEVELOPMENT FLOOD EXTENTS			
100 YEAR ARI + FREEBOARD EXTENTS			

NORTH

WORKS AS EXECUTED
WORKS AS EXECUTED INFORMATION SHOWN IN RED.
DATE: 07/02/2025
REGISTERED SURVEYOR ID: 8890
ORION GROUP

ROAD 30

ROAD 40

CHARLES MCINTOSH PARKWAY

ROAD 27

FUTURE SCHOOL

LOT 143

LOT 142

PROPOSED SWALE 2. REFER DRAWING 631 FOR PLAN AND DETAILS

PROPOSED LEVEL SPREADER

CAP & SEAL PIPE FOR FUTURE CONNECTION

LIMIT OF ROAD WORKS. PROVIDE 1m BERM AND 1V:6H BATTER.

LIMIT OF ROAD WORKS. PROVIDE 1m BERM AND 1V:6H BATTER TO EXISTING SURFACE.

Lay twin 1350dia stubs out of Pit 2001/10 for future extension. Construct temp headwall and tail out drain at end of stub pipes

TEMPORARY SPECIAL PIT TO DIVERT FLOWS INTO EXISTING FARM DAM. PIT TO BE REMOVED IN FUTURE STAGE TO ALLOW FOR SPLITTER. REFER DRG 544 FOR DETAILS.

375 dia. pipe to be constructed and connected to pit 2001/10 in accordance with approval under DA 2023/461/1 and capped for future connection at edge of road works.

PROPOSED SEWER SHOWN INDICATIVE AND FOR INFORMATION PURPOSES ONLY. REFER TO THE APPROVED PLANS BY THE RELEVANT SERVICE AUTHORITY FOR ACCURATE DETAIL INFORMATION

PEDESTRIAN HANDRAIL

PROPOSED CONCRETE INFILL MEDIAN (TYP)

CONSTRUCT 1.2m WIDE FOOTPATH TO COUNCIL STANDARD

PROVIDE REMOVABLE JERSEY KERB (TYP)

For Structural Details refer to Structural Drawings - plans 652456-S17 and 652456-S18

Temporary tail out drain with 2.5m wide base and 1in 3 batter slopes. Rip Rap scour protection to be provided at end of tail-out

TEMPORARY PIPES TO BE REMOVED IN FUTURE STAGES.

PROVIDE STACKED ROCK HEADWALL WITH RIPRAP SCOUR PROTECTION

Temporary Pit 2001/10 to be built to ultimate design - refer to drawing 23-0579-554-RevA

Note: Pit 2001/10 to be constructed in accordance with approval under DA 2023/461/1

Temporary tail out drain with 1.5m wide base and 1in 3 batter slopes. Rip Rap scour protection to be provided at end of tail-out

Temporary twin 1350dia pipes Not Required

PROPOSED BATTER 1:6 MAX

CONSTRUCT 2.5m WIDE SHARED PATH TO COUNCIL STANDARD

PROPOSED ROUNDABOUT. VEGETATION INFILL TO LANDSCAPE ARCHITECT DETAILS

DISCHARGE CONTROL PIT

PROVIDE 1V:6H BATTER TO EXISTING SURFACE LEVELS

PROVIDE STACKED ROCK HEADWALL WITH RIPRAP SCOUR PROTECTION

LIMIT OF ROAD WORKS

PROVIDE STACKED ROCK HEADWALL WITH RIPRAP SCOUR PROTECTION

FOR CONTINUATION REFER TO SHEET SWC 203

FOR CONTINUATION REFER TO SHEET SWC 201

NOTE:

- FOR ALL INTERNAL WALLS AND BATTERS REFER SHEETS DA 500 FOR LOT BENCHING AND RETAINING WALL DETAILS.

EASEMENTS	
(A)	DENOTES 0.9m WIDE MAINTENANCE EASEMENT
(B)	DENOTES 1.5m WIDE MAINTENANCE EASEMENT

CAMDEN COUNCIL
Approved by the Council of Camden under the provisions of the Environment Planning and Assessment Act 1979
APPROVAL

02/07/2024

SUBDIVISION WORKS CERTIFICATE

DA/DA/2023/215/2 SWC.16.2023.215.2

UTILITIES SHOWN ARE DIAGRAMMATIC ONLY AND MAY NOT INCLUDE ALL SERVICES WITHIN THE LIMIT OF WORKS.

IT IS THE RESPONSIBILITY OF THE CONTRACTOR TO VERIFY, LOCATE AND AVOID DAMAGE TO THEM AS SPECIFIED BY EACH UTILITIES EXCAVATION GUIDE LINES/STANDARDS.

BEFORE YOU DIG www.byda.com.au
Zero Damage - Zero Harm

ISSUED FOR SUBDIVISION WORKS CERTIFICATE

Rev	Drawn	Design	Check	Appd.	Date	Revision Description
H	AP	AP	WA	WA	16/07/2024	SWC MOD FOR ROAD 24 DRAINAGE NETWORK ADJUSTMENTS
B	WP	LMc	AP	AP	19/06/2024	RE-ISSUED FOR SWC MOD APPROVAL
A	RL	LMc	AP	AP	24/05/2024	ISSUED FOR SWC MOD APPROVAL

Disclaimer and Copyright:
ALL DIMENSIONS TO BE CHECKED ON SITE BY THE CONTRACTOR PRIOR TO CONSTRUCTION.
USE WRITTEN DIMENSIONS ONLY, DO NOT SCALE.
THESE DRAWINGS, PLANS, AND SPECIFICATIONS AND THE COPYRIGHT ARE THE PROPERTY OF ORION CONSULTING ENGINEERS PTY LTD AND MUST NOT BE REPRODUCED OR COPIED WHOLLY OR IN PART WITHOUT THE PERMISSION OF ORION CONSULTING ENGINEERS PTY LTD

Scale:
0 2.5 5 7.5 10 12.5 15 17.5 20 22.5 25
SCALE 1:250 (A1) SCALE 1:500 (A3)

For: mirvac

By: ORION
ABN:25 604 069 981 PO Box:7936, BAULKHAM HILLS NSW 2153 T:(02) 8660 0035 E:info@theorigroup.au

Project: 589, 591 & 593 COBBITTY ROAD, COBBITTY (TRANCHE 4, STAGE 3a.) ROAD & DRAINAGE DESIGN

Title: ENGINEERING PLAN SHEET 01

Project No.	Set No.	Milestone	Plan	Revision
23-0563	02	MOD	200	B

FOR CONTINUATION REFER TO SHEET SWC 204

FOR CONTINUATION REFER TO SHEET SWC 200

FOR CONTINUATION REFER TO SHEET SWC 202

NORTH

WORKS AS EXECUTED

WORKS AS EXECUTED INFORMATION SHOWN IN RED.
DATE: 07/02/2025

REGISTERED SURVEYOR ID: 8890
ORION GROUP

CAMDEN COUNCIL
Approved by the Council of Camden under the provisions of the Environment Planning and Assessment Act 1979
APPROVAL

02/07/2024

SUBDIVISION WORKS CERTIFICATE

DA/DA/2023/215/2 SWC.16.2023.215.2

2m WIDE FOOTPATH

PROPOSED SWALE 2. REFER DRAWING 631 FOR PLAN AND DETAILS

REFER TO DWG 700 FOR RETAINING WALL EASEMENTS. NOT SHOWN ON ENGINEERING PLANS

BATTER TO NATURAL 1:6

CONSTRUCT 2.5m WIDE SHARED PATH TO COUNCIL STANDARD

BATTER IN TO LOT VARIES. MAX 1:10 (TYP.)

PROPOSED SUBSTATION LOCATION

INDICATIVE FUTURE LOT LAYOUT TO BE CONFIRMED

PROPOSED SEWER SHOWN INDICATIVE AND FOR INFORMATION PURPOSES ONLY. REFER TO THE APPROVED PLANS BY THE RELEVANT SERVICE AUTHORITY FOR ACCURATE DETAIL INFORMATION

CONSTRUCT 1.2m WIDE FOOTPATH TO COUNCIL STANDARD

PROPOSED EARTH BUND TO DIRECT FLOWS TO PIT

INDICATIVE SEWER. ALIGNMENT TO BE CONFIRMED

ROAD 40A

ROAD 24

ROAD 27

ROAD 29

ROAD 28

CHARLES MCINTOSH PARKWAY

PROPOSED SPLITTER PIT REFER DRG 547 FOR DETAILS

PROVIDE STACKED ROCK HEADWALL WITH RIPRAP SCOUR PROTECTION

HUMEGARD HG45 GPT (4.9MX2.9MX2.1M)
TOTAL POLLUTANT CAPACITY (18.3M³)

PROVIDE REMOVABLE JERSEY KERB ACROSS HOLD LINE OF ROAD No 29

PROPOSED LEVEL SPREADER

LIMIT OF ROAD WORKS. PROVIDE 1m BERM AND 1V:6H BATTER

PROPOSED SWALE 4. REFER DRAWING 633 FOR PLAN AND DETAILS

CONSTRUCT 1.2m WIDE FOOTPATH TO COUNCIL STANDARD

PROVIDE REMOVABLE JERSEY KERB ACROSS HOLD LINE OF ROAD No 28

LIMIT OF ROAD WORKS. PROVIDE 1m BERM AND 1V:6H BATTER.

NOTE:

- REFER DWG 200 FOR LEGEND.

ISSUED FOR SUBDIVISION WORKS CERTIFICATE

Rev	Drawn	Design	Check	Appd.	Date	Revision Description
B	WP	LMc	AP	AP	19/06/2024	RE-ISSUED FOR SWC MOD APPROVAL
A	RL	LMc	AP	AP	24/05/2024	ISSUED FOR SWC MOD APPROVAL

Disclaimer and Copyright:
ALL DIMENSIONS TO BE CHECKED ON SITE BY THE CONTRACTOR PRIOR TO CONSTRUCTION.
USE WRITTEN DIMENSIONS ONLY, DO NOT SCALE.
THESE DRAWINGS, PLANS, AND SPECIFICATIONS AND THE COPYRIGHT ARE THE PROPERTY OF ORION CONSULTING ENGINEERS PTY LTD AND MUST NOT BE REPRODUCED OR COPIED WHOLLY OR IN PART WITHOUT THE PERMISSION OF ORION CONSULTING ENGINEERS PTY LTD

Scale:
0 2.5 5 7.5 10 12.5 15 17.5 20 22.5 25
SCALE 1:250 (A1) SCALE 1:500 (A3)

For: mirvac

By: ORION

ABN:25 604 069 981 PO Box:7936, BAULKHAM HILLS NSW 2153 T:(02) 8660 0035 E:info@theorionngroup.au

Project:
589, 591 & 593 COBBITTY ROAD, COBBITTY
(TRANCHE 4, STAGE 3a.)
ROAD & DRAINAGE DESIGN

Title:
ENGINEERING PLAN
SHEET 02

Project No.	Set No.	Milestone	Plan	Revision
23-0563	02	MOD	201	B

FOR CONTINUATION REFER TO SHEET SWC 204

FOR CONTINUATION REFER TO SHEET SWC 201

NORTH

WORKS AS EXECUTED
WORKS AS EXECUTED INFORMATION SHOWN IN RED.
DATE: 07/02/2025
REGISTERED SURVEYOR ID: 8890
ORION GROUP

CAMDEN COUNCIL
Approved by the Council of Camden under the provisions of the Environment Planning and Assessment Act 1979
APPROVAL
22/03/2024
SUBDIVISION WORKS CERTIFICATE
DA/2023/215/1 SWC.16.2023.215.1

KITTY LANE

HOOK STREET

WISTERIA RISE

CHARLES MCINTOSH PARKWAY

EXISTING RETAINING WALL

LIMIT OF ROAD WORKS. MAKE SMOOTH CONNECTION WITH EXISTING PAVEMENT

EXISTING SEWER. CAUTION

EXISTING DRAINAGE PIT AND PIPE TO REMAIN. PROPOSED SURFACE TO MAKE SMOOTH CONNECTION WITH EXISTING PITS (TYP.)

LP 3101
DP 1231304

BREAK INTO EXISTING PIT, CONNECT NEW PIPE AND MAKE GOOD. REINSTATE KERB AND PAVEMENT AS REQUIRED TO EXISTING CONDITION

STAIRS TO BE INSTALLED FOR PEDESTRIAN ACCESS TO CHARLES MCINTOSH PARKWAY FOR EACH FUTURE TERRACE LOT. EXACT LOCATION, TYPES AND STYLE TO BE CONFIRMED BY OTHERS

TRANSITION CROSS FALL FROM -3% AT CH 1020 TO -2% AT CL HOOK STREET

TRANSITION CROSS FALL FROM -2% AT CL HOOK STREET TO -2% AT CH 1135

LOT 596
DP 1231304

LIMIT OF ROAD WORKS. MAKE SMOOTH CONNECTION WITH EXISTING PAVEMENT

EXISTING PIT TO BE REMOVED AND PIPE EXTENDED TO NEW PIT LOCATION. MAKE GOOD CONNECTION WITH EXISTING PIPE

EXISTING SERVICES TO BE ADJUSTED

CONSTRUCT 2.5m WIDE SHARED PATH TO COUNCIL STANDARD

MAKE SMOOTH CONNECTION WITH EXISTING DRAINAGE PIPE

LIMIT OF ROAD WORKS. MAKE SMOOTH CONNECTION WITH EXISTING PAVEMENT.

TRANSITION CROSS FALL FROM -2% AT CH 1135 TO MATCH EXISTING CROSS FALL AT CH 1167.75

PROPOSED SWALE 4. REFER DRAWING 633 FOR PLAN AND DETAILS

PROVIDE REMOVABLE JERSEY KERB ACROSS HOLD LINE OF HOOK STREET

LIMIT OF ROAD WORKS. PROVIDE 1m BERM AND 1V:6H BATTER.

CONSTRUCT 1.2m WIDE FOOTPATH TO COUNCIL STANDARD

PROVIDE REMOVABLE JERSEY KERB ACROSS HOLD LINE OF WISTERIA RISE

LIMIT OF ROAD WORKS. PROVIDE 1m BERM AND 1V:6H BATTER.

PT146

NOTE:
- REFER DWG 200 FOR LEGEND.

ISSUED FOR SUBDIVISION WORKS CERTIFICATE

Rev	Drawn	Design	Check	Appd.	Date	Revision Description
G	RL/WP	LMc	AP	AP	20/03/2024	ISSUED FOR SUBDIVISION WORKS CERTIFICATE
F	WP	LMc	AP	AP	07/03/2024	ISSUED FOR SUBDIVISION WORKS CERTIFICATE
E	WP	LMc	AP	AP	27/02/2024	ISSUED FOR SUBDIVISION WORKS CERTIFICATE
D	RL	LMc	AP	AP	07/02/2024	ISSUED FOR SUBDIVISION WORKS CERTIFICATE
C	RL	LMc	AP	AP	23/01/2024	ISSUED FOR SUBDIVISION WORKS CERTIFICATE
B	RL	LMc	MP	AP	01/12/2023	ISSUED FOR SUBDIVISION WORKS CERTIFICATE
A	RL	LM/YK	MP	AP	27/11/2023	ISSUED FOR SUBDIVISION WORKS CERTIFICATE

Disclaimer and Copyright:
ALL DIMENSIONS TO BE CHECKED ON SITE BY THE CONTRACTOR PRIOR TO CONSTRUCTION.
USE WRITTEN DIMENSIONS ONLY, DO NOT SCALE.
THESE DRAWINGS, PLANS, AND SPECIFICATIONS AND THE COPYRIGHT ARE THE PROPERTY OF ORION CONSULTING ENGINEERS PTY LTD AND MUST NOT BE REPRODUCED OR COPIED WHOLLY OR IN PART WITHOUT THE PERMISSION OF ORION CONSULTING ENGINEERS PTY LTD

Scale:
0 2.5 5 7.5 10 12.5 15 17.5 20 22.5 25
SCALE 1:250 (A1) SCALE 1:500 (A3)

For: mirvac

By: ORION
ABN:25 604 069 981 PO Box:7936, BAULKHAM HILLS NSW 2153 T:(02) 8660 0035 E:info@theoriongroup.au

Project:
589, 591 & 593 COBBITTY ROAD, COBBITTY
(TRANCHE 4, STAGE 3a.)
ROAD & DRAINAGE DESIGN

Title:
ENGINEERING PLAN
SHEET 03

Project No.	Set No.	Milestone	Plan	Revision
23-0563	01	SWC	202	G

FOR CONTINUATION REFER TO SHEET SWC 200

NORTH

WORKS AS EXECUTED
WORKS AS EXECUTED INFORMATION SHOWN IN RED.
DATE: 07/02/2025
REGISTERED SURVEYOR ID: 8890
ORION GROUP

CAMDEN COUNCIL
Approved by the Council of Camden under the provisions of the Environment Planning and Assessment Act 1979
APPROVAL
02/07/2024
SUBDIVISION WORKS CERTIFICATE
DA/DA/2023/215/2 SWC.16.2023.215.2

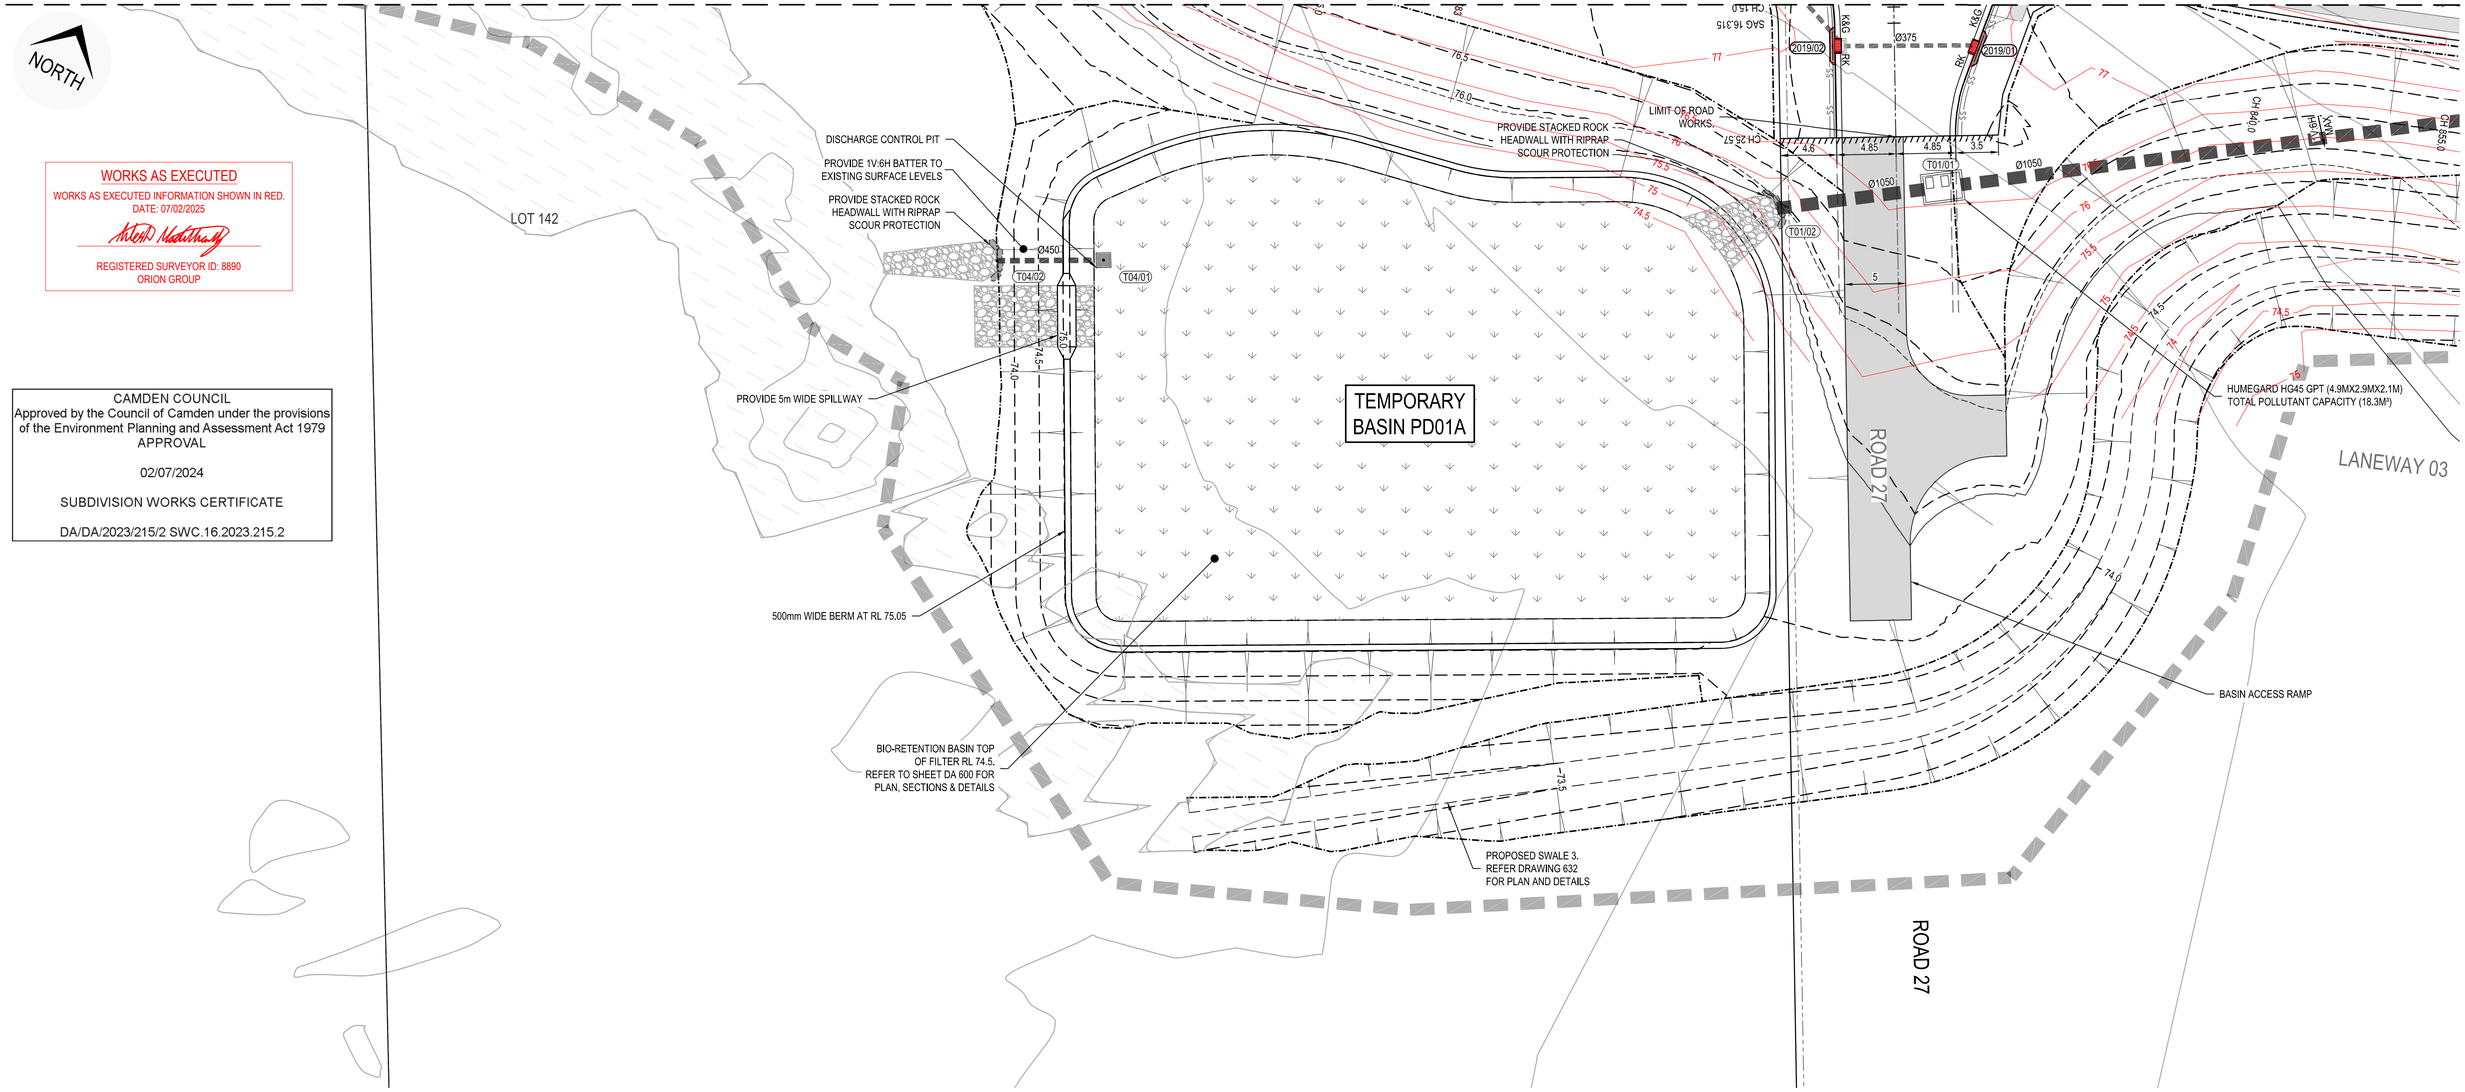

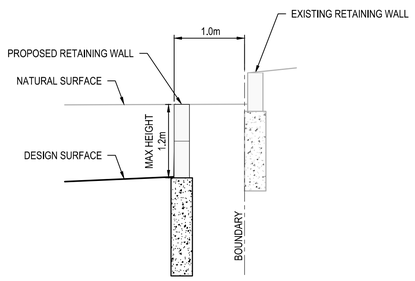

TYPICAL RETAINING WALL SECTION
SCALE 1:50

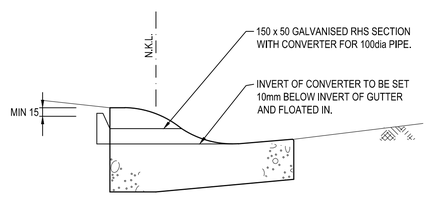

TYPICAL ROOF WATER CONNECTION WITH KERB (RK)
SCALE 1:10

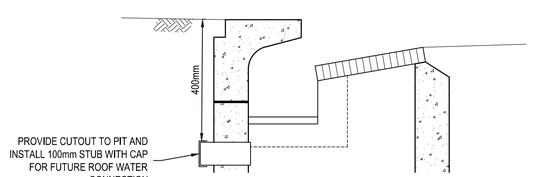

ROOF WATER CONNECTION TO REAR OF PIT
SCALE 1:10

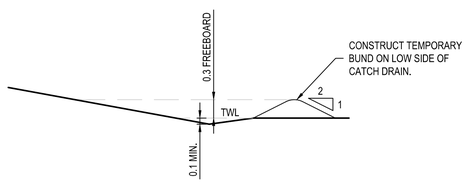

TYPICAL CATCH DRAIN SECTION
NTS

NOTE:
- REFER DWG 200 FOR LEGEND.

ISSUED FOR SUBDIVISION WORKS CERTIFICATE

Rev	Drawn	Design	Check	Appd.	Date	Revision Description
B	WP	LMc	AP	AP	19/06/2024	RE-ISSUED FOR SWC MOD APPROVAL
A	RL	LMc	AP	AP	24/05/2024	ISSUED FOR SWC MOD APPROVAL

Disclaimer and Copyright:
ALL DIMENSIONS TO BE CHECKED ON SITE BY THE CONTRACTOR PRIOR TO CONSTRUCTION.
USE WRITTEN DIMENSIONS ONLY. DO NOT SCALE.
THESE DRAWINGS, PLANS, AND SPECIFICATIONS AND THE COPYRIGHT ARE THE PROPERTY OF ORION CONSULTING ENGINEERS PTY LTD AND MUST NOT BE REPRODUCED OR COPIED WHOLLY OR IN PART WITHOUT THE PERMISSION OF ORION CONSULTING ENGINEERS PTY LTD

Scale:
0 0.1 0.2 0.3 0.4 0.5 0.6 0.7 0.8 0.9 1.0 — SCALE 1:10 (A1) — SCALE 1:20 (A3)
0 0.5 1.0 1.5 2.0 2.5 3.0 3.5 4.0 4.5 5.0 — SCALE 1:50 (A1) — SCALE 1:100 (A3)
0 2.5 5 7.5 10 12.5 15 17.5 20 22.5 25 — SCALE 1:250 (A1) — SCALE 1:500 (A3)

For: mirvac

By: ORION
ABN:25 604 069 981 PO Box:7936, BAULKHAM HILLS NSW 2153 T:(02) 8660 0035 E:info@theoriongroup.au

Project: 589, 591 & 593 COBBITTY ROAD, COBBITTY (TRANCHE 4, STAGE 3a.) ROAD & DRAINAGE DESIGN

Title: ENGINEERING PLAN SHEET 04

Project No.	Set No.	Milestone	Plan	Revision
23-0563	02	MOD	203	B

NORTH

WORKS AS EXECUTED

WORKS AS EXECUTED INFORMATION SHOWN IN RED.
DATE: 07/02/2025

REGISTERED SURVEYOR ID: 8890
ORION GROUP

CAMDEN COUNCIL
Approved by the Council of Camden
under the provisions
of the Environment Planning and
Assessment Act 1979
APPROVAL

03/09/2024

SUBDIVISION WORKS
CERTIFICATE

DA/2023/215/2
SWC.16.2023.215.3

PROPOSED SWALE 1.
REFER DRAWING 630
FOR PLAN AND DETAILS

PROPOSED LEVEL SPREADER

ROAD 24

1V:6H MAX

500mm WIDE CATCH DRAIN AT BOTTOM OF BATTER TO DIVERT FLOWS AWAY FROM LOT

PROVIDE TEMPORARY TURNING HEAD WITH REFLECTORISED GUIDE POSTS AT 1.5m C/C

PROVIDE REMOVABLE JERSEY KERB (TYP)

LIMIT OF ROAD WORKS.

CAP & SEAL PIPE FOR FUTURE CONNECTION

CONSTRUCT TEMPORARY PIT IN THE CATCH DRAIN TO PICK UP UPSTREAM FLOWS

TEMPORARY PIT
E: 288737.241
N: 6234713.795
SURFACE RL: 85.04
IL: 83.365

CONSTRUCT BLIND PIT

PROVIDE TEMPORARY TURNING BAY WITH REFLECTORISED GUIDE POSTS AT 1.5m C/C

TEMPORARY PIT AND PIPE. PROVIDE STACKED ROCK HEADWALL AND RIPRAP SCOUR PROTECTION TO DAYLIGHT

TEMPORARY HEADWALL
E: 288732.778
N: 6234702.242
IL:83.25

Provide DN300 stub and headwall inlet. Pit grate to be class D. Bollards to be relocated around pit 2AC/07

Future RL 87.37
Future pit IL 86.63

2AC/07
900x900
Cover RL = 87.23
ILu = 86.255
ILd = 85.73
Depth = 1.50m
X = 288808.761
Y = 6234736.726

2005/05
GGP EKI
Cover RL = 87.461
ILu = 85.67
ILd = 85.62
Depth = 1.861m
X = 288818.139
Y = 6234746.579

NEW PIT 03
900x900
Cover RL = 87.99
ILu = 85.78
ILd = 85.73
Depth = 2.26m
X = 288822.638
Y = 6234751.245

DN375 RRJ2 @ 7.75%

DN375 RRJ2 @ 1%

DN150 uPVC @ 1%

NEW PIT 02
600x900
Cover RL = 87.13
IL = 86.05
Depth = 1.08m
X = 288846.387
Y = 6234761.035

CONSTRUCT 1.2m WIDE FOOTPATH TO COUNCIL STANDARD

CATCH DRAIN

DN375 RRJ2 @ 5.51%

Revised catch drain alignment. Batter to be max 1:4

2014/01
Future GGP EKI - Temp GSIP
Cover RL = 86.917
ILu = 85.41
ILd = 85.36
Depth = 1.557m
X = 288815.029
Y = 6234737.139

Pit 2014/01 to have class D grate

DN375 RRJ2 @ 5.65%

NEW PIT 01
600x600
Cover RL = 86.89
IL = 86.14
Depth = 0.75m
X = 288849.559
Y = 6234753.003

DN375 RRJ2 @ 7.32%

Pit IL 82.92

PROVIDE 1V:6H BATTER TO EXISTING SURFACE LEVELS

CONSTRUCT 2.5m WIDE FOOTPATH TO COUNCIL STANDARD

ROAD 40A

ROAD 24

EXISTING RETAINING WALL

PROPOSED RETAINING WALL

ARCADIAN HILLS
EXISTING DEVELOPMENT

FUTURE
SCHOOL

NOTE:
- REFER DWG 200 FOR LEGEND.

FOR CONTINUATION REFER TO SHEET SWC 201

ISSUED FOR SUBDIVISION WORKS CERTIFICATE

G	AP	AP	WA	WA	16/07/2024	SWC MOD FOR ROAD 24 DRAINAGE NETWORK ADJUSTMENTS
F	WP	LMc	AP	AP	07/03/2024	ISSUED FOR SUBDIVISION WORKS CERTIFICATE
E	WP	LMc	AP	AP	27/02/2024	ISSUED FOR SUBDIVISION WORKS CERTIFICATE
D	RL	LMc	AP	AP	07/02/2024	ISSUED FOR SUBDIVISION WORKS CERTIFICATE
C	RL	LMc	AP	AP	23/01/2024	ISSUED FOR SUBDIVISION WORKS CERTIFICATE
B	RL	LMc	MP	AP	01/12/2023	ISSUED FOR SUBDIVISION WORKS CERTIFICATE
A	RL	LM/YK	MP	AP	27/11/2023	ISSUED FOR SUBDIVISION WORKS CERTIFICATE
Rev	Drawn	Design	Check	Appd.	Date	Revision Description

Disclaimer and Copyright:
ALL DIMENSIONS TO BE CHECKED ON SITE BY THE CONTRACTOR PRIOR TO CONSTRUCTION.
USE WRITTEN DIMENSIONS ONLY, DO NOT SCALE.
THESE DRAWINGS, PLANS, AND SPECIFICATIONS AND THE COPYRIGHT ARE THE PROPERTY OF ORION CONSULTING ENGINEERS PTY LTD AND MUST NOT BE REPRODUCED OR COPIED WHOLLY OR IN PART WITHOUT THE PERMISSION OF ORION CONSULTING ENGINEERS PTY LTD

Scale:
0 2.5 5 7.5 10 12.5 15 17.5 20 22.5 25
SCALE 1:250 (A1) SCALE 1:500 (A3)

For: mirvac

By: ORION
ABN:25 604 069 981 PO Box:7936, BAULKHAM HILLS NSW 2153 T:(02) 8660 0035 E:info@theoriongroup.au

JAS-ANZ SUSTAINABLE PROJECTS WWW.JAS-ANZ.ORG/REGISTER

Project:
589, 591 & 593 COBBITTY ROAD,
COBBITTY
(TRANCHE 4, STAGE 3a.)
ROAD & DRAINAGE DESIGN

Title:
ENGINEERING PLAN
SHEET 05

Project No.	Set No.	Milestone	Plan	Revision
23-0563	01	SWC	204	G

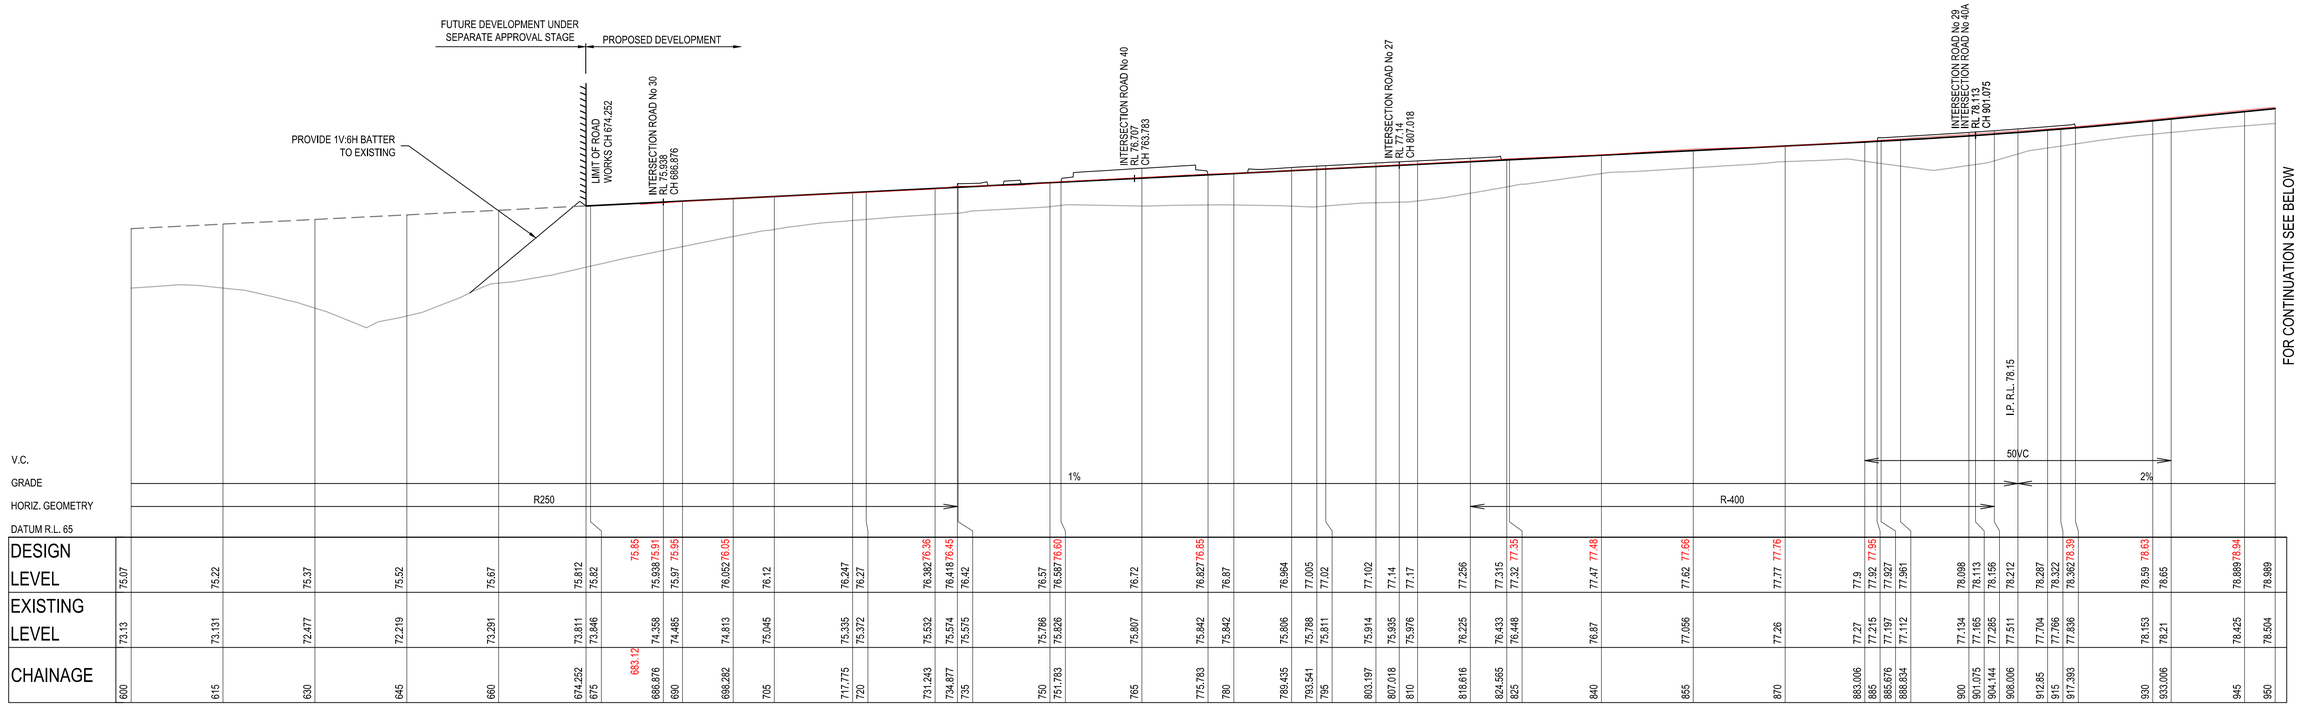

LONGITUDINAL SECTION - CHARLES MCINTOSH PKWY

SCALE 1:500 (H)
SCALE 1:100 (V)

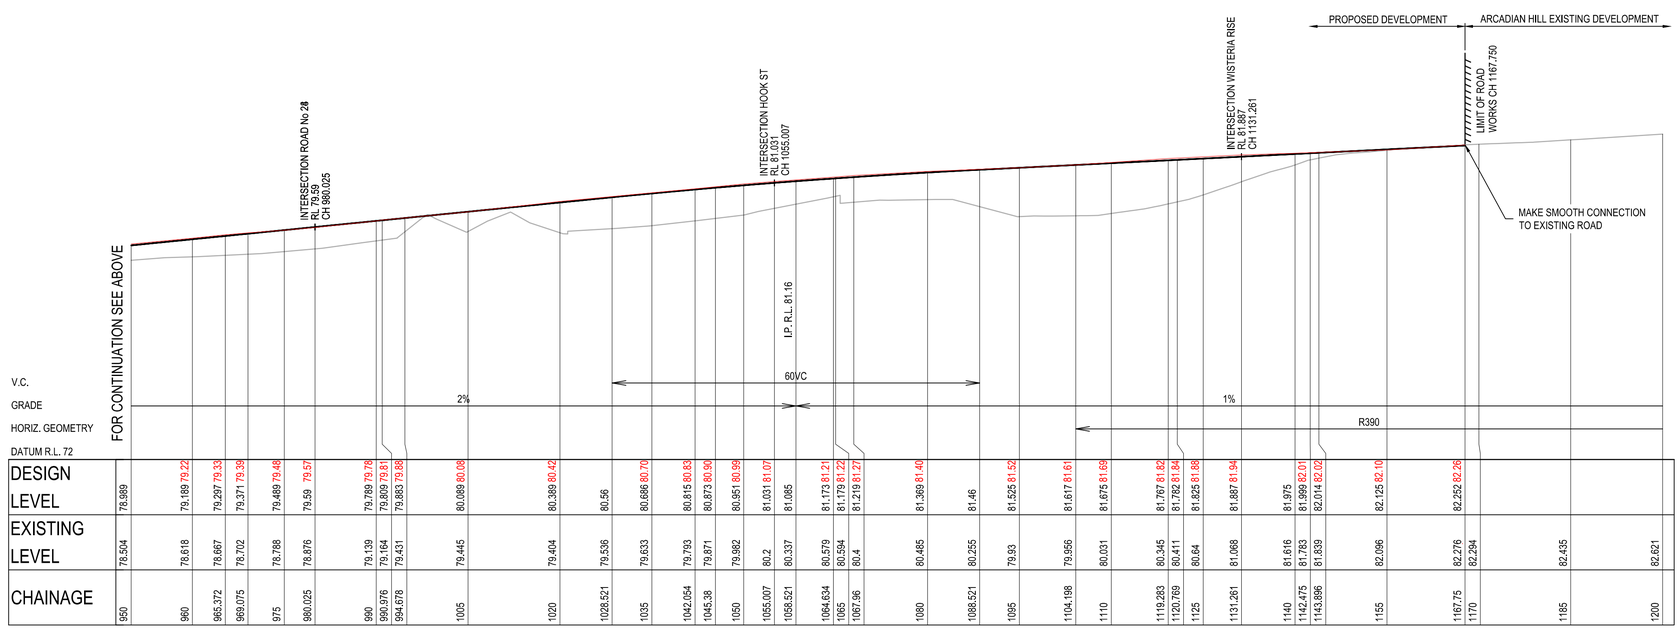

LONGITUDINAL SECTION - CHARLES MCINTOSH PKWY

SCALE 1:500 (H)
SCALE 1:100 (V)

CAMDEN COUNCIL
Approved by the Council of Camden under the provisions of the Environment Planning and Assessment Act 1979
APPROVAL

22/03/2024

SUBDIVISION WORKS CERTIFICATE

DA/2023/215/1 SWC.16.2023.215.1

WORKS AS EXECUTED
WORKS AS EXECUTED INFORMATION SHOWN IN RED.
DATE: 07/02/2025
REGISTERED SURVEYOR ID: 8890
ORION GROUP

LEGEND
- DESIGN SURFACE
- EXISTING SURFACE
- FUTURE SURFACE

ISSUED FOR **SUBDIVISION WORKS CERTIFICATE**

Rev	Drawn	Design	Check	Appd.	Date	Revision Description
F	WP	LMc	AP	AP	07/03/2024	ISSUED FOR SUBDIVISION WORKS CERTIFICATE
E	WP	LMc	AP	AP	27/02/2024	ISSUED FOR SUBDIVISION WORKS CERTIFICATE
D	RL	LMc	AP	AP	07/02/2024	ISSUED FOR SUBDIVISION WORKS CERTIFICATE
C	RL	LMc	AP	AP	23/01/2024	ISSUED FOR SUBDIVISION WORKS CERTIFICATE
B	RL	LMc	MP	AP	01/12/2023	ISSUED FOR SUBDIVISION WORKS CERTIFICATE
A	RL	LM/YK	MP	AP	27/11/2023	ISSUED FOR SUBDIVISION WORKS CERTIFICATE

Disclaimer and Copyright:
ALL DIMENSIONS TO BE CHECKED ON SITE BY THE CONTRACTOR PRIOR TO CONSTRUCTION.
USE WRITTEN DIMENSIONS ONLY, DO NOT SCALE.
THESE DRAWINGS, PLANS, AND SPECIFICATIONS AND THE COPYRIGHT ARE THE PROPERTY OF ORION CONSULTING ENGINEERS PTY LTD AND MUST NOT BE REPRODUCED OR COPIED WHOLLY OR IN PART WITHOUT THE PERMISSION OF ORION CONSULTING ENGINEERS PTY LTD

Scale:
0 1 2 3 4 5 6 7 8 9 10
SCALE 1:100 (A1) SCALE 1:200 (A3)
0 5 10 15 20 25 30 35 40 45 50
SCALE 1:500 (A1) SCALE 1:1000 (A3)

For: mirvac

By: ORION
ABN:25 604 069 981 PO Box:7936, BAULKHAM HILLS NSW 2153 T:(02) 8660 0035 E:info@theoriongroup.au

Project: 589, 591 & 593 COBBITTY ROAD, COBBITTY (TRANCHE 4, STAGE 3a.) ROAD & DRAINAGE DESIGN

Title: ROAD LONGITUDINAL SECTIONS SHEET 01

Project No.	Set No.	Milestone	Plan	Revision
23-0563	01	SWC	301	F

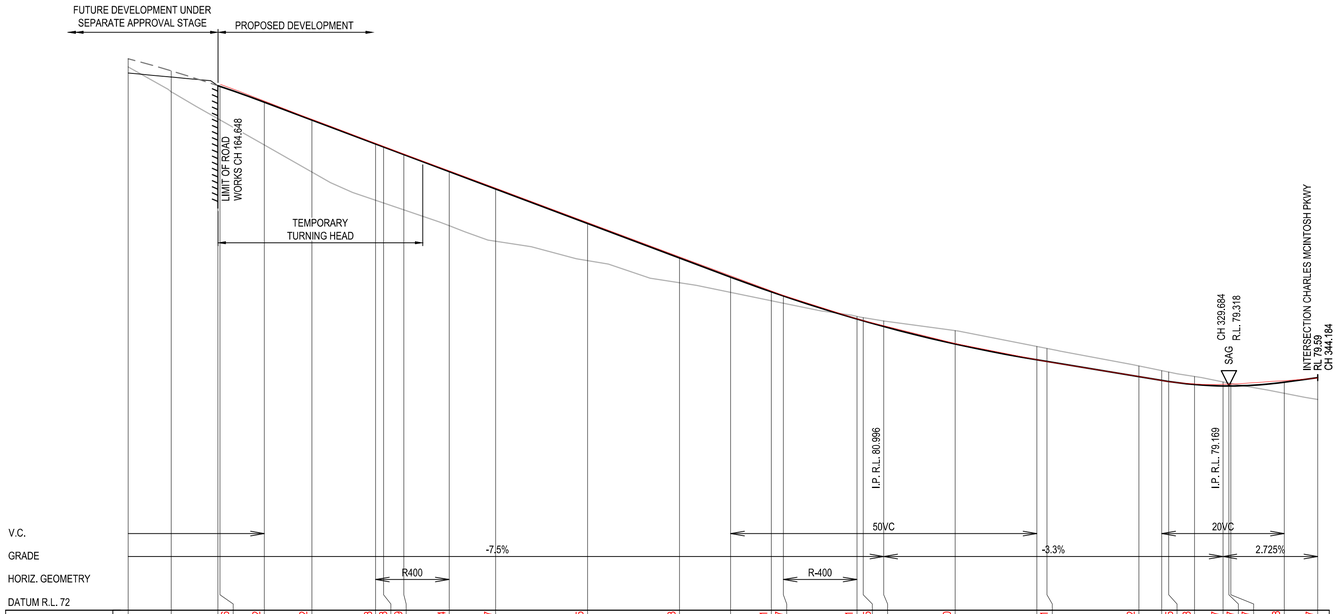
FUTURE DEVELOPMENT UNDER SEPARATE APPROVAL STAGE
PROPOSED DEVELOPMENT
LIMIT OF ROAD WORKS CH 164.648
TEMPORARY TURNING HEAD
I.P. R.L. 80.986
I.P. R.L. 79.169
SAG R.L. 79.318 CH 329.684
INTERSECTION CHARLES MCINTOSH PKWY RL 79.59 CH 344.184
V.C.
GRADE
HORIZ. GEOMETRY
DATUM R.L. 72
-7.5%
-3.3%
2.725%
50VC
20VC
R400
R-400

| | | |

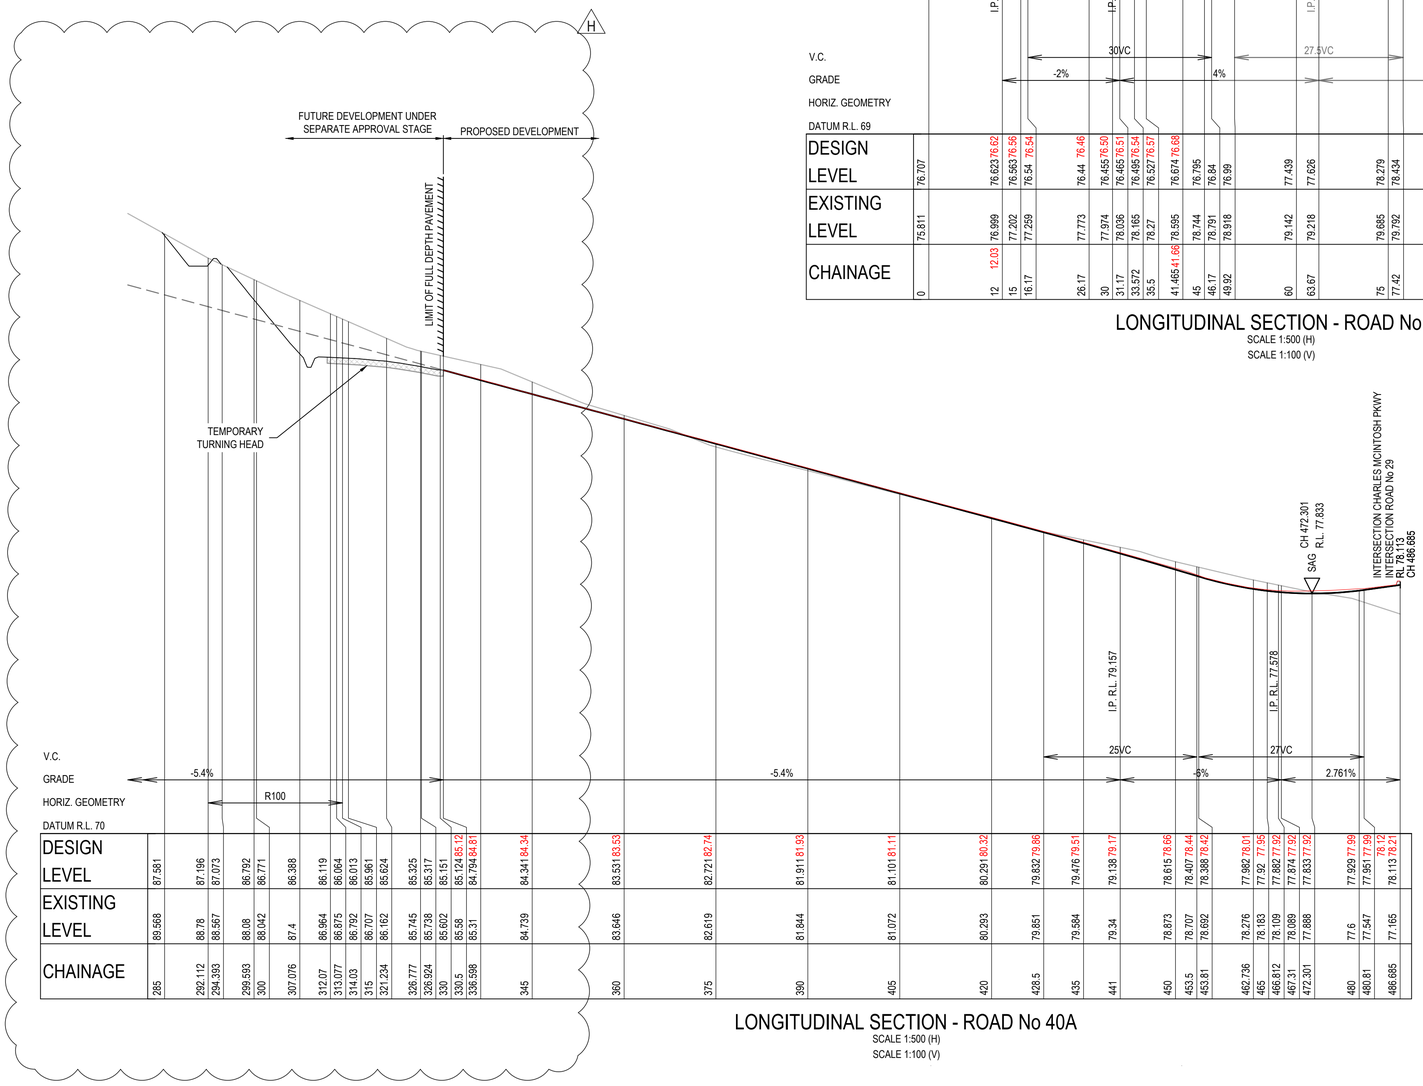
H
FUTURE DEVELOPMENT UNDER SEPARATE APPROVAL STAGE
PROPOSED DEVELOPMENT
LIMIT OF FULL DEPTH PAVEMENT
TEMPORARY TURNING HEAD
INTERSECTION CHARLES MCINTOSH PKWY INTERSECTION ROAD No 29 RL 78.113 CH 486.685
CH 472.301 RL. 77.833 SAG
I.P. R.L. 79.157
I.P. R.L. 77.578
V.C.
GRADE
HORIZ. GEOMETRY
DATUM R.L. 70
-5.4%
-5.4%
-6%
2.761%
25VC
27VC
R100

| | | |

G

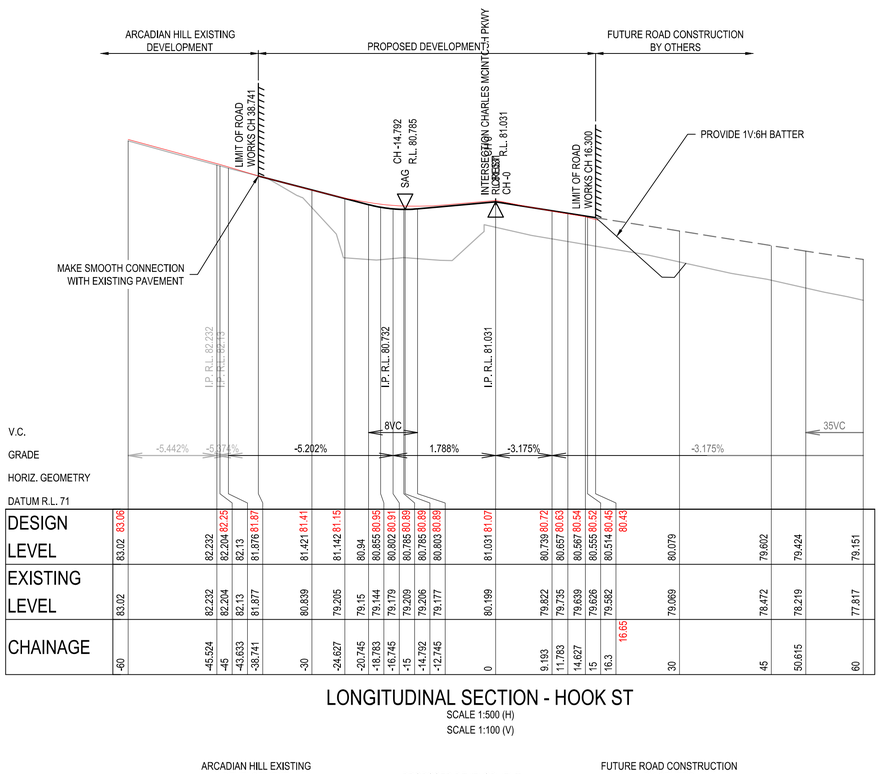
ARCADIAN HILL EXISTING DEVELOPMENT
PROPOSED DEVELOPMENT
FUTURE ROAD CONSTRUCTION BY OTHERS
INTERSECTION CHARLES MCINTOSH PKWY
SAG CH -14.792 R.L. 80.785
INTERSECTION CHARLES MCINTOSH PKWY CREST R.L. 81.031 CH -9
LIMIT OF ROAD WORKS CH 16.300
PROVIDE 1V:6H BATTER
MAKE SMOOTH CONNECTION WITH EXISTING PAVEMENT
I.P. R.L. 82.232
I.P. R.L. 82.497
I.P. R.L. 82.303
I.P. R.L. 80.732
I.P. R.L. 81.031
V.C.
GRADE
HORIZ. GEOMETRY
DATUM R.L. 71
8VC
35VC
-5.442%
-5.202%
1.788%
-3.175%
-3.175%

| | | |

CHARLES MCINTOSH PARKWAY

WORKS AS EXECUTED
WORKS AS EXECUTED INFORMATION SHOWN IN RED.
DATE: 07/02/2025
REGISTERED SURVEYOR ID: 8890
ORION GROUP

LEGEND	
EXISTING SURFACE	
DESIGN SURFACE	

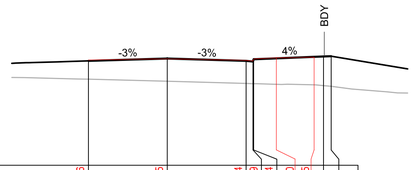

DATUM R.L. 69

| | | |

CHARLES MCINTOSH PARKWAY

WORKS AS EXECUTED
WORKS AS EXECUTED INFORMATION SHOWN IN RED.
DATE: 07/02/2025
REGISTERED SURVEYOR ID: 8890
ORION GROUP

LEGEND	
EXISTING SURFACE	
DESIGN SURFACE	

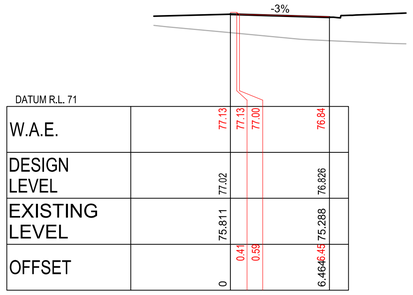

CH 795

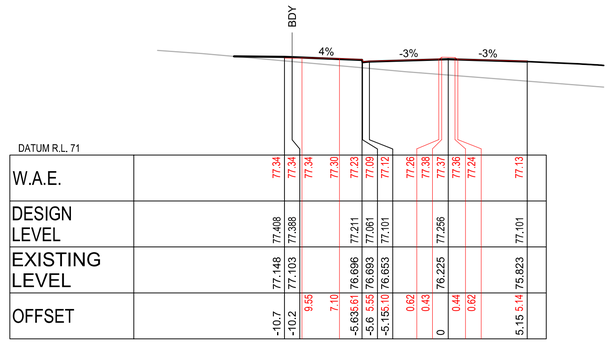

CH 818.616

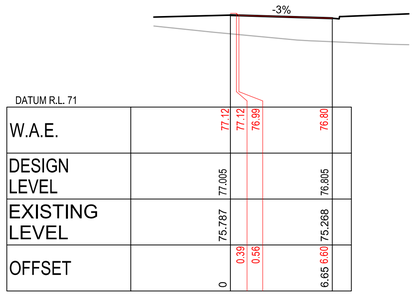

CH 793.51

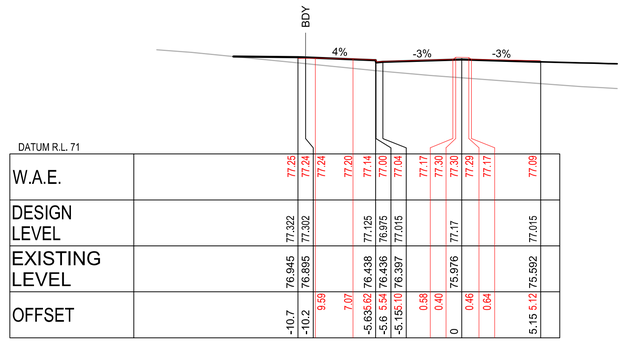

CH 810

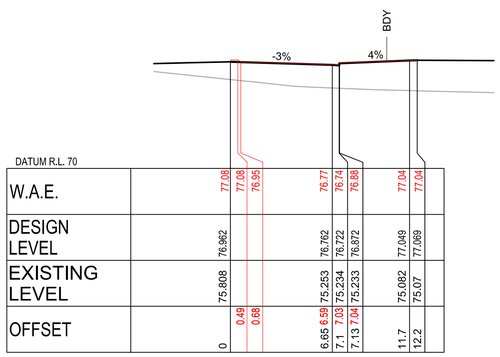

CH 789.239

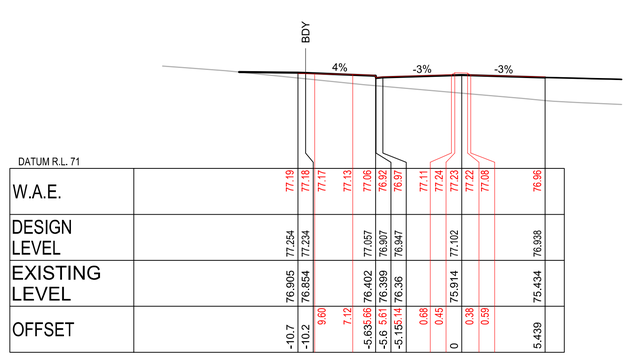

CH 803.197

CAMDEN COUNCIL
Approved by the Council of Camden under the provisions of the Environment Planning and Assessment Act 1979
APPROVAL

02/07/2024

SUBDIVISION WORKS CERTIFICATE

DA/DA/2023/215/2 SWC.16.2023.215.2

ISSUED FOR SUBDIVISION WORKS CERTIFICATE

Rev	Drawn	Design	Check	Appd.	Date	Revision Description
B	WP	LMc	AP	AP	19/06/2024	RE-ISSUED FOR SWC MOD APPROVAL
A	RL	LMc	AP	AP	24/05/2024	ISSUED FOR SWC MOD APPROVAL

Disclaimer and Copyright:
ALL DIMENSIONS TO BE CHECKED ON SITE BY THE CONTRACTOR PRIOR TO CONSTRUCTION.
USE WRITTEN DIMENSIONS ONLY. DO NOT SCALE.
THESE DRAWINGS, PLANS, AND SPECIFICATIONS AND THE COPYRIGHT ARE THE PROPERTY OF ORION CONSULTING ENGINEERS PTY LTD AND MUST NOT BE REPRODUCED OR COPIED WHOLLY OR IN PART WITHOUT THE PERMISSION OF ORION CONSULTING ENGINEERS PTY LTD

Scale:
0 2.0 4.0 6.0 8.0 10.0 12.0 14.0 16.0 18.0 20.0
SCALE 1:200 (A1) SCALE 1:400 (A3)

For: mirvac

By: ORION
ABN:25 604 069 981 PO Box:7936, BAULKHAM HILLS NSW 2153 T:(02) 8660 0035 E:info@theoriongroup.au

Project: 589, 591 & 593 COBBITTY ROAD, COBBITTY (TRANCHE 4, STAGE 3a.) ROAD & DRAINAGE DESIGN

Title: ROAD CROSS SECTIONS

Project No.	Set No.	Milestone	Plan	Revision
23-0563	02	MOD	310	B

CHARLES MCINTOSH PARKWAY

WORKS AS EXECUTED
WORKS AS EXECUTED INFORMATION SHOWN IN RED.
DATE: 07/02/2025
REGISTERED SURVEYOR ID: 8890
ORION GROUP

LEGEND	
EXISTING SURFACE	
DESIGN SURFACE	

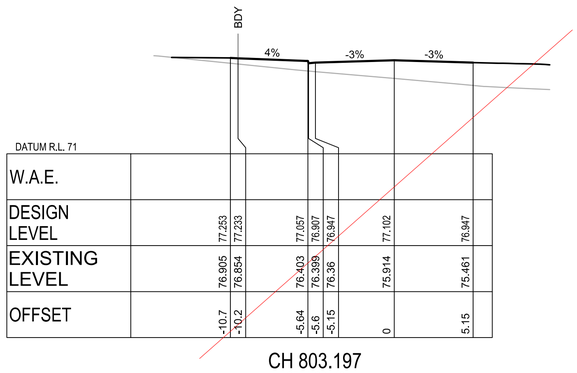

DATUM R.L. 71

| | | |

CHARLES MCINTOSH PARKWAY

WORKS AS EXECUTED

WORKS AS EXECUTED INFORMATION SHOWN IN RED.
DATE: 07/02/2025

REGISTERED SURVEYOR ID: 8890
ORION GROUP

LEGEND

EXISTING SURFACE	
DESIGN SURFACE	

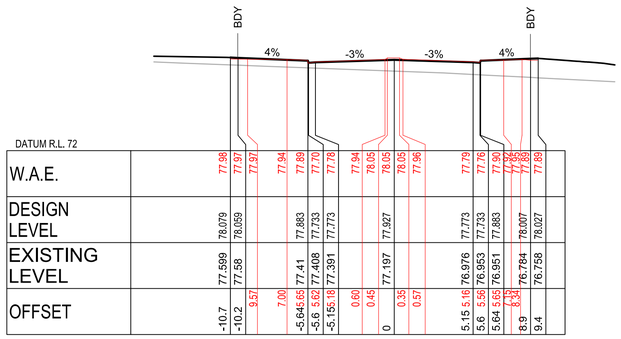

| DATUM R.L. 72 | | |

CHARLES MCINTOSH PARKWAY

WORKS AS EXECUTED
WORKS AS EXECUTED INFORMATION SHOWN IN RED.
DATE: 07/02/2025
REGISTERED SURVEYOR ID: 8890
ORION GROUP

LEGEND

EXISTING SURFACE	
DESIGN SURFACE	

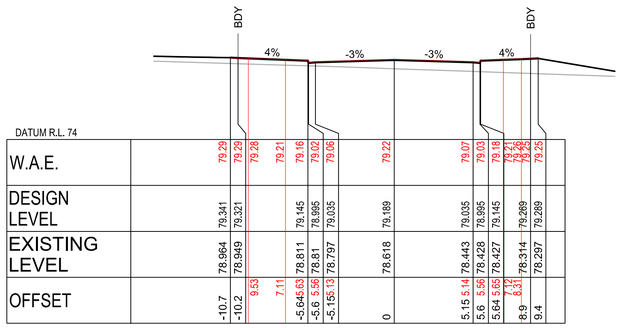

DATUM R.L. 74

| | | |

CHARLES MCINTOSH PARKWAY

WORKS AS EXECUTED
WORKS AS EXECUTED INFORMATION SHOWN IN RED.
DATE: 07/02/2025
REGISTERED SURVEYOR ID: 8890
ORION GROUP

LEGEND	
EXISTING SURFACE	
DESIGN SURFACE	

G

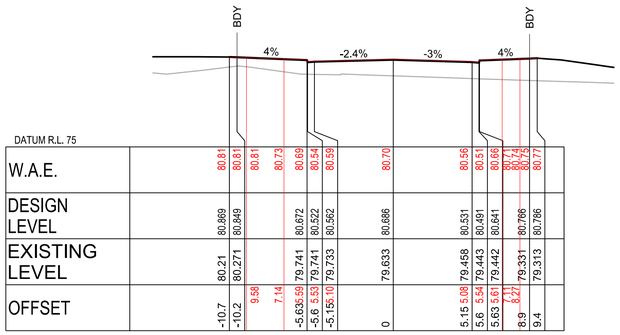

DATUM R.L. 75

| | | |

CHARLES MCINTOSH PARKWAY

WORKS AS EXECUTED
WORKS AS EXECUTED INFORMATION SHOWN IN RED.
DATE: 07/02/2025
REGISTERED SURVEYOR ID: 8890
ORION GROUP

LEGEND	
EXISTING SURFACE	
DESIGN SURFACE	

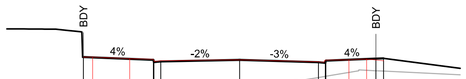

DATUM R.L. 75

| | | |

CHARLES MCINTOSH PARKWAY

WORKS AS EXECUTED
WORKS AS EXECUTED INFORMATION SHOWN IN RED.
DATE: 07/02/2025
REGISTERED SURVEYOR ID: 8890
ORION GROUP

LEGEND	
EXISTING SURFACE	
DESIGN SURFACE	

G

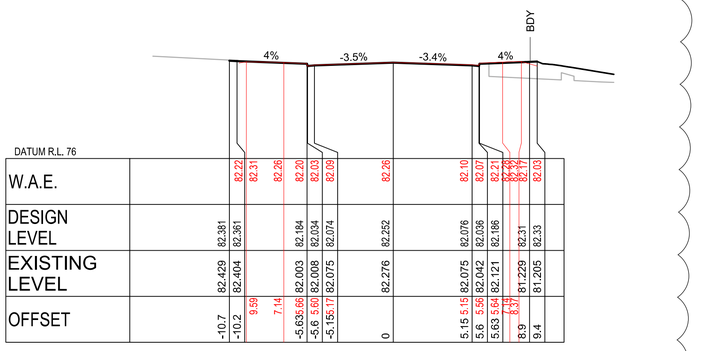

DATUM R.L. 76																					
W.A.E.			82.22	82.31		82.26	82.20	82.03	82.09	82.26		82.10	82.07	82.21	82.08	82.17	82.31	82.03			
DESIGN LEVEL	82.361	82.361				82.184	82.034	82.074		82.252		82.076	82.036	82.186			82.31	82.33			
EXISTING LEVEL	82.429	82.404				82.003	82.008	82.075		82.276		82.075	82.042	82.121			81.229	81.205			
OFFSET	-10.7	-10.2	9.59		7.14	-5.63	-5.6	-5.15	5.17	0		5.15	5.6	5.63	5.64	7.14	8.9	9.4			

CH 1167.75

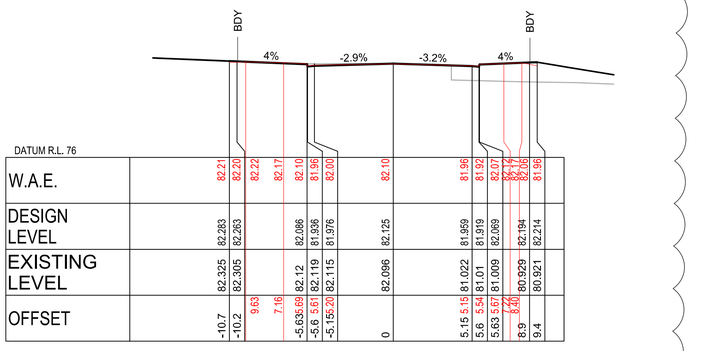

DATUM R.L. 76																					
W.A.E.		82.21	82.20		82.22		82.17	82.10	81.96	82.00	82.10		81.96	81.92	82.07	82.16	82.05	81.96			
DESIGN LEVEL	82.283	82.263				82.086	81.936	81.976		82.125		81.959	81.919	82.069			82.194	82.214			
EXISTING LEVEL	82.325	82.305				82.12	82.119	82.115		82.096		81.022	81.01	81.009			80.929	80.921			
OFFSET	-10.7	-10.2	9.63		7.16	-5.63	-5.6	-5.15	5.20	0		5.15	5.6	5.63	5.67	7.22	8.9	9.4			

CH 1155

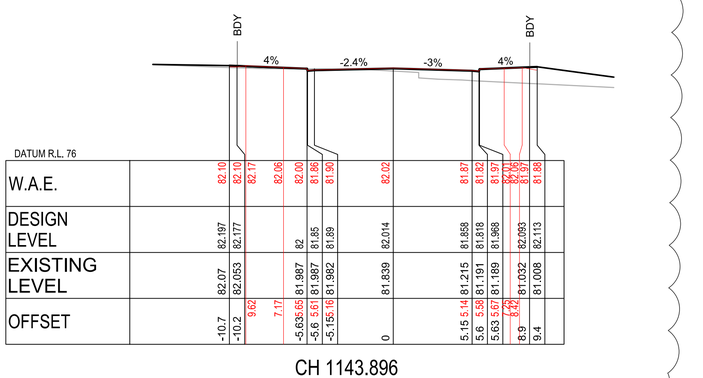

DATUM R.L. 76																					
W.A.E.		82.10	82.10		82.17		82.06	82.00	81.86	81.90	82.02		81.87	81.82	81.97	82.01	81.95	81.88			
DESIGN LEVEL	82.197	82.177				82	81.85	81.89		82.014		81.858	81.818	81.968			82.093	82.113			
EXISTING LEVEL	82.07	82.053				81.987	81.987	81.982		81.839		81.215	81.191	81.189			81.032	81.008			
OFFSET	-10.7	-10.2	9.62		7.17	-5.63	-5.6	-5.15	5.16	0		5.15	5.6	5.63	5.67	7.22	8.9	9.4			

CH 1143.896

CAMDEN COUNCIL
Approved by the Council of Camden under the provisions of the Environment Planning and Assessment Act 1979
APPROVAL

22/03/2024

SUBDIVISION WORKS CERTIFICATE

DA/2023/215/1 SWC.16.2023.215.1

ISSUED FOR SUBDIVISION WORKS CERTIFICATE

Rev	Drawn	Design	Check	Appd.	Date	Revision Description
G	RL/WP	LMc	AP	AP	20/03/2024	ISSUED FOR SUBDIVISION WORKS CERTIFICATE
F	WP	LMc	AP	AP	07/03/2024	ISSUED FOR SUBDIVISION WORKS CERTIFICATE
E	WP	LMc	AP	AP	27/02/2024	ISSUED FOR SUBDIVISION WORKS CERTIFICATE
D	RL	LMc	AP	AP	07/02/2024	ISSUED FOR SUBDIVISION WORKS CERTIFICATE
C	RL	LMc	AP	AP	23/01/2024	ISSUED FOR SUBDIVISION WORKS CERTIFICATE
B	RL	LMc	MP	AP	01/12/2023	ISSUED FOR SUBDIVISION WORKS CERTIFICATE
A	RL	LM/YK	MP	AP	27/11/2023	ISSUED FOR SUBDIVISION WORKS CERTIFICATE

Disclaimer and Copyright:
ALL DIMENSIONS TO BE CHECKED ON SITE BY THE CONTRACTOR PRIOR TO CONSTRUCTION.
USE WRITTEN DIMENSIONS ONLY, DO NOT SCALE.
THESE DRAWINGS, PLANS, AND SPECIFICATIONS AND THE COPYRIGHT ARE THE PROPERTY OF ORION CONSULTING ENGINEERS PTY LTD AND MUST NOT BE REPRODUCED OR COPIED WHOLLY OR IN PART WITHOUT THE PERMISSION OF ORION CONSULTING ENGINEERS PTY LTD

Scale:
0 2.0 4.0 6.0 8.0 10.0 12.0 14.0 16.0 18.0 20.0
SCALE 1:200 (A1) SCALE 1:400 (A3)

For: mirvac

By: ORION

ABN:25 604 069 981 PO Box:7936, BAULKHAM HILLS NSW 2153 T:(02) 8660 0035 E:info@theoriongroup.au

Project:
589, 591 & 593 COBBITTY ROAD, COBBITTY
(TRANCHE 4, STAGE 3a.)
ROAD & DRAINAGE DESIGN

Title:
ROAD CROSS SECTIONS
SHEET 07

Project No.	Set No.	Milestone	Plan	Revision
23-0563	01	SWC	316	G

ISSUED FOR SUBDIVISION WORKS CERTIFICATE

ROAD 24

WORKS AS EXECUTED
WORKS AS EXECUTED INFORMATION SHOWN IN RED.
DATE: 07/02/2025
REGISTERED SURVEYOR ID: 8890
ORION GROUP

LEGEND	
EXISTING SURFACE	
DESIGN SURFACE	

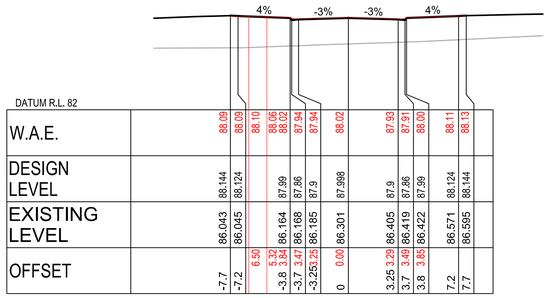

DATUM R.L. 82																							
W.A.E.								88.09	88.09		88.10		88.06	88.02	87.94	87.94	88.02			87.93	87.91	88.00		88.11	88.13	
DESIGN LEVEL								88.144	88.124					87.99	87.86	87.9	87.998			87.9	87.86	87.99		88.124	88.144	
EXISTING LEVEL								86.043	86.045					86.164	86.168	86.185	86.301			86.405	86.419	86.422		86.571	86.595	
OFFSET								-7.7	-7.2		6.50		5.32	3.84	-3.7	-3.25	0.00			3.25	3.49	3.85		7.2	7.7	

CH 180

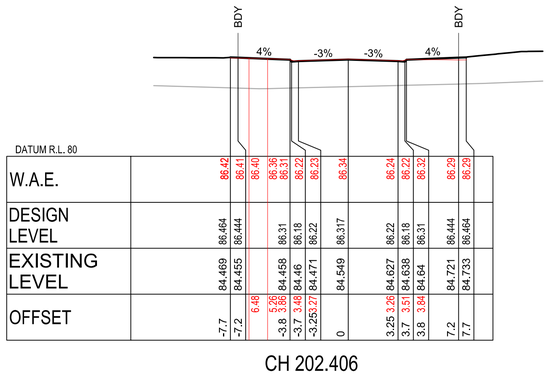

DATUM R.L. 80																							
W.A.E.								86.42	86.41		86.40		86.36	86.31	86.22	86.23	86.34			86.24	86.22	86.32		86.29	86.29	
DESIGN LEVEL								86.464	86.444					86.31	86.18	86.22	86.317			86.22	86.18	86.31		86.444	86.464	
EXISTING LEVEL								84.469	84.455					84.458	84.46	84.471	84.549			84.627	84.638	84.64		84.721	84.733	
OFFSET								-7.7	-7.2		6.48		5.06	3.66	-3.7	-3.27	0			3.25	3.7	3.84		7.2	7.7	

CH 202.406

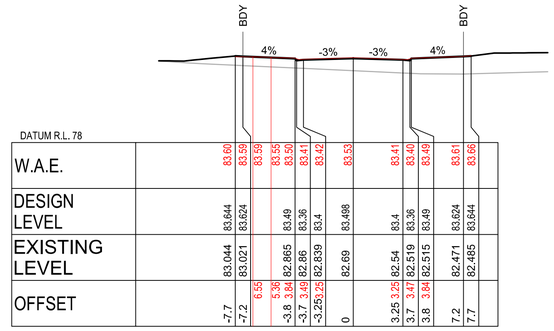

DATUM R.L. 78																							
W.A.E.								83.60	83.59		83.59		83.55	83.50	83.41	83.42	83.53			83.41	83.40	83.49		83.61	83.66	
DESIGN LEVEL								83.644	83.624					83.49	83.36	83.4	83.498			83.4	83.36	83.49		83.624	83.644	
EXISTING LEVEL								83.044	83.021					82.865	82.86	82.839	82.69			82.54	82.519	82.515		82.471	82.485	
OFFSET								-7.7	-7.2		6.55		5.38	3.84	-3.8	-3.7	-3.25	0		3.25	3.7	3.8		7.2	7.7	

CH 240

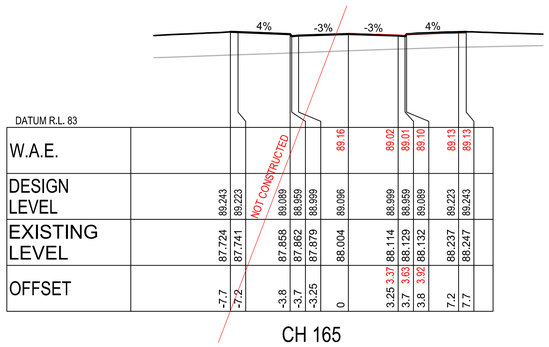

DATUM R.L. 83																							
W.A.E.																89.16				89.02	89.01	89.10		89.13	89.13	
DESIGN LEVEL								89.243	89.223					89.089	88.959	88.999	89.096			88.999	88.959	89.089		89.223	89.243	
EXISTING LEVEL								87.724	87.741					87.858	87.862	87.879	88.004			88.114	88.129	88.132		88.237	88.247	
OFFSET								-7.7	-7.2					-3.8	-3.7	-3.25	0			3.25	3.7	3.8		7.2	7.7	

CH 165

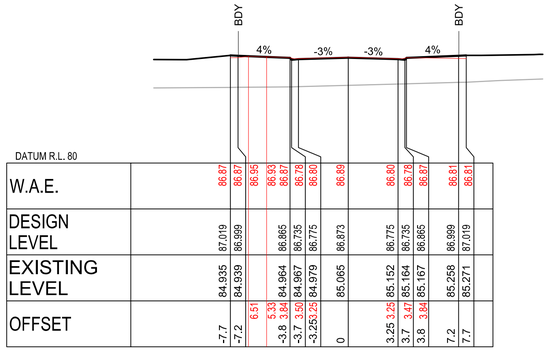

DATUM R.L. 80																							
W.A.E.								86.87	86.87		86.95		86.93	86.87	86.78	86.80	86.89			86.80	86.78	86.87		86.81	86.81	
DESIGN LEVEL								87.019	86.999					86.865	86.735	86.775	86.873			86.775	86.735	86.865		86.999	87.019	
EXISTING LEVEL								84.935	84.939					84.964	84.967	84.979	85.065			85.152	85.164	85.167		85.258	85.271	
OFFSET								-7.7	-7.2		6.51		5.33	3.84	-3.8	-3.7	-3.25	0		3.25	3.7	3.84		7.2	7.7	

CH 195

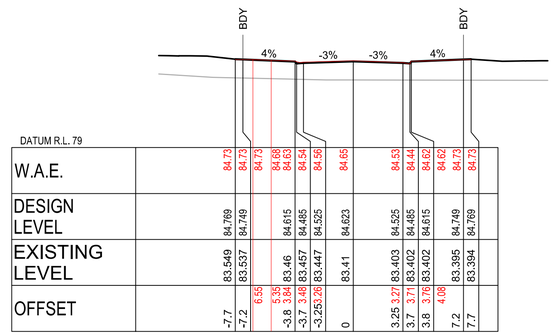

DATUM R.L. 79																							
W.A.E.								84.73	84.73		84.73		84.68	84.63	84.54	84.56	84.65			84.53	84.44	84.62		84.73	84.73	
DESIGN LEVEL								84.769	84.749					84.615	84.465	84.525	84.623			84.525	84.485	84.615		84.749	84.769	
EXISTING LEVEL								83.549	83.537					83.46	83.457	83.447	83.41			83.403	83.402	83.402		83.395	83.394	
OFFSET								-7.7	-7.2		6.55		5.38	3.84	-3.8	-3.7	-3.25	0		3.25	3.7	3.8		7.2	7.7	

CH 225

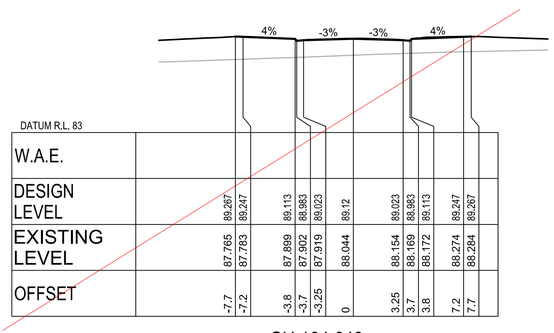

DATUM R.L. 83																							
W.A.E.																							
DESIGN LEVEL								89.267	89.247					89.113	88.983	89.023	89.12			89.023	88.983	89.113		89.247	89.267	
EXISTING LEVEL								87.765	87.783					87.899	87.902	87.919	88.044			88.154	88.169	88.172		88.274	88.284	

CH 164.648
NOT CONSTRUCTED

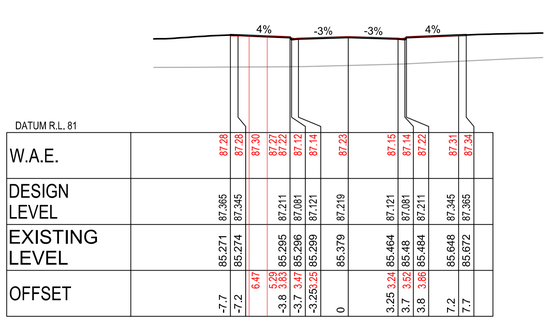

DATUM R.L. 81																							
W.A.E.								87.28	87.28		87.30		87.27	87.22	87.12	87.14	87.23			87.15	87.14	87.22		87.31	87.34	
DESIGN LEVEL								87.365	87.345					87.211	87.081	87.121	87.219			87.121	87.081	87.211		87.345	87.365	
EXISTING LEVEL								85.271	85.274					85.295	85.296	85.299	85.379			85.464	85.48	85.484		85.648	85.672	
OFFSET								-7.7	-7.2		6.47		5.09	3.63	-3.8	-3.7	-3.25	0		3.25	3.52	3.86		7.2	7.7	

CH 190.386

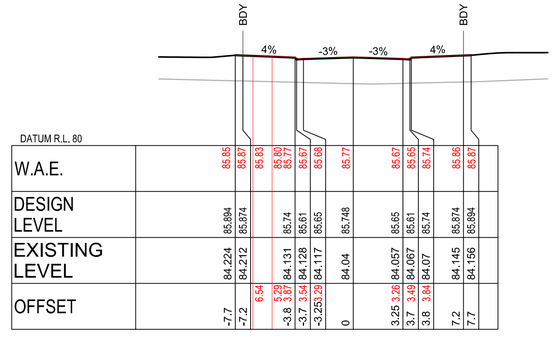

DATUM R.L. 80																							
W.A.E.								85.85	85.87		85.83		85.80	85.77	85.67	85.68	85.77			85.67	85.65	85.74		85.86	85.87	
DESIGN LEVEL								85.894	85.874					85.74	85.61	85.65	85.748			85.65	85.61	85.74		85.874	85.894	
EXISTING LEVEL								84.224	84.212					84.131	84.128	84.117	84.04			84.057	84.067	84.07		84.145	84.156	
OFFSET								-7.7	-7.2		6.54		5.29	3.77	-3.8	-3.7	-3.25	0		3.25	3.49	3.84		7.2	7.7	

CH 210

G

CAMDEN COUNCIL
Approved by the Council of Camden under the provisions of the Environment Planning and Assessment Act 1979
APPROVAL

22/03/2024

SUBDIVISION WORKS CERTIFICATE

DA/2023/215/1 SWC.16.2023.215.1

ISSUED FOR SUBDIVISION WORKS CERTIFICATE

Rev	Drawn	Design	Check	Appd.	Date	Revision Description
G	RL/WP	LMc	AP	AP	20/03/2024	ISSUED FOR SUBDIVISION WORKS CERTIFICATE
F	WP	LMc	AP	AP	07/03/2024	ISSUED FOR SUBDIVISION WORKS CERTIFICATE
E	WP	LMc	AP	AP	27/02/2024	ISSUED FOR SUBDIVISION WORKS CERTIFICATE
D	RL	LMc	AP	AP	07/02/2024	ISSUED FOR SUBDIVISION WORKS CERTIFICATE
C	RL	LMc	AP	AP	23/01/2024	ISSUED FOR SUBDIVISION WORKS CERTIFICATE
B	RL	LMc	MP	AP	01/12/2023	ISSUED FOR SUBDIVISION WORKS CERTIFICATE
A	RL	LM/YK	MP	AP	27/11/2023	ISSUED FOR SUBDIVISION WORKS CERTIFICATE

Disclaimer and Copyright:
ALL DIMENSIONS TO BE CHECKED ON SITE BY THE CONTRACTOR PRIOR TO CONSTRUCTION.
USE WRITTEN DIMENSIONS ONLY, DO NOT SCALE.
THESE DRAWINGS, PLANS, AND SPECIFICATIONS AND THE COPYRIGHT ARE THE PROPERTY OF ORION CONSULTING ENGINEERS PTY LTD AND MUST NOT BE REPRODUCED OR COPIED WHOLLY OR IN PART WITHOUT THE PERMISSION OF ORION CONSULTING ENGINEERS PTY LTD

Scale:
0 2.0 4.0 6.0 8.0 10.0 12.0 14.0 16.0 18.0 20.0
SCALE 1:200 (A1) SCALE 1:400 (A3)

For: mirvac

By: ORION
ABN:25 604 069 981 PO Box:7936, BAULKHAM HILLS NSW 2153 T:(02) 8660 0035 E:info@theoriongroup.au

Project:
589, 591 & 593 COBBITTY ROAD, COBBITTY
(TRANCHE 4, STAGE 3a.)
ROAD & DRAINAGE DESIGN

Title:
ROAD CROSS SECTIONS
SHEET 08

Project No.	Set No.	Milestone	Plan	Revision
23-0563	01	SWC	317	G

ROAD 24

WORKS AS EXECUTED
WORKS AS EXECUTED INFORMATION SHOWN IN RED.
DATE: 07/02/2025
REGISTERED SURVEYOR ID: 8890
ORION GROUP

LEGEND	
EXISTING SURFACE	
DESIGN SURFACE	

G

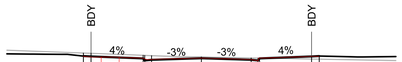

DATUM R.L. 77

| | | |

ROAD 28

WORKS AS EXECUTED

WORKS AS EXECUTED INFORMATION SHOWN IN RED.
DATE: 07/02/2025

REGISTERED SURVEYOR ID: 8890
ORION GROUP

LEGEND	
EXISTING SURFACE	
DESIGN SURFACE	

CAMDEN COUNCIL
Approved by the Council of Camden under the provisions of the Environment Planning and Assessment Act 1979
APPROVAL

22/03/2024

SUBDIVISION WORKS CERTIFICATE

DA/2023/215/1 SWC.16.2023.215.1

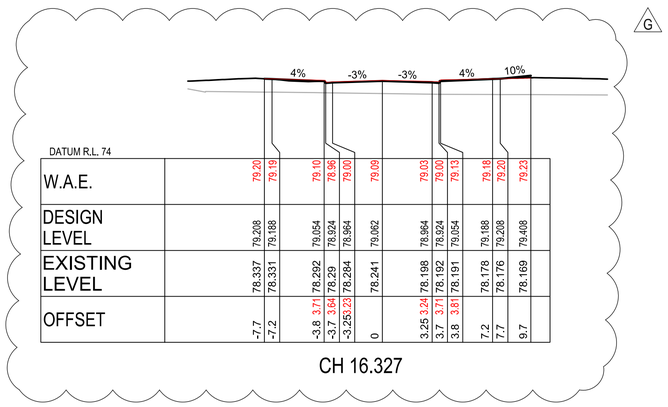

ISSUED FOR SUBDIVISION WORKS CERTIFICATE

Rev	Drawn	Design	Check	Appd.	Date	Revision Description
G	RL/WP	LMc	AP	AP	20/03/2024	ISSUED FOR SUBDIVISION WORKS CERTIFICATE
F	WP	LMc	AP	AP	07/03/2024	ISSUED FOR SUBDIVISION WORKS CERTIFICATE
E	WP	LMc	AP	AP	27/02/2024	ISSUED FOR SUBDIVISION WORKS CERTIFICATE
D	RL	LMc	AP	AP	07/02/2024	ISSUED FOR SUBDIVISION WORKS CERTIFICATE
C	RL	LMc	AP	AP	23/01/2024	ISSUED FOR SUBDIVISION WORKS CERTIFICATE
B	RL	LMc	MP	AP	01/12/2023	ISSUED FOR SUBDIVISION WORKS CERTIFICATE
A	RL	LM/YK	MP	AP	27/11/2023	ISSUED FOR SUBDIVISION WORKS CERTIFICATE

Disclaimer and Copyright:
ALL DIMENSIONS TO BE CHECKED ON SITE BY THE CONTRACTOR PRIOR TO CONSTRUCTION.
USE WRITTEN DIMENSIONS ONLY, DO NOT SCALE.
THESE DRAWINGS, PLANS, AND SPECIFICATIONS AND THE COPYRIGHT ARE THE PROPERTY OF ORION CONSULTING ENGINEERS PTY LTD AND MUST NOT BE REPRODUCED OR COPIED WHOLLY OR IN PART WITHOUT THE PERMISSION OF ORION CONSULTING ENGINEERS PTY LTD

Scale:
0 2.0 4.0 6.0 8.0 10.0 12.0 14.0 16.0 18.0 20.0
SCALE 1:200 (A1) SCALE 1:400 (A3)

For: mirvac

By: ORION

ABN:25 604 069 981 PO Box:7936, BAULKHAM HILLS NSW 2153 T:(02) 8660 0035 E:info@theoriongroup.au

Project:
589, 591 & 593 COBBITTY ROAD, COBBITTY
(TRANCHE 4, STAGE 3a.)
ROAD & DRAINAGE DESIGN

Title:
ROAD CROSS SECTIONS
SHEET 10

Project No.	Set No.	Milestone	Plan	Revision
23-0563	01	SWC	319	G

ROAD 29

WORKS AS EXECUTED
WORKS AS EXECUTED INFORMATION SHOWN IN RED.
DATE: 07/02/2025
REGISTERED SURVEYOR ID: 8890
ORION GROUP

LEGEND	
EXISTING SURFACE	
DESIGN SURFACE	

G

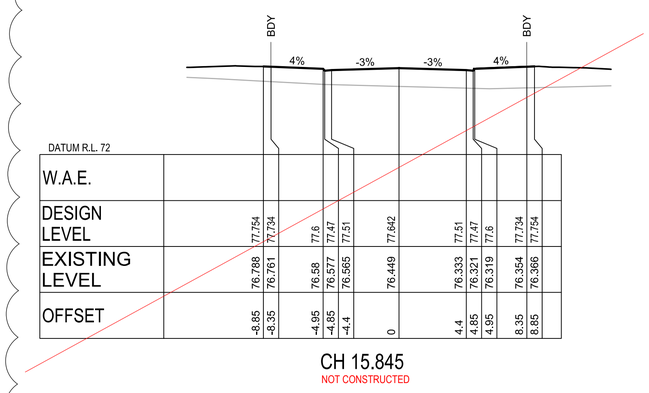

DATUM R.L. 72

W.A.E.											
DESIGN LEVEL		77.754	77.734	77.6	77.47	77.51	77.642	77.51	77.47	77.6	77.734	77.754
EXISTING LEVEL		76.788	76.761	76.58	76.577	76.565	76.449	76.333	76.321	76.319	76.354	76.366
OFFSET		-8.85	-8.35	-4.95	-4.85	-4.4	0	4.4	4.85	4.95	8.35	8.85

CH 15.845
NOT CONSTRUCTED

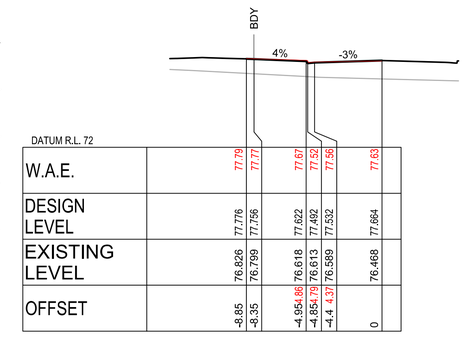

DATUM R.L. 72

W.A.E.		77.79	77.77	77.67	77.52	77.56	77.63
DESIGN LEVEL		77.776	77.756	77.622	77.492	77.532	77.684
EXISTING LEVEL		76.826	76.799	76.618	76.613	76.589	76.468
OFFSET	-8.85	-8.35	-4.95	-4.85	-4.4	4.37	0

CH 15
NOT CONSTRUCTED

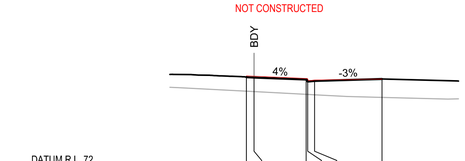

DATUM R.L. 72

W.A.E.		77.91	77.89	77.74	77.60	77.63	77.69
DESIGN LEVEL		77.83	77.81	77.676	77.546	77.586	77.718
EXISTING LEVEL		76.917	76.89	76.712	76.707	76.683	76.511
OFFSET	-8.85	-8.35	-4.95	-4.85	-4.4	4.35	0

CH 12.994

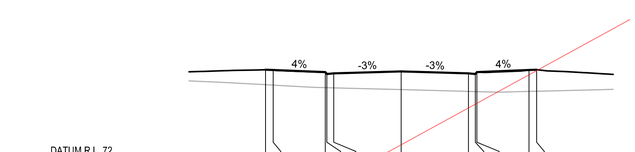

DATUM R.L. 72

W.A.E.											
DESIGN LEVEL		77.734	77.714	77.58	77.45	77.49	77.622	77.49	77.45	77.58	77.714	77.734
EXISTING LEVEL		76.753	76.726	76.563	76.561	76.549	76.432	76.316	76.304	76.301	76.313	76.325
OFFSET	-8.85	-8.35	-4.95	-4.85	-4.4	0	4.4	4.85	4.95	8.35	8.85	

CH 16.628
NOT CONSTRUCTED

CAMDEN COUNCIL
Approved by the Council of Camden under the provisions of the Environment Planning and Assessment Act 1979
APPROVAL

22/03/2024

SUBDIVISION WORKS CERTIFICATE

DA/2023/215/1 SWC.16.2023.215.1

ISSUED FOR SUBDIVISION WORKS CERTIFICATE

Rev	Drawn	Design	Check	Appd.	Date	Revision Description
G	RL/WP	LMc	AP	AP	20/03/2024	ISSUED FOR SUBDIVISION WORKS CERTIFICATE
F	WP	LMc	AP	AP	07/03/2024	ISSUED FOR SUBDIVISION WORKS CERTIFICATE
E	WP	LMc	AP	AP	27/02/2024	ISSUED FOR SUBDIVISION WORKS CERTIFICATE
D	RL	LMc	AP	AP	07/02/2024	ISSUED FOR SUBDIVISION WORKS CERTIFICATE
C	RL	LMc	AP	AP	23/01/2024	ISSUED FOR SUBDIVISION WORKS CERTIFICATE
B	RL	LMc	MP	AP	01/12/2023	ISSUED FOR SUBDIVISION WORKS CERTIFICATE
A	RL	LM/YK	MP	AP	27/11/2023	ISSUED FOR SUBDIVISION WORKS CERTIFICATE

Disclaimer and Copyright:
ALL DIMENSIONS TO BE CHECKED ON SITE BY THE CONTRACTOR PRIOR TO CONSTRUCTION.
USE WRITTEN DIMENSIONS ONLY, DO NOT SCALE.
THESE DRAWINGS, PLANS, AND SPECIFICATIONS AND THE COPYRIGHT ARE THE PROPERTY OF ORION CONSULTING ENGINEERS PTY LTD AND MUST NOT BE REPRODUCED OR COPIED WHOLLY OR IN PART WITHOUT THE PERMISSION OF ORION CONSULTING ENGINEERS PTY LTD

Scale:
0 2.0 4.0 6.0 8.0 10.0 12.0 14.0 16.0 18.0 20.0
SCALE 1:200 (A1) SCALE 1:400 (A3)

For: mirvac

By: ORION
JAS-ANZ
WWW.JAS-ANZ.ORG/REGISTER
ABN:25 604 069 981 PO Box:7936, BAULKHAM HILLS NSW 2153 T:(02) 8660 0035 E:info@theoriongroup.au

Project:
589, 591 & 593 COBBITTY ROAD, COBBITTY
(TRANCHE 4, STAGE 3a.)
ROAD & DRAINAGE DESIGN

Title:
ROAD CROSS SECTIONS
SHEET 11

Project No.	Set No.	Milestone	Plan	Revision
23-0563	01	SWC	320	G

ROAD 40

WORKS AS EXECUTED
WORKS AS EXECUTED INFORMATION SHOWN IN RED.
DATE: 07/02/2025
REGISTERED SURVEYOR ID: 8890
ORION GROUP

LEGEND	
EXISTING SURFACE	
DESIGN SURFACE	

G

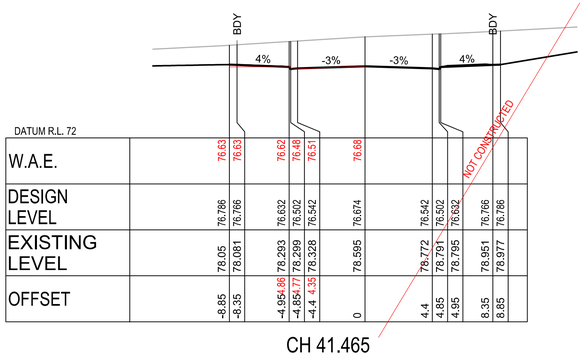

DATUM R.L. 72

W.A.E.	76.63	76.63	76.62	76.48	76.51	76.68						76.766	76.766
DESIGN LEVEL	76.766	76.766	76.632	76.502	76.542	76.674	76.542	76.502	76.632	76.766	76.766		
EXISTING LEVEL	78.05	78.081	78.293	78.299	78.328	78.595	78.772	78.791	78.795	78.951	78.977		
OFFSET	-8.85	-8.35	-4.95	-4.85	-4.4	0	4.4	4.85	4.95	8.35	8.85		

CH 41.465

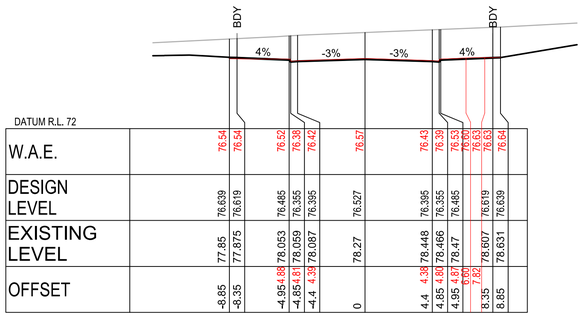

DATUM R.L. 72

W.A.E.	76.54	76.54	76.52	76.38	76.42	76.57	76.43	76.39	76.53	76.63	76.63	76.64	
DESIGN LEVEL	76.639	76.619	76.485	76.355	76.395	76.527	76.395	76.355	76.485	76.619	76.639		
EXISTING LEVEL	77.85	77.875	78.053	78.059	78.087	78.27	78.448	78.466	78.47	78.607	78.631		
OFFSET	-8.85	-8.35	-4.95	-4.85	-4.4	0	4.4	4.85	4.95	8.35	8.85		

			4.88	4.81	4.39		4.39	4.60	4.87	6.00	7.82		

CH 35.5

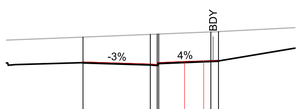

DATUM R.L. 72

W.A.E.					76.54		76.39	76.35	76.49	76.53	76.60	76.60	76.62
DESIGN LEVEL					76.495		76.363	76.323	76.453			76.597	76.607
EXISTING LEVEL					78.165		78.343	78.361	78.365			78.502	78.522
OFFSET					0		4.4	4.85	4.95			8.35	8.85

							4.39	4.81	4.87	6.04	7.89		

CH 33.572

CAMDEN COUNCIL
Approved by the Council of Camden under the provisions of the Environment Planning and Assessment Act 1979
APPROVAL

22/03/2024

SUBDIVISION WORKS CERTIFICATE

DA/2023/215/1 SWC.16.2023.215.1

ISSUED FOR SUBDIVISION WORKS CERTIFICATE

Rev	Drawn	Design	Check	Appd.	Date	Revision Description
G	RL/WP	LMc	AP	AP	20/03/2024	ISSUED FOR SUBDIVISION WORKS CERTIFICATE
F	WP	LMc	AP	AP	07/03/2024	ISSUED FOR SUBDIVISION WORKS CERTIFICATE
E	WP	LMc	AP	AP	27/02/2024	ISSUED FOR SUBDIVISION WORKS CERTIFICATE
D	RL	LMc	AP	AP	07/02/2024	ISSUED FOR SUBDIVISION WORKS CERTIFICATE
C	RL	LMc	AP	AP	23/01/2024	ISSUED FOR SUBDIVISION WORKS CERTIFICATE
B	RL	LMc	MP	AP	01/12/2023	ISSUED FOR SUBDIVISION WORKS CERTIFICATE
A	RL	LM/YK	MP	AP	27/11/2023	ISSUED FOR SUBDIVISION WORKS CERTIFICATE

Disclaimer and Copyright:
ALL DIMENSIONS TO BE CHECKED ON SITE BY THE CONTRACTOR PRIOR TO CONSTRUCTION.
USE WRITTEN DIMENSIONS ONLY, DO NOT SCALE.
THESE DRAWINGS, PLANS, AND SPECIFICATIONS AND THE COPYRIGHT ARE THE PROPERTY OF ORION CONSULTING ENGINEERS PTY LTD AND MUST NOT BE REPRODUCED OR COPIED WHOLLY OR IN PART WITHOUT THE PERMISSION OF ORION CONSULTING ENGINEERS PTY LTD

Scale:
0 2.0 4.0 6.0 8.0 10.0 12.0 14.0 16.0 18.0 20.0
SCALE 1:200 (A1) SCALE 1:400 (A3)

For: mirvac

By: ORION

ABN:25 604 069 981 PO Box:7936, BAULKHAM HILLS NSW 2153 T:(02) 8660 0035 E:info@theoriongroup.au

Project:
589, 591 & 593 COBBITTY ROAD, COBBITTY
(TRANCHE 4, STAGE 3a.)
ROAD & DRAINAGE DESIGN

Title:
ROAD CROSS SECTIONS
SHEET 12

Project No.	Set No.	Milestone	Plan	Revision
23-0563	01	SWC	321	G

ROAD 40A

| DATUM R.L. 78 | | |

HOOK STREET

WORKS AS EXECUTED
WORKS AS EXECUTED INFORMATION SHOWN IN RED.
DATE: 07/02/2025
REGISTERED SURVEYOR ID: 8890
ORION GROUP

LEGEND	
EXISTING SURFACE	
DESIGN SURFACE	

G

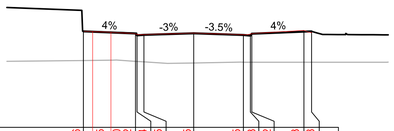

DATUM R.L. 75														
W.A.E.		81.26		81.25	81.20	81.12		81.15		81.05	81.03	81.12	81.33	81.18
DESIGN LEVEL	81.268				81.134	81.004	81.044	81.142		81.028	80.988	81.118	81.252	81.272
EXISTING LEVEL	79.367				79.314	79.307	79.277	79.205		79.257	79.254	79.253	79.254	79.255
OFFSET	-7.2		6.59	8.40	8.99	3.57	-3.25	0		3.25	3.7	3.8	7.2	7.7
				-3.9	-3.7		-3.34			3.22	3.43	3.82		

CH -24.627

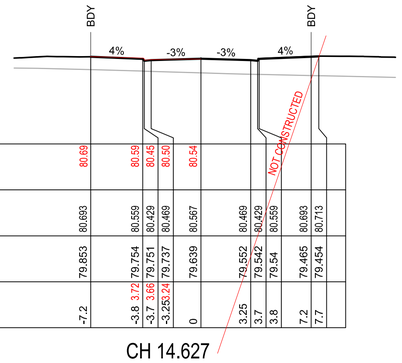

DATUM R.L. 75														
W.A.E.		80.69		80.59	80.45	80.50	80.54							
DESIGN LEVEL	80.693			80.559	80.429	80.469	80.567		80.469		80.559	80.693		
EXISTING LEVEL	79.853			79.754	79.751	79.737	79.639		79.552	80.429	79.54	79.465	80.713	
OFFSET	-7.2			-3.8	-3.7	-3.25	0		3.25	3.7	3.8	7.2	7.7	
				3.72	3.66	3.24				3.7		3.82		

CH 14.627

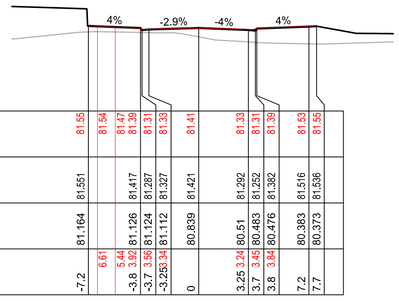

DATUM R.L. 76														
W.A.E.		81.55		81.54	81.47	81.39	81.31	81.33	81.41		81.33	81.31	81.39	81.53	81.55
DESIGN LEVEL	81.551				81.417	81.287	81.327	81.421			81.292	81.252	81.382	81.516	81.536
EXISTING LEVEL	81.164				81.126	81.124	81.112	80.839			80.51	80.483	80.476	80.383	80.373
OFFSET	-7.2		6.61	5.44	3.42	3.56	-3.25	0		3.25	3.45	3.84	7.2	7.7	
				-3.8	-3.7		-3.34			3.24	3.7	3.8			

CH -30

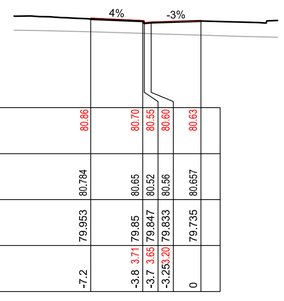

DATUM R.L. 75														
W.A.E.		80.86			80.70	80.55	80.60	80.63						
DESIGN LEVEL	80.784				80.65	80.52	80.56	80.657						
EXISTING LEVEL	79.953				79.85	79.847	79.833	79.735						
OFFSET	-7.2			-3.8	-3.7	-3.25	0							
				3.71	3.65	3.20								

CH 11.783

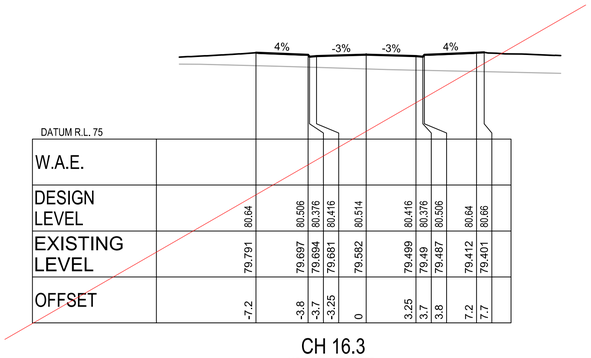

DATUM R.L. 75														
W.A.E.														
DESIGN LEVEL				80.64	80.506	80.376	80.416	80.514		80.416	80.376	80.506		
EXISTING LEVEL				79.791	79.697	79.694	79.681	79.582		79.499	79.49	79.467	79.412	80.66
OFFSET				-7.2	-3.8	-3.7	-3.25	0		3.25	3.7	3.8	7.2	7.7
													79.401	

CH 16.3
NOT CONSTRUCTED

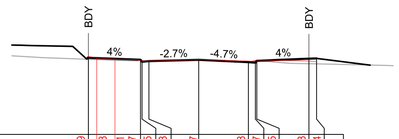

DATUM R.L. 77														
W.A.E.		82.09		81.96	81.91	81.87	81.75	81.78	81.87		81.78	81.77	81.85	81.78	81.74
DESIGN LEVEL	82.011				81.877	81.747	81.787	81.876			81.723	81.683	81.813	81.947	81.967
EXISTING LEVEL	81.909				81.847	81.832	81.787	81.877			81.733	81.8	81.815	81.618	81.607
OFFSET	-7.2		6.66	5.47	3.58	3.59	-3.25	0		3.25	3.47	3.85	7.2	7.7	
				-3.9	-3.7		-3.35			3.25	3.7	3.8			

CH -38.741

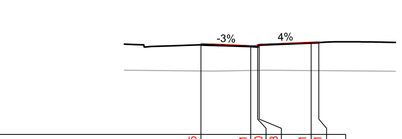

DATUM R.L. 75														
W.A.E.		80.95			80.81	80.80	80.88	81.01	81.01					
DESIGN LEVEL	80.855				80.757	80.717	80.847	80.981	81.001					
EXISTING LEVEL	79.144				79.18	79.188	79.19	79.174	79.17					
OFFSET	0			3.25	3.23	3.52	3.82	7.2	7.7					

CH -18.783

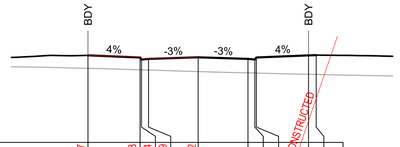

DATUM R.L. 75														
W.A.E.		80.67		80.58	80.44	80.49	80.52							
DESIGN LEVEL	80.681			80.547	80.417	80.457	80.555		80.457					
EXISTING LEVEL	79.839			79.741	79.738	79.725	79.626		79.54	80.417	80.547	79.453	80.681	
OFFSET	-7.2			-3.8	-3.7	-3.25	0		3.25	3.7	3.8	7.2	7.7	
				3.73	3.67	3.23								

CH 15

CAMDEN COUNCIL
Approved by the Council of Camden under the provisions of the Environment Planning and Assessment Act 1979
APPROVAL

22/03/2024

SUBDIVISION WORKS CERTIFICATE

DA/2023/215/1 SWC.16.2023.215.1

ISSUED FOR SUBDIVISION WORKS CERTIFICATE

Rev	Drawn	Design	Check	Appd.	Date	Revision Description
G	RL/WP	LMc	AP	AP	20/03/2024	ISSUED FOR SUBDIVISION WORKS CERTIFICATE
F	WP	LMc	AP	AP	07/03/2024	ISSUED FOR SUBDIVISION WORKS CERTIFICATE
E	WP	LMc	AP	AP	27/02/2024	ISSUED FOR SUBDIVISION WORKS CERTIFICATE
D	RL	LMc	AP	AP	07/02/2024	ISSUED FOR SUBDIVISION WORKS CERTIFICATE
C	RL	LMc	AP	AP	23/01/2024	ISSUED FOR SUBDIVISION WORKS CERTIFICATE
B	RL	LMc	MP	AP	01/12/2023	ISSUED FOR SUBDIVISION WORKS CERTIFICATE
A	RL	LM/YK	MP	AP	27/11/2023	ISSUED FOR SUBDIVISION WORKS CERTIFICATE

Disclaimer and Copyright:
ALL DIMENSIONS TO BE CHECKED ON SITE BY THE CONTRACTOR PRIOR TO CONSTRUCTION.
USE WRITTEN DIMENSIONS ONLY, DO NOT SCALE.
THESE DRAWINGS, PLANS, AND SPECIFICATIONS AND THE COPYRIGHT ARE THE PROPERTY OF ORION CONSULTING ENGINEERS PTY LTD AND MUST NOT BE REPRODUCED OR COPIED WHOLLY OR IN PART WITHOUT THE PERMISSION OF ORION CONSULTING ENGINEERS PTY LTD

Scale:
0 2.0 4.0 6.0 8.0 10.0 12.0 14.0 16.0 18.0 20.0
SCALE 1:200 (A1) SCALE 1:400 (A3)

For: mirvac

By: ORION
ABN:25 604 069 981 PO Box:7936, BAULKHAM HILLS NSW 2153 T:(02) 8660 0035 E:info@theoriongroup.au

Project:
589, 591 & 593 COBBITTY ROAD, COBBITTY
(TRANCHE 4, STAGE 3a.)
ROAD & DRAINAGE DESIGN

Title:
ROAD CROSS SECTIONS
SHEET 14

Project No.	Set No.	Milestone	Plan	Revision
23-0563	01	SWC	323	G

WISTERIA RISE

WORKS AS EXECUTED
WORKS AS EXECUTED INFORMATION SHOWN IN RED.
DATE: 07/02/2025
REGISTERED SURVEYOR ID: 8890
ORION GROUP

LEGEND	
EXISTING SURFACE	
DESIGN SURFACE	

G

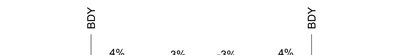

DATUM R.L. 76													
W.A.E.		81.55	81.53		81.50	81.36	81.40	81.49		81.42	81.38	81.52	81.51
DESIGN LEVEL	81.63	81.61		81.476	81.346	81.386		81.483	81.386	81.346	81.476		81.61
EXISTING LEVEL	80.774	80.775		80.78	80.781	80.781		80.787	80.793	80.794	80.795		80.796
OFFSET	-7.7 7.69	-7.2 7.20		-3.8 3.71	-3.7 3.67	-3.25 3.19		0	3.25 3.23	3.7 3.64	3.8 3.68		7.2 7.21

CH 15

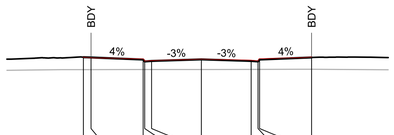

DATUM R.L. 76													
W.A.E.		81.65	81.61		81.53	81.39	81.43	81.52		81.45	81.40	81.55	81.66
DESIGN LEVEL	81.657	81.637		81.503	81.373	81.413		81.511	81.413	81.373	81.503		81.637
EXISTING LEVEL	80.842	80.842		80.848	80.848	80.849		80.854	80.862	80.863	80.863		80.866
OFFSET	-7.7	-7.2		-3.8 3.76	-3.7 3.70	-3.25 3.24		0	3.25 3.29	3.7 3.70	3.8 3.76		7.2

CH 13.595

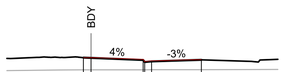

DATUM R.L. 76								
W.A.E.		81.66	81.66		81.54	81.40	81.45	81.53
DESIGN LEVEL	81.671	81.651		81.517	81.387	81.427		81.524
EXISTING LEVEL	80.873	80.874		80.879	80.879	80.88		80.885
OFFSET	-7.7	-7.2		-3.8 3.76	-3.7 3.71	-3.25 3.29		0

CH 12.949

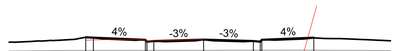

DATUM R.L. 76										
W.A.E.		81.42	81.45		81.49	81.35	81.39	81.48		
DESIGN LEVEL	81.526	81.666		81.472	81.342	81.382		81.48	81.382	81.342	81.472		81.666
EXISTING LEVEL	80.764	80.765		80.771	80.771	80.772		80.777	80.783	80.784	80.785		80.787
OFFSET	-7.7	-7.2		-3.8 3.76	-3.7 3.69	-3.25 3.25		0	3.25	3.7	3.8		7.2

CH 15.2

CAMDEN COUNCIL
Approved by the Council of Camden under the provisions of the Environment Planning and Assessment Act 1979
APPROVAL

22/03/2024

SUBDIVISION WORKS CERTIFICATE

DA/2023/215/1 SWC.16.2023.215.1

ISSUED FOR SUBDIVISION WORKS CERTIFICATE

Rev	Drawn	Design	Check	Appd.	Date	Revision Description
G	RL/WP	LMc	AP	AP	20/03/2024	ISSUED FOR SUBDIVISION WORKS CERTIFICATE
F	WP	LMc	AP	AP	07/03/2024	ISSUED FOR SUBDIVISION WORKS CERTIFICATE
E	WP	LMc	AP	AP	27/02/2024	ISSUED FOR SUBDIVISION WORKS CERTIFICATE
D	RL	LMc	AP	AP	07/02/2024	ISSUED FOR SUBDIVISION WORKS CERTIFICATE
C	RL	LMc	AP	AP	23/01/2024	ISSUED FOR SUBDIVISION WORKS CERTIFICATE
B	RL	LMc	MP	AP	01/12/2023	ISSUED FOR SUBDIVISION WORKS CERTIFICATE
A	RL	LM/YK	MP	AP	27/11/2023	ISSUED FOR SUBDIVISION WORKS CERTIFICATE

Disclaimer and Copyright:
ALL DIMENSIONS TO BE CHECKED ON SITE BY THE CONTRACTOR PRIOR TO CONSTRUCTION.
USE WRITTEN DIMENSIONS ONLY, DO NOT SCALE.
THESE DRAWINGS, PLANS, AND SPECIFICATIONS AND THE COPYRIGHT ARE THE PROPERTY OF ORION CONSULTING ENGINEERS PTY LTD AND MUST NOT BE REPRODUCED OR COPIED WHOLLY OR IN PART WITHOUT THE PERMISSION OF ORION CONSULTING ENGINEERS PTY LTD

Scale:
0 2.0 4.0 6.0 8.0 10.0 12.0 14.0 16.0 18.0 20.0
SCALE 1:200 (A1) SCALE 1:400 (A3)

For: mirvac

By: ORION
ABN:25 604 069 981 PO Box:7936, BAULKHAM HILLS NSW 2153 T:(02) 8660 0035 E:info@theoriongroup.au

Project:
589, 591 & 593 COBBITTY ROAD, COBBITTY
(TRANCHE 4, STAGE 3a.)
ROAD & DRAINAGE DESIGN

Title:
ROAD CROSS SECTIONS
SHEET 15

Project No.	Set No.	Milestone	Plan	Revision
23-0563	01	SWC	324	G

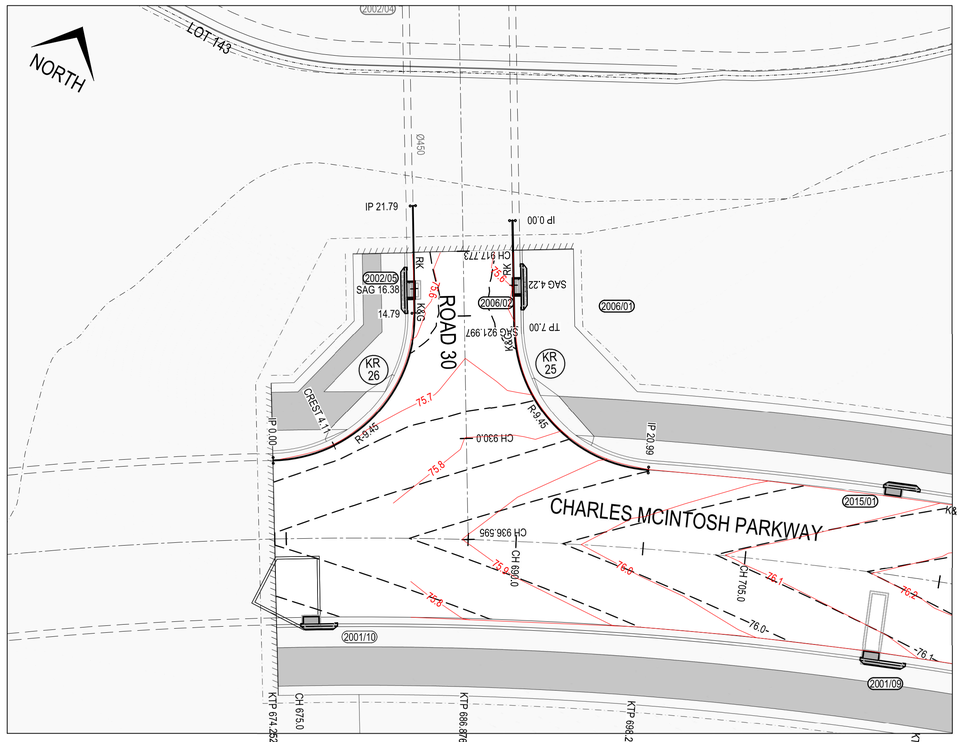

KERB RETURN PLAN - KR 25 & 26

SCALE 1:200

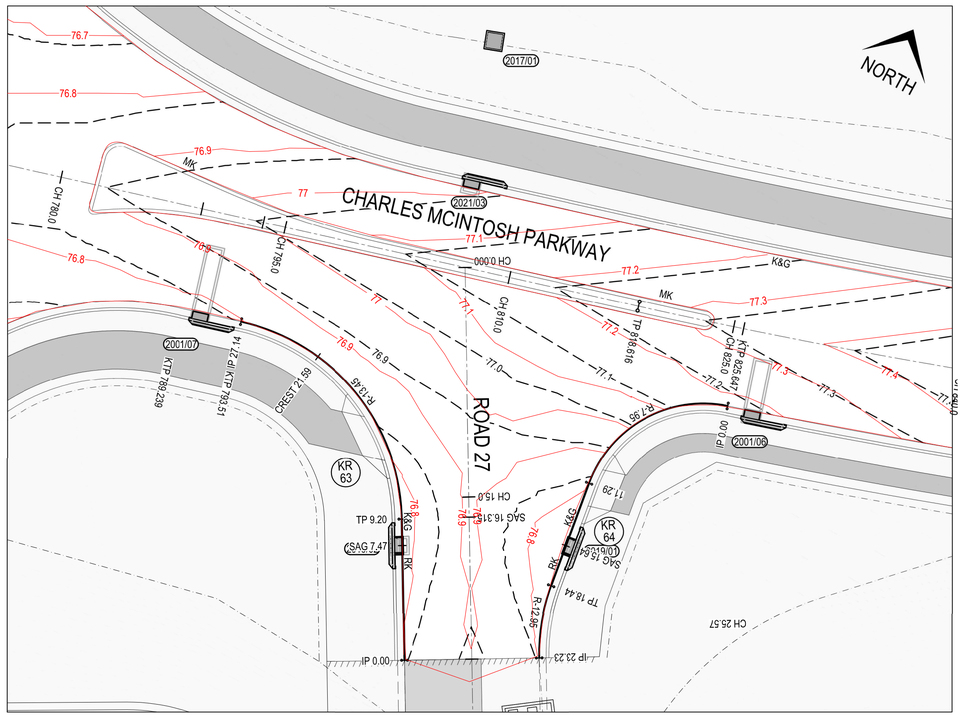

KERB RETURN PLAN - KR 63 & 64

SCALE 1:200

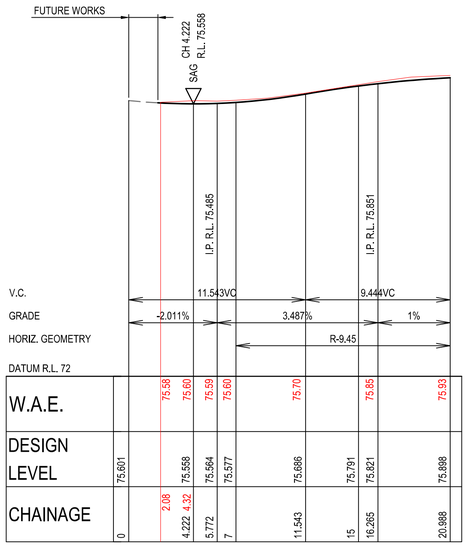

KERB RETURN KR 25

SCALE 1:200 (H)

SCALE 1:40 (V)

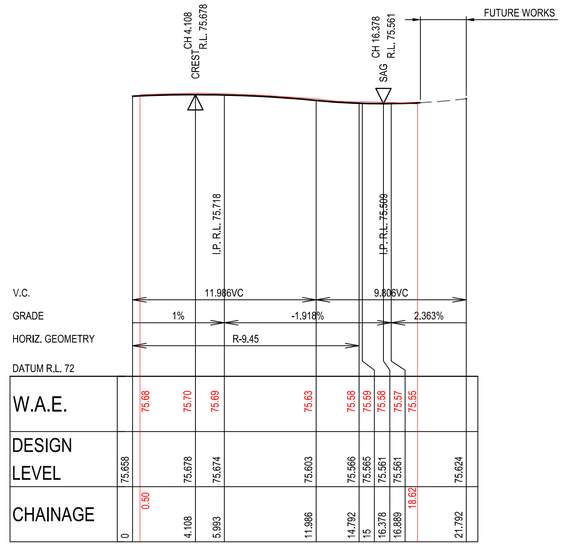

KERB RETURN KR 26

SCALE 1:200 (H)

SCALE 1:40 (V)

CAMDEN COUNCIL
Approved by the Council of Camden under the provisions of the Environment Planning and Assessment Act 1979
APPROVAL

02/07/2024

SUBDIVISION WORKS CERTIFICATE

DA/DA/2023/215/2 SWC.16.2023.215.2

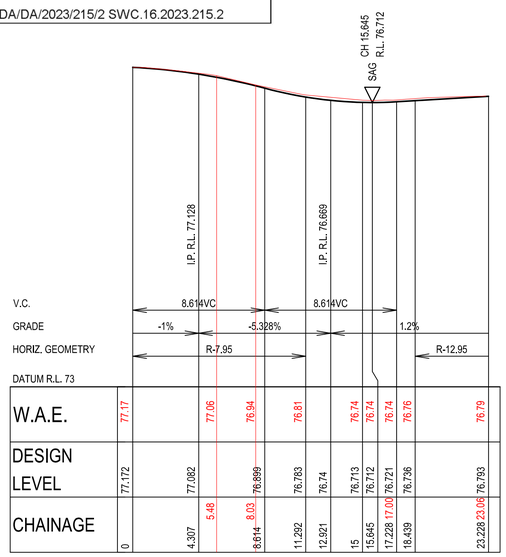

KERB RETURN KR 64

SCALE 1:200 (H)

SCALE 1:40 (V)

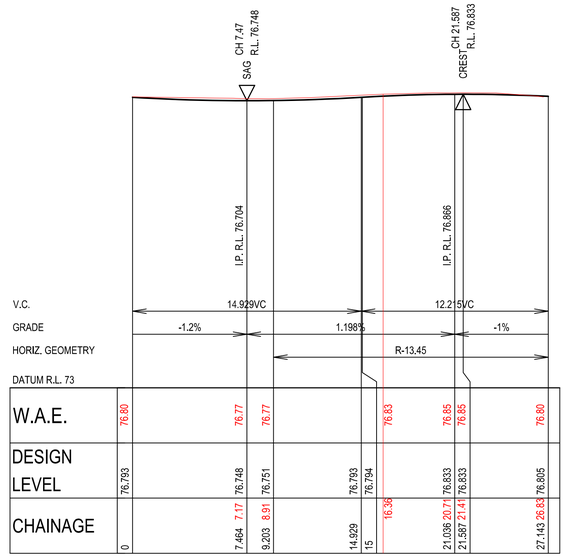

KERB RETURN KR 63

SCALE 1:200 (H)

SCALE 1:40 (V)

WORKS AS EXECUTED

WORKS AS EXECUTED INFORMATION SHOWN IN RED.
DATE: 07/02/2025

REGISTERED SURVEYOR ID: 8890
ORION GROUP

NOTE:

- KERB RETURNS ARE SET OUT TO THE LIP OF GUTTER.
- FOR KERB RETURN LOCALITY PLAN REFER TO SHEET SWC 400.

ISSUED FOR SUBDIVISION WORKS CERTIFICATE

Rev	Drawn	Design	Check	Appd.	Date	Revision Description
B	WP	LMc	AP	AP	19/06/2024	RE-ISSUED FOR SWC MOD APPROVAL
A	RL	LMc	AP	AP	24/05/2024	ISSUED FOR SWC MOD APPROVAL

Disclaimer and Copyright:
ALL DIMENSIONS TO BE CHECKED ON SITE BY THE CONTRACTOR PRIOR TO CONSTRUCTION.
USE WRITTEN DIMENSIONS ONLY, DO NOT SCALE.
THESE DRAWINGS, PLANS, AND SPECIFICATIONS AND THE COPYRIGHT ARE THE PROPERTY OF ORION CONSULTING ENGINEERS PTY LTD AND MUST NOT BE REPRODUCED OR COPIED WHOLLY OR IN PART WITHOUT THE PERMISSION OF ORION CONSULTING ENGINEERS PTY LTD

Scale:
0 0.4 0.8 1.2 1.6 2 2.4 2.8 3.2 3.6 4
SCALE 1:40 (A1) SCALE 1:80 (A3)
0 2.0 4.0 6.0 8.0 10.0 12.0 14.0 16.0 18.0 20.0
SCALE 1:200 (A1) SCALE 1:400 (A3)

For: mirvac

By: ORION
ABN:25 604 069 981 PO Box:7936, BAULKHAM HILLS NSW 2153 T:(02) 8660 0035 E:info@theorionngroup.au

Project:
589, 591 & 593 COBBITTY ROAD, COBBITTY
(TRANCHE 4, STAGE 3a.)
ROAD & DRAINAGE DESIGN

Title:
KERB RETURN SETOUT PLANS & PROFILES SHEET 01

Project No.	Set No.	Milestone	Plan	Revision
23-0563	02	MOD	401	B

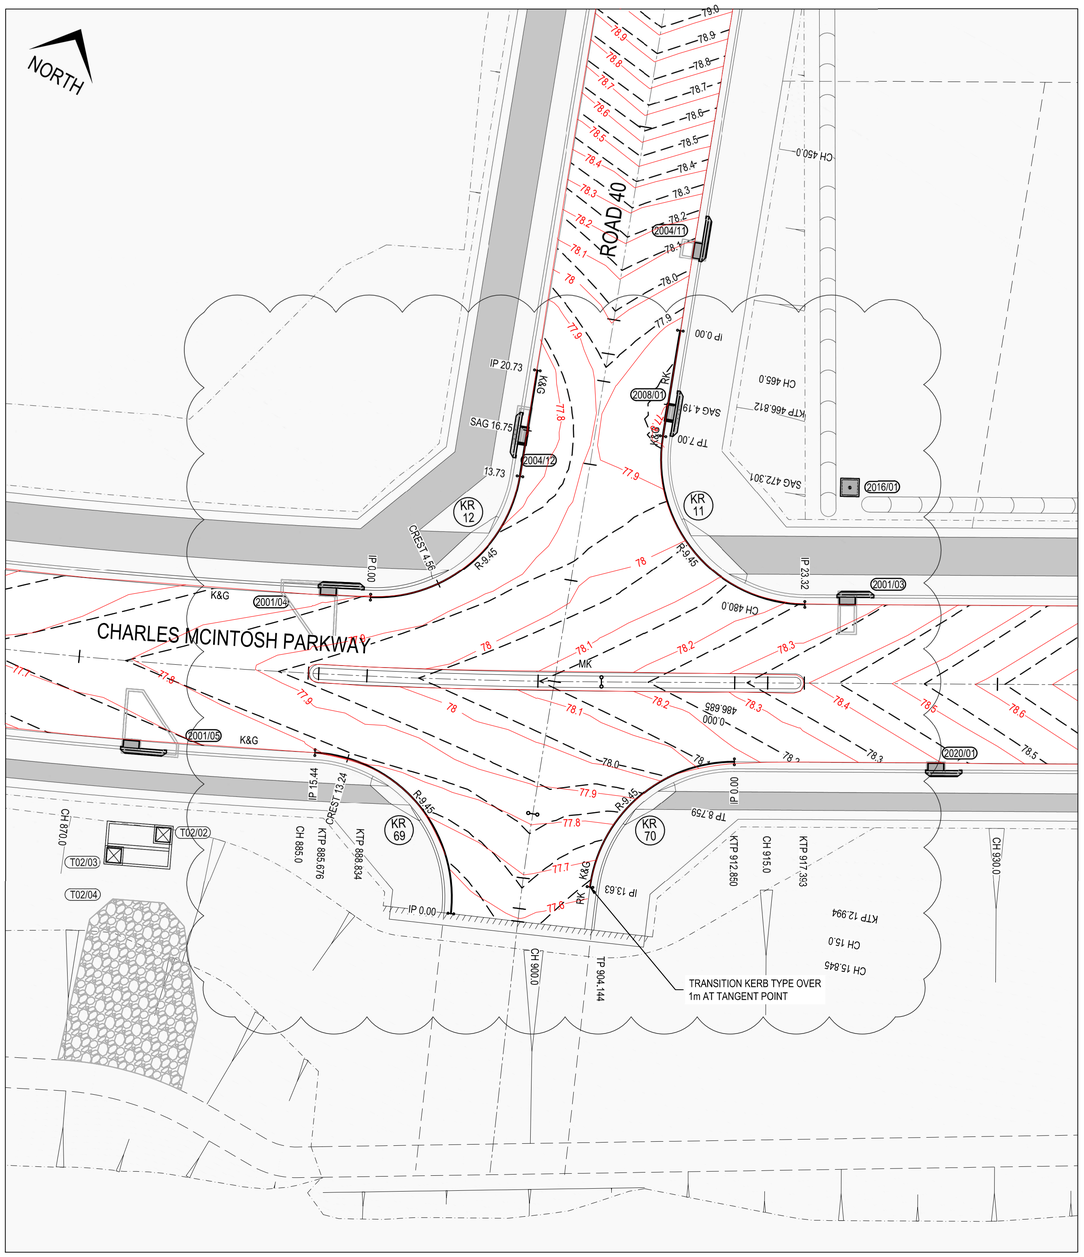

KERB RETURN PLAN - KR 11, 12, 69 & 70

SCALE 1:200

CAMDEN COUNCIL
Approved by the Council of Camden under the provisions of the Environment Planning and Assessment Act 1979
APPROVAL

22/03/2024

SUBDIVISION WORKS CERTIFICATE

DA/2023/215/1 SWC.16.2023.215.1

WORKS AS EXECUTED
WORKS AS EXECUTED INFORMATION SHOWN IN RED.
DATE: 07/02/2025

REGISTERED SURVEYOR ID: 8890
ORION GROUP

NOTE:

- KERB RETURNS ARE SET OUT TO THE LIP OF GUTTER.
- FOR KERB RETURN LOCALITY PLAN REFER TO SHEET SWC 400.

G

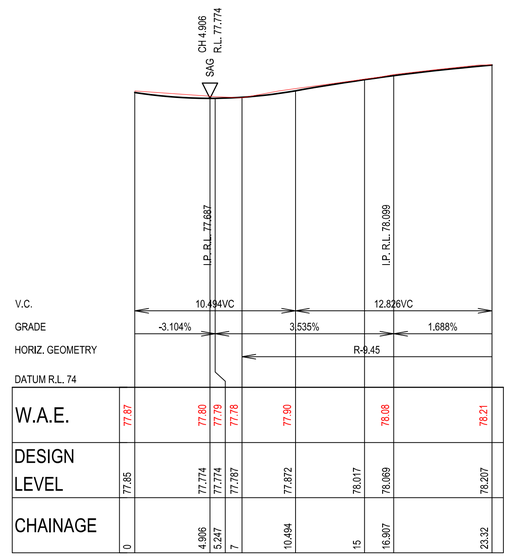

W.A.E.	77.87		77.80	77.79	77.78	77.90	78.08	78.21
DESIGN LEVEL	77.85		77.774	77.774	77.787	77.872	78.017	78.069	78.207
CHAINAGE	0		4.906	5.247	7	10.494	15	16.907	23.32

KERB RETURN KR 11

SCALE 1:200 (H)
SCALE 1:40 (V)

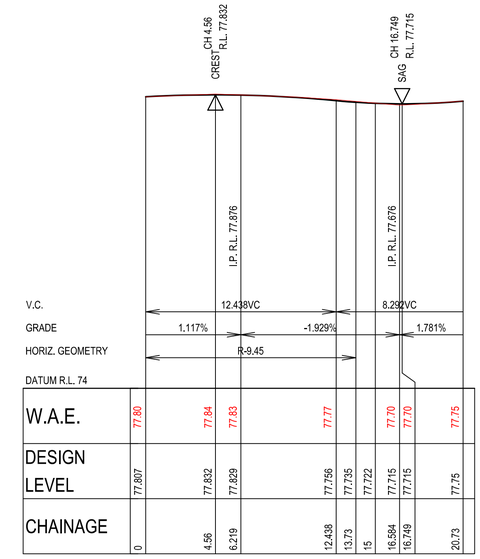

W.A.E.	77.80		77.84	77.83		77.77	77.70	77.70	77.75
DESIGN LEVEL	77.807		77.832	77.829		77.756	77.735	77.722	77.715	77.715	77.75
CHAINAGE	0		4.56	6.219		12.438	13.73	15	16.584	16.749	20.73

KERB RETURN KR 12

SCALE 1:200 (H)
SCALE 1:40 (V)

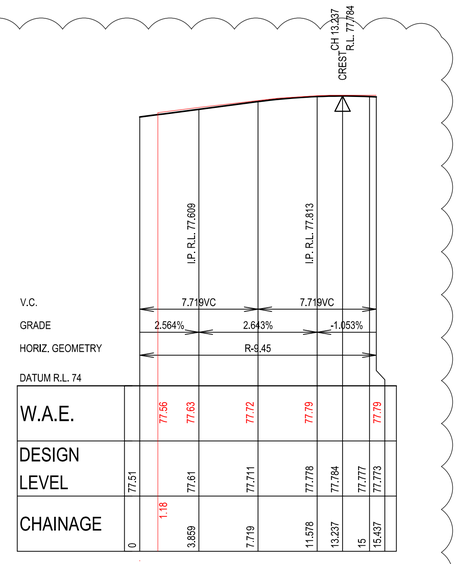

W.A.E.	77.56	77.63		77.72	77.79		77.79	
DESIGN LEVEL	77.51	77.61		77.711	77.778	77.784	77.777	77.773	
CHAINAGE	0	1.18	3.859		7.719	11.578	13.237	15	15.437	

KERB RETURN KR 69

SCALE 1:200 (H)
SCALE 1:40 (V)

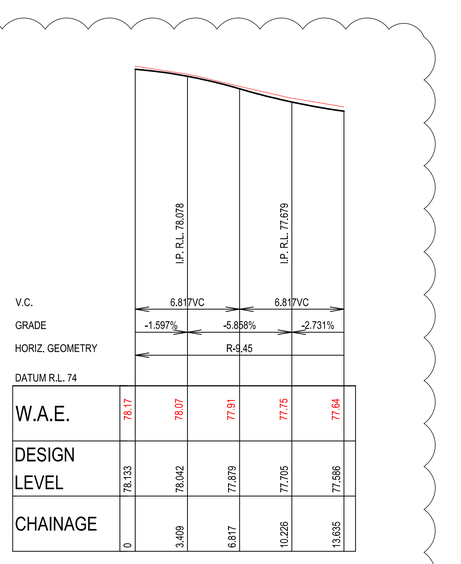

W.A.E.	78.17	78.07	77.91	77.75	77.64
DESIGN LEVEL	78.133	78.042	77.879	77.705	77.586
CHAINAGE	0	3.409	6.817	10.226	13.635

KERB RETURN KR 70

SCALE 1:200 (H)
SCALE 1:40 (V)

ISSUED FOR SUBDIVISION WORKS CERTIFICATE

Rev	Drawn	Design	Check	Appd.	Date	Revision Description
G	RL/WP	LMc	AP	AP	20/03/2024	ISSUED FOR SUBDIVISION WORKS CERTIFICATE
F	WP	LMc	AP	AP	07/03/2024	ISSUED FOR SUBDIVISION WORKS CERTIFICATE
E	WP	LMc	AP	AP	27/02/2024	ISSUED FOR SUBDIVISION WORKS CERTIFICATE
D	RL	LMc	AP	AP	07/02/2024	ISSUED FOR SUBDIVISION WORKS CERTIFICATE
C	RL	LMc	AP	AP	23/01/2024	ISSUED FOR SUBDIVISION WORKS CERTIFICATE
B	RL	LMc	MP	AP	01/12/2023	ISSUED FOR SUBDIVISION WORKS CERTIFICATE
A	RL	LM/YK	MP	AP	27/11/2023	ISSUED FOR SUBDIVISION WORKS CERTIFICATE

Disclaimer and Copyright:
ALL DIMENSIONS TO BE CHECKED ON SITE BY THE CONTRACTOR PRIOR TO CONSTRUCTION.
USE WRITTEN DIMENSIONS ONLY, DO NOT SCALE.
THESE DRAWINGS, PLANS, AND SPECIFICATIONS AND THE COPYRIGHT ARE THE PROPERTY OF ORION CONSULTING ENGINEERS PTY LTD AND MUST NOT BE REPRODUCED OR COPIED WHOLLY OR IN PART WITHOUT THE PERMISSION OF ORION CONSULTING ENGINEERS PTY LTD

Scale:
0 0.4 0.8 1.2 1.6 2 2.4 2.8 3.2 3.6 4
SCALE 1:40 (A1) SCALE 1:80 (A3)
0 2.0 4.0 6.0 8.0 10.0 12.0 14.0 16.0 18.0 20.0
SCALE 1:200 (A1) SCALE 1:400 (A3)

For: mirvac

By: ORION
SUSTAINABLE ENTERPRISES
WWW.JAS-ANZ.ORG/REGISTER
ABN:25 604 069 981 PO Box:7936, BAULKHAM HILLS NSW 2153 T:(02) 8660 0035 E:info@theoriongroup.au

Project:
589, 591 & 593 COBBITTY ROAD, COBBITTY
(TRANCHE 4, STAGE 3a.)
ROAD & DRAINAGE DESIGN

Title:
KERB RETURN SETOUT PLANS & PROFILES SHEET 02

Project No.	Set No.	Milestone	Plan	Revision
23-0563	01	SWC	402	G

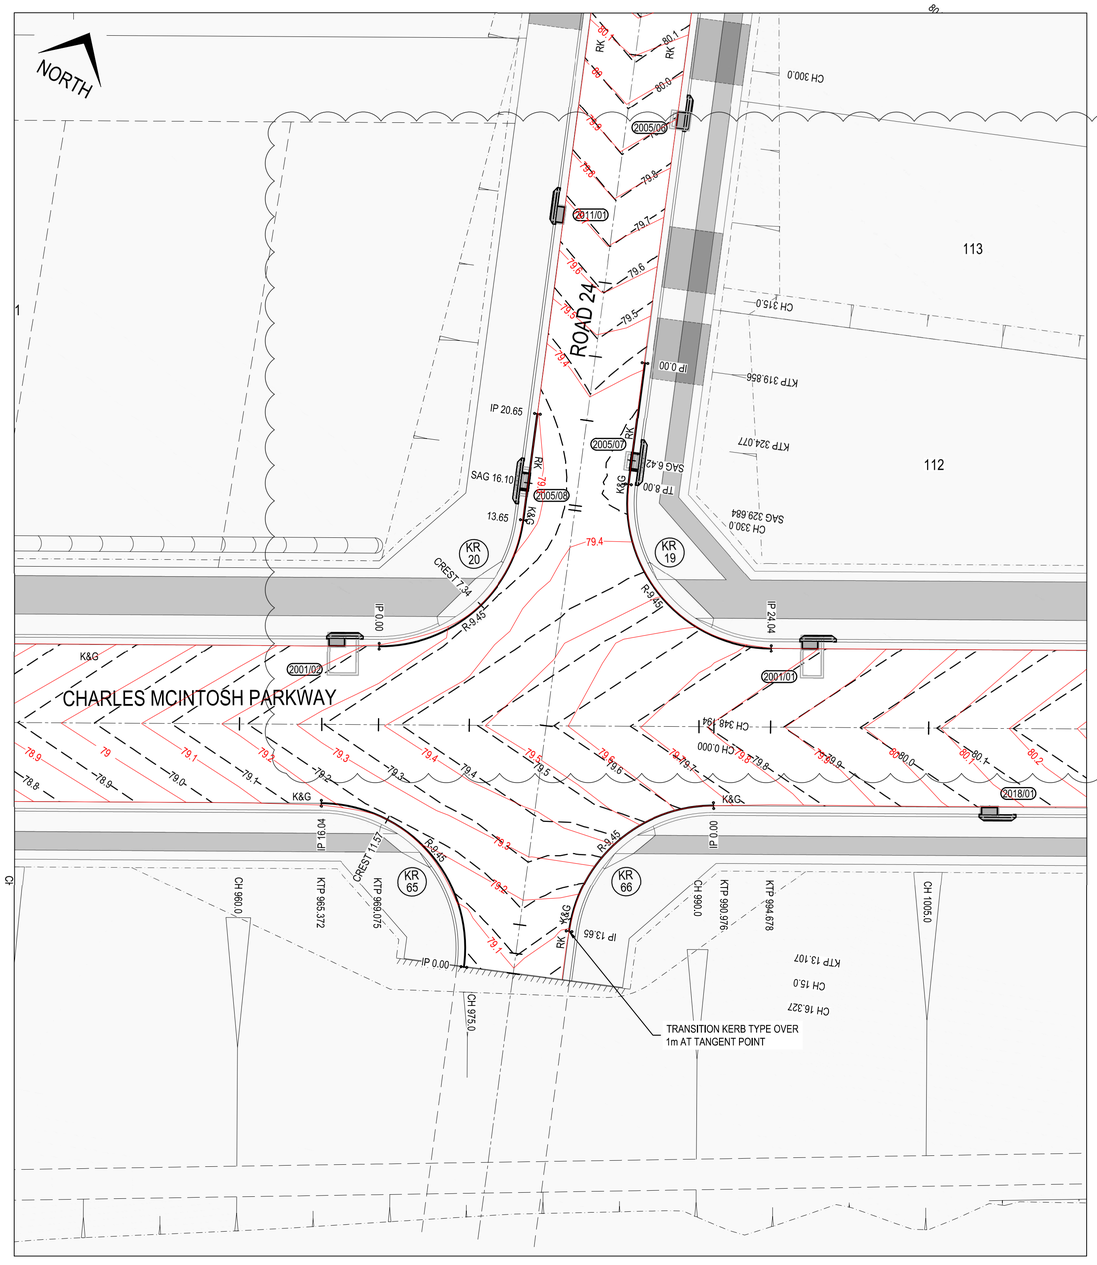

KERB RETURN PLAN - KR 19, 20, 65 & 66

SCALE 1:200

CAMDEN COUNCIL
Approved by the Council of Camden under the provisions of the Environment Planning and Assessment Act 1979
APPROVAL

22/03/2024

SUBDIVISION WORKS CERTIFICATE

DA/2023/215/1 SWC.16.2023.215.1

WORKS AS EXECUTED
WORKS AS EXECUTED INFORMATION SHOWN IN RED.
DATE: 07/02/2025

REGISTERED SURVEYOR ID: 8890
ORION GROUP

NOTE:

- KERB RETURNS ARE SET OUT TO THE LIP OF GUTTER.
- FOR KERB RETURN LOCALITY PLAN REFER TO SHEET SWC 400.

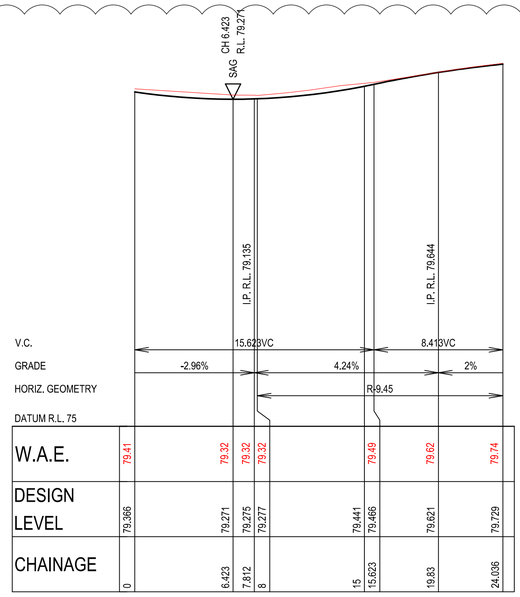

KERB RETURN KR 19

SCALE 1:200 (H)
SCALE 1:40 (V)

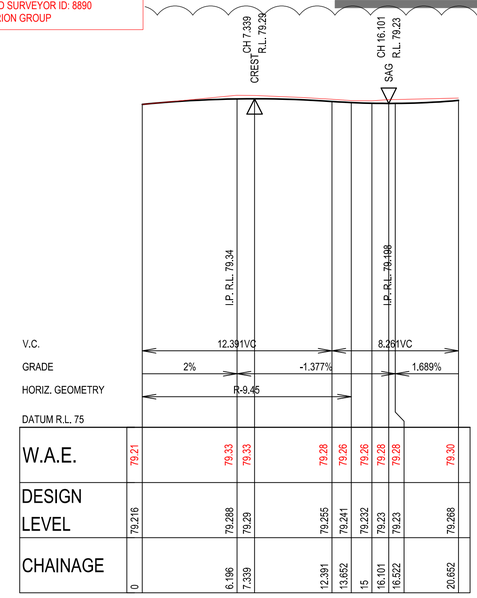

KERB RETURN KR 20

SCALE 1:200 (H)
SCALE 1:40 (V)

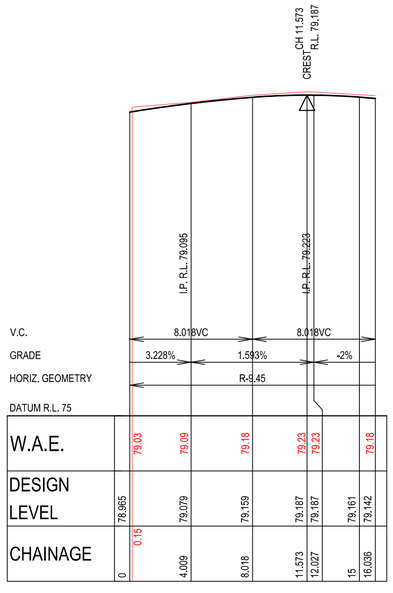

KERB RETURN KR 65

SCALE 1:200 (H)
SCALE 1:40 (V)

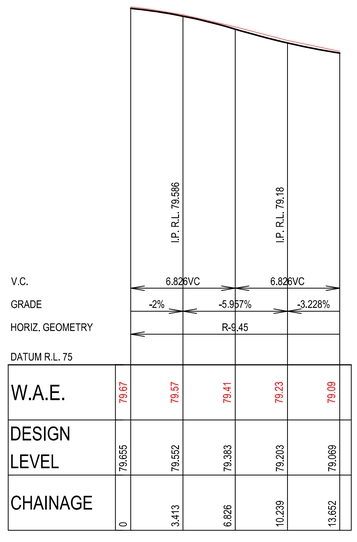

KERB RETURN KR 66

SCALE 1:200 (H)
SCALE 1:40 (V)

ISSUED FOR SUBDIVISION WORKS CERTIFICATE

Rev	Drawn	Design	Check	Appd.	Date	Revision Description
G	RL/WP	LMc	AP	AP	20/03/2024	ISSUED FOR SUBDIVISION WORKS CERTIFICATE
F	WP	LMc	AP	AP	07/03/2024	ISSUED FOR SUBDIVISION WORKS CERTIFICATE
E	WP	LMc	AP	AP	27/02/2024	ISSUED FOR SUBDIVISION WORKS CERTIFICATE
D	RL	LMc	AP	AP	07/02/2024	ISSUED FOR SUBDIVISION WORKS CERTIFICATE
C	RL	LMc	AP	AP	23/01/2024	ISSUED FOR SUBDIVISION WORKS CERTIFICATE
B	RL	LMc	MP	AP	01/12/2023	ISSUED FOR SUBDIVISION WORKS CERTIFICATE
A	RL	LM/YK	MP	AP	27/11/2023	ISSUED FOR SUBDIVISION WORKS CERTIFICATE

Disclaimer and Copyright:
ALL DIMENSIONS TO BE CHECKED ON SITE BY THE CONTRACTOR PRIOR TO CONSTRUCTION.
USE WRITTEN DIMENSIONS ONLY, DO NOT SCALE.
THESE DRAWINGS, PLANS, AND SPECIFICATIONS AND THE COPYRIGHT ARE THE PROPERTY OF ORION CONSULTING ENGINEERS PTY LTD AND MUST NOT BE REPRODUCED OR COPIED WHOLLY OR IN PART WITHOUT THE PERMISSION OF ORION CONSULTING ENGINEERS PTY LTD

Scale:
0 0.4 0.8 1.2 1.6 2 2.4 2.8 3.2 3.6 4
SCALE 1:40 (A1) SCALE 1:80 (A3)
0 2.0 4.0 6.0 8.0 10.0 12.0 14.0 16.0 18.0 20.0
SCALE 1:200 (A1) SCALE 1:400 (A3)

For: mirvac

By: ORION
JAS-ANZ
ABN:25 604 069 981 PO Box:7936, BAULKHAM HILLS NSW 2153 T:(02) 8660 0035 E:info@theoriongroup.au

Project:
589, 591 & 593 COBBITTY ROAD, COBBITTY
(TRANCHE 4, STAGE 3a.)
ROAD & DRAINAGE DESIGN

Title:
KERB RETURN SETOUT PLANS & PROFILES SHEET 03

Project No.	Set No.	Milestone	Plan	Revision
23-0563	01	SWC	403	G

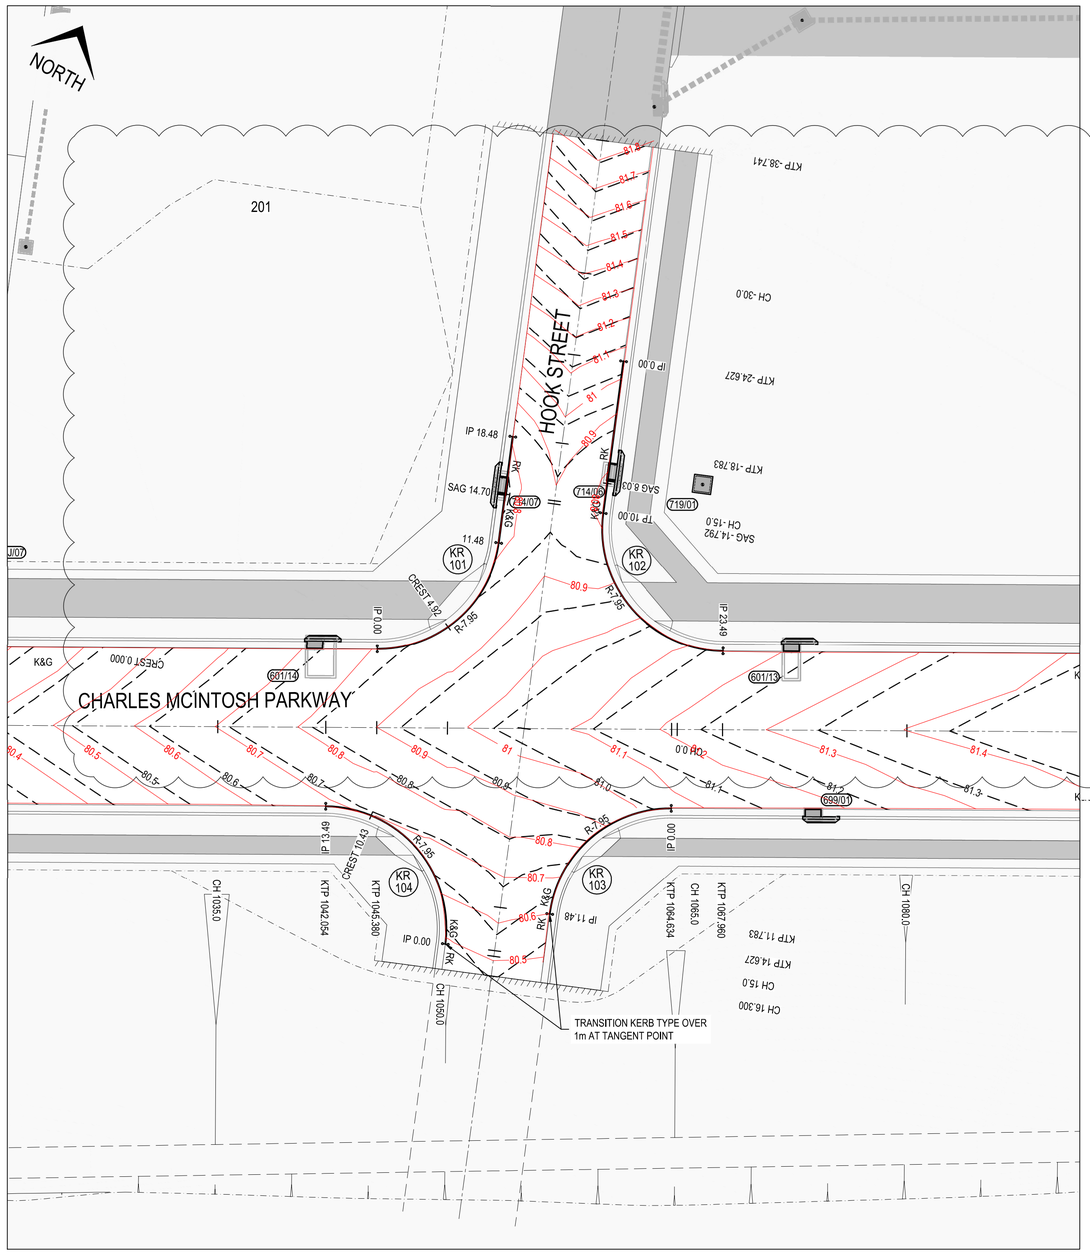

KERB RETURN PLAN - KR 101, 102, 103 & 104

SCALE 1:200

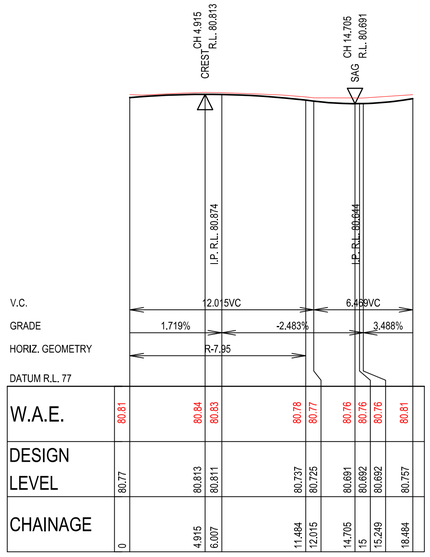

W.A.E.	80.81		80.84	80.83		80.78	80.77	80.76	80.76	80.76	80.81
DESIGN LEVEL	80.77		80.813	80.811		80.737	80.725	80.691	80.692	80.692	80.757
CHAINAGE	0		4.915	6.007		11.484	12.015	14.705	15	15.249	18.484

KERB RETURN KR 101

SCALE 1:200 (H)

SCALE 1:40 (V)

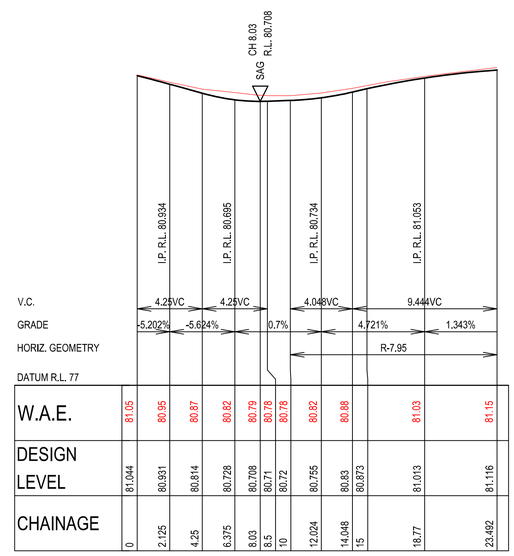

W.A.E.	81.05	80.95	80.87	80.82	80.79	80.78	80.78	80.82	80.88	81.03	81.15
DESIGN LEVEL	81.044	80.931	80.814	80.728	80.708	80.71	80.72	80.755	80.83	80.873	81.013	81.116
CHAINAGE	0	2.125	4.25	6.375	8.03	8.5	10	12.024	14.048	15	18.77	23.492

KERB RETURN KR 102

SCALE 1:200 (H)

SCALE 1:40 (V)

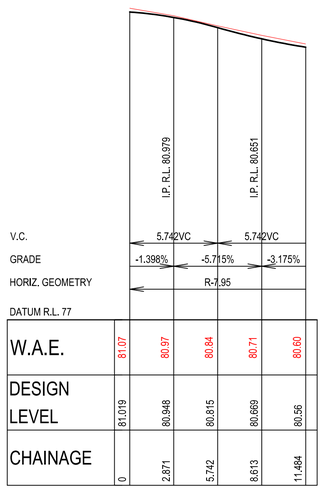

W.A.E.	81.07	80.97	80.84	80.71	80.60
DESIGN LEVEL	81.019	80.948	80.815	80.669	80.56
CHAINAGE	0	2.871	5.742	8.613	11.484

KERB RETURN KR 103

SCALE 1:200 (H)

SCALE 1:40 (V)

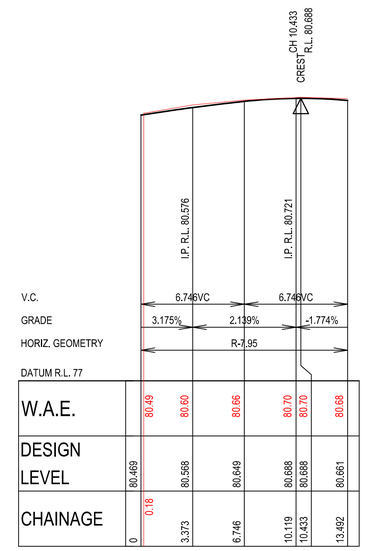

W.A.E.	80.49	80.60	80.66	80.70	80.70	80.68
DESIGN LEVEL	80.469	80.568	80.649	80.688	80.688	80.661
CHAINAGE	0	0.18	3.373	6.746	10.119	10.433	13.492

KERB RETURN KR 104

SCALE 1:200 (H)

SCALE 1:40 (V)

NOTE:

- KERB RETURNS ARE SET OUT TO THE LIP OF GUTTER.
- FOR KERB RETURN LOCALITY PLAN REFER TO SHEET SWC 400.

WORKS AS EXECUTED

WORKS AS EXECUTED INFORMATION SHOWN IN RED.
DATE: 07/02/2025

REGISTERED SURVEYOR ID: 8890
ORION GROUP

CAMDEN COUNCIL
Approved by the Council of Camden under the provisions of the Environment Planning and Assessment Act 1979
APPROVAL

22/03/2024

SUBDIVISION WORKS CERTIFICATE

DA/2023/215/1 SWC.16.2023.215.1

ISSUED FOR SUBDIVISION WORKS CERTIFICATE

Rev	Drawn	Design	Check	Appd.	Date	Revision Description
G	RL/WP	LMc	AP	AP	20/03/2024	ISSUED FOR SUBDIVISION WORKS CERTIFICATE
F	WP	LMc	AP	AP	07/03/2024	ISSUED FOR SUBDIVISION WORKS CERTIFICATE
E	WP	LMc	AP	AP	27/02/2024	ISSUED FOR SUBDIVISION WORKS CERTIFICATE
D	RL	LMc	AP	AP	07/02/2024	ISSUED FOR SUBDIVISION WORKS CERTIFICATE
C	RL	LMc	AP	AP	23/01/2024	ISSUED FOR SUBDIVISION WORKS CERTIFICATE
B	RL	LMc	MP	AP	01/12/2023	ISSUED FOR SUBDIVISION WORKS CERTIFICATE
A	RL	LM/YK	MP	AP	27/11/2023	ISSUED FOR SUBDIVISION WORKS CERTIFICATE

Disclaimer and Copyright:
ALL DIMENSIONS TO BE CHECKED ON SITE BY THE CONTRACTOR PRIOR TO CONSTRUCTION.
USE WRITTEN DIMENSIONS ONLY. DO NOT SCALE.
THESE DRAWINGS, PLANS, AND SPECIFICATIONS AND THE COPYRIGHT ARE THE PROPERTY OF ORION CONSULTING ENGINEERS PTY LTD AND MUST NOT BE REPRODUCED OR COPIED WHOLLY OR IN PART WITHOUT THE PERMISSION OF ORION CONSULTING ENGINEERS PTY LTD

Scale:
0 0.4 0.8 1.2 1.6 2 2.4 2.8 3.2 3.6 4
SCALE 1:40 (A1) SCALE 1:80 (A3)
0 2.0 4.0 6.0 8.0 10.0 12.0 14.0 16.0 18.0 20.0
SCALE 1:200 (A1) SCALE 1:400 (A3)

For: mirvac

By: ORION

ABN:25 604 069 981 PO Box:7936, BAULKHAM HILLS NSW 2153 T:(02) 8660 0035 E:info@theoriongroup.au

Project:
589, 591 & 593 COBBITTY ROAD, COBBITTY
(TRANCHE 4, STAGE 3a.)
ROAD & DRAINAGE DESIGN

Title:
KERB RETURN SETOUT PLANS & PROFILES SHEET 04

Project No.	Set No.	Milestone	Plan	Revision
23-0563	01	SWC	404	G

WORKS AS EXECUTED

WORKS AS EXECUTED INFORMATION SHOWN IN RED.
DATE: 07/02/2025

REGISTERED SURVEYOR ID: 8890
ORION GROUP

NOTE:

- KERB RETURNS ARE SET OUT TO THE LIP OF GUTTER.
- FOR KERB RETURN LOCALITY PLAN REFER TO SHEET SWC 400.

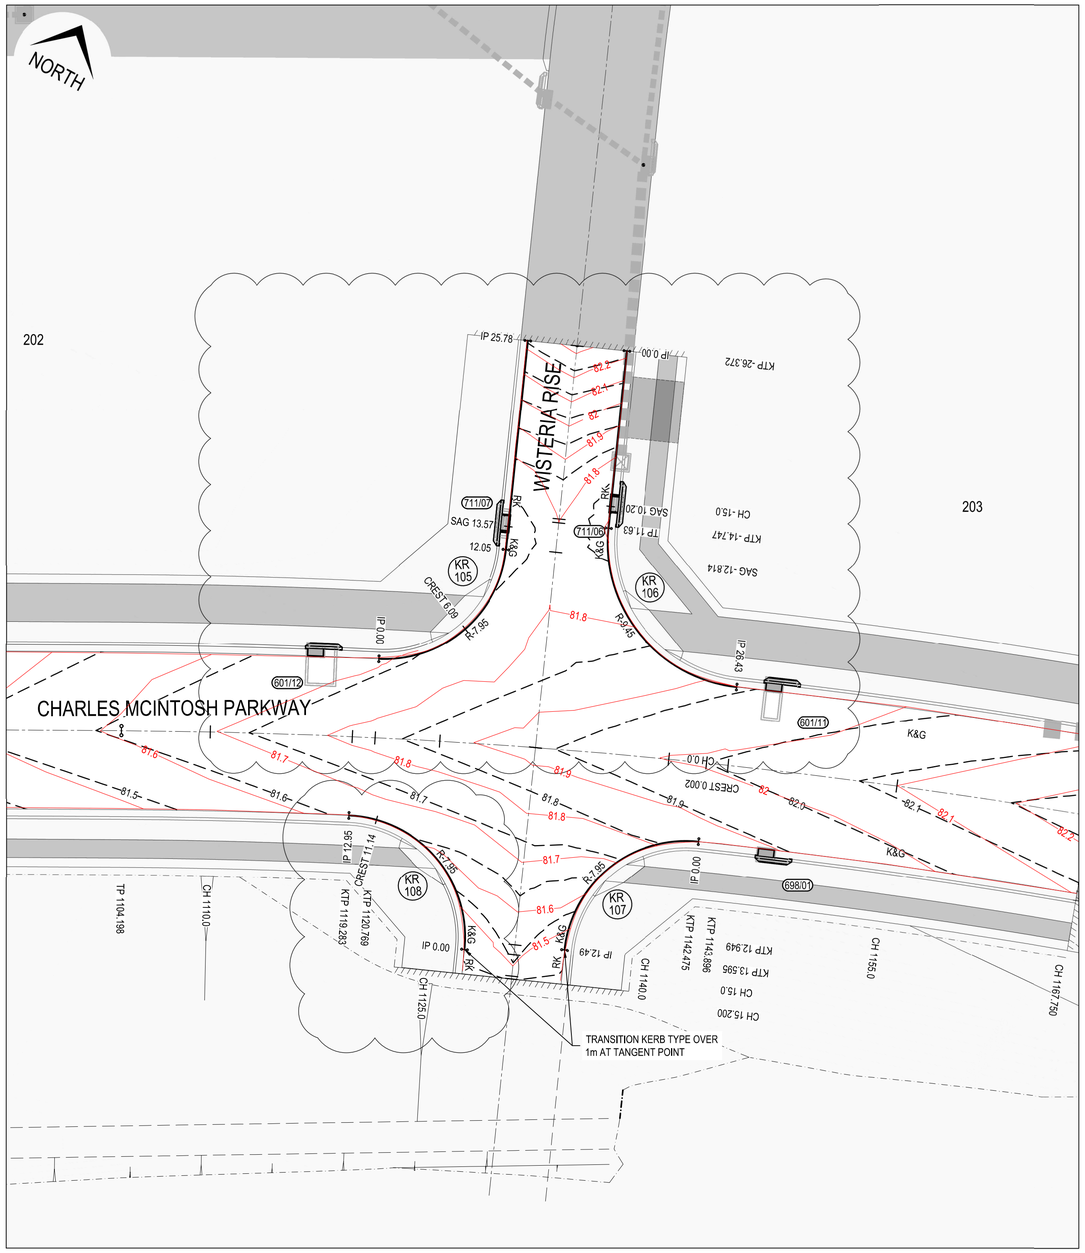

KERB RETURN PLAN - KR 105, 106, 107 &108

SCALE 1:200

CAMDEN COUNCIL
Approved by the Council of Camden under the provisions of the Environment Planning and Assessment Act 1979
APPROVAL

22/03/2024

SUBDIVISION WORKS CERTIFICATE

DA/2023/215/1 SWC.16.2023.215.1

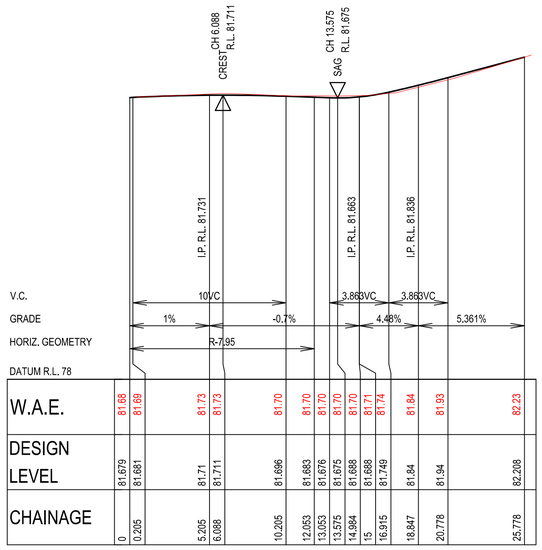

KERB RETURN KR 105

SCALE 1:200 (H)
SCALE 1:40 (V)

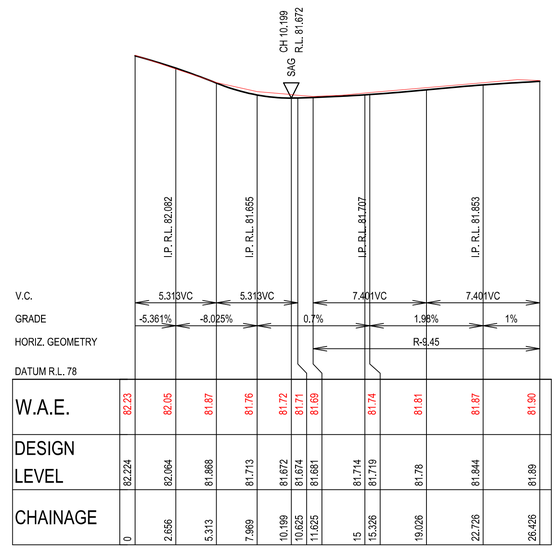

KERB RETURN KR 106

SCALE 1:200 (H)
SCALE 1:40 (V)

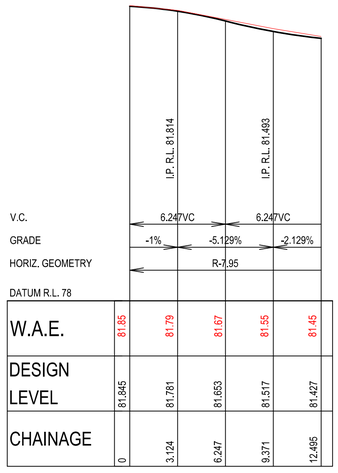

KERB RETURN KR 107

SCALE 1:200 (H)
SCALE 1:40 (V)

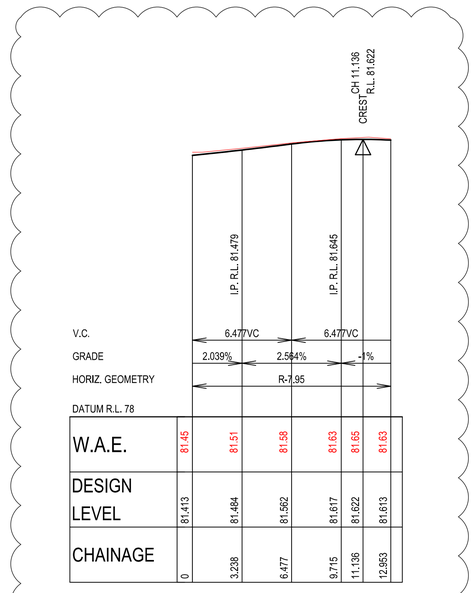

KERB RETURN KR 108

SCALE 1:200 (H)
SCALE 1:40 (V)

ISSUED FOR SUBDIVISION WORKS CERTIFICATE

Rev	Drawn	Design	Check	Appd.	Date	Revision Description
G	RL/WP	LMc	AP	AP	20/03/2024	ISSUED FOR SUBDIVISION WORKS CERTIFICATE
F	WP	LMc	AP	AP	07/03/2024	ISSUED FOR SUBDIVISION WORKS CERTIFICATE
E	WP	LMc	AP	AP	27/02/2024	ISSUED FOR SUBDIVISION WORKS CERTIFICATE
D	RL	LMc	AP	AP	07/02/2024	ISSUED FOR SUBDIVISION WORKS CERTIFICATE
C	RL	LMc	AP	AP	23/01/2024	ISSUED FOR SUBDIVISION WORKS CERTIFICATE
B	RL	LMc	MP	AP	01/12/2023	ISSUED FOR SUBDIVISION WORKS CERTIFICATE
A	RL	LM/YK	MP	AP	27/11/2023	ISSUED FOR SUBDIVISION WORKS CERTIFICATE

Disclaimer and Copyright:
ALL DIMENSIONS TO BE CHECKED ON SITE BY THE CONTRACTOR PRIOR TO CONSTRUCTION.
USE WRITTEN DIMENSIONS ONLY, DO NOT SCALE.
THESE DRAWINGS, PLANS, AND SPECIFICATIONS AND THE COPYRIGHT ARE THE PROPERTY OF ORION CONSULTING ENGINEERS PTY LTD AND MUST NOT BE REPRODUCED OR COPIED WHOLLY OR IN PART WITHOUT THE PERMISSION OF ORION CONSULTING ENGINEERS PTY LTD

Scale:
0 0.4 0.8 1.2 1.6 2 2.4 2.8 3.2 3.6 4
SCALE 1:40 (A1) SCALE 1:80 (A3)
0 2.0 4.0 6.0 8.0 10.0 12.0 14.0 16.0 18.0 20.0
SCALE 1:200 (A1) SCALE 1:400 (A3)

For: mirvac

By: ORION
ABN:25 604 069 981 PO Box:7936, BAULKHAM HILLS NSW 2153 T:(02) 8660 0035 E:info@theoriongroup.au

Project:
589, 591 & 593 COBBITTY ROAD, COBBITTY
(TRANCHE 4, STAGE 3a.)
ROAD & DRAINAGE DESIGN

Title:
KERB RETURN SETOUT PLANS & PROFILES SHEET 05

Project No.	Set No.	Milestone	Plan	Revision
23-0563	01	SWC	405	G

NORTH

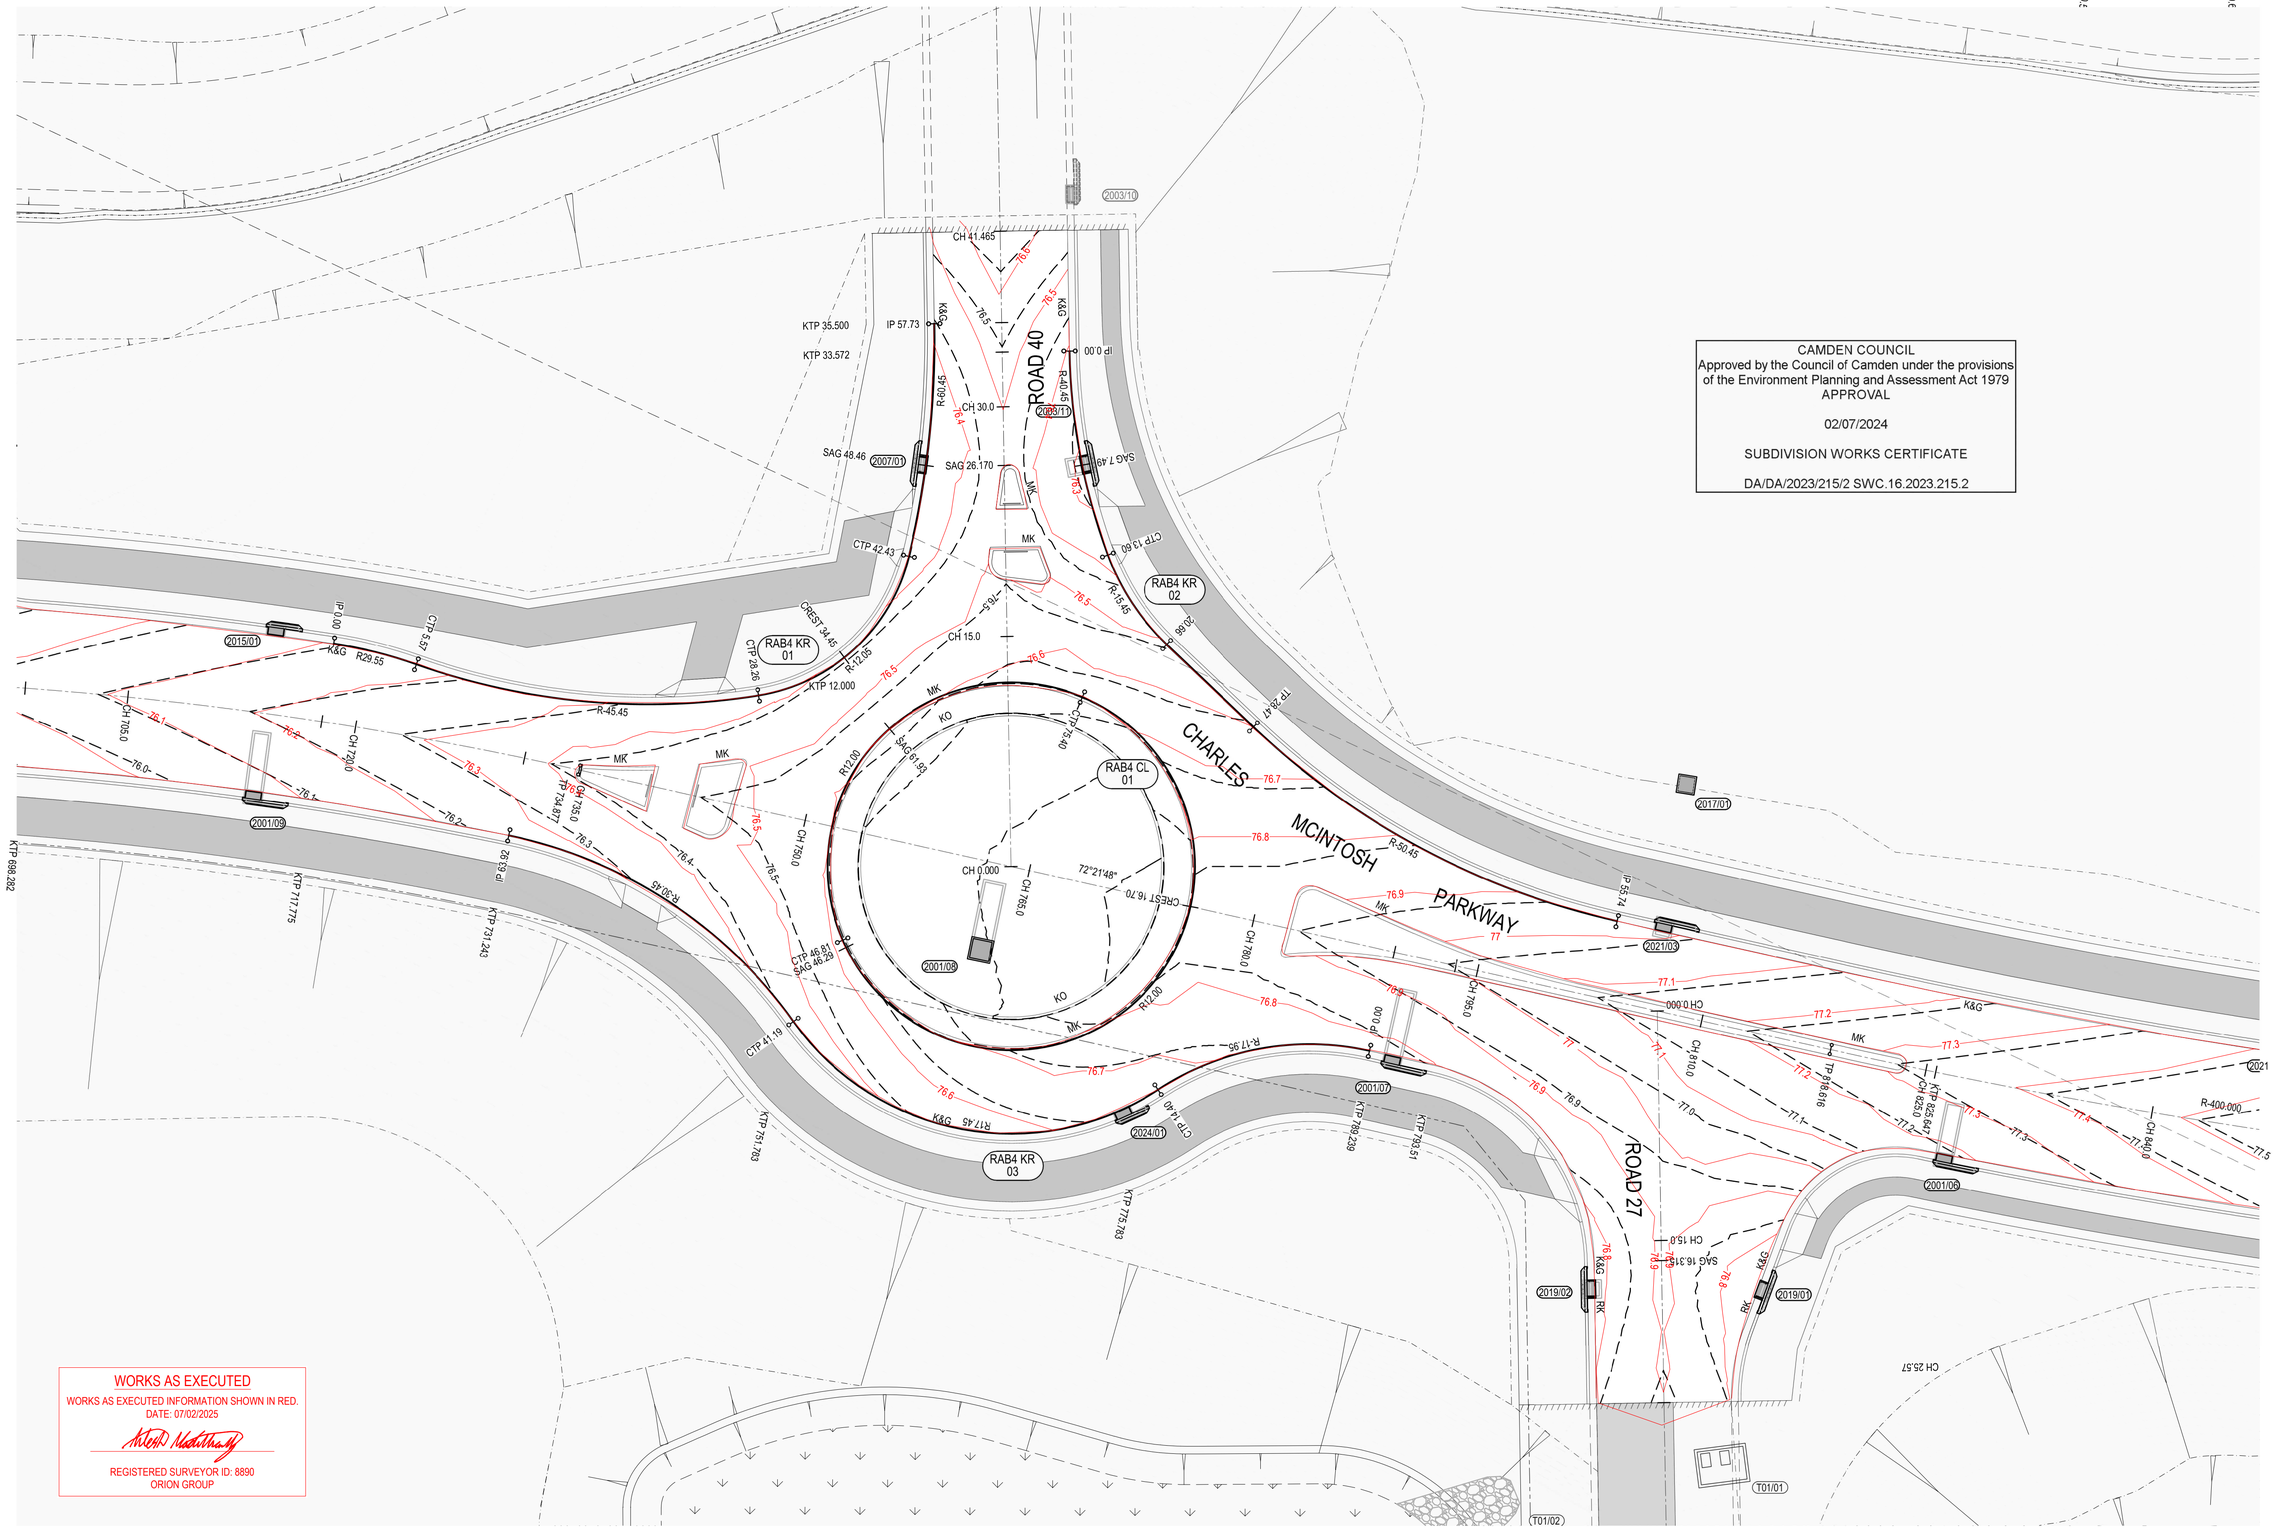

CAMDEN COUNCIL
Approved by the Council of Camden under the provisions of the Environment Planning and Assessment Act 1979
APPROVAL

02/07/2024

SUBDIVISION WORKS CERTIFICATE

DA/DA/2023/215/2 SWC.16.2023.215.2

WORKS AS EXECUTED

WORKS AS EXECUTED INFORMATION SHOWN IN RED.
DATE: 07/02/2025

REGISTERED SURVEYOR ID: 8890
ORION GROUP

ISSUED FOR **SUBDIVISION WORKS CERTIFICATE**

Rev	Drawn	Design	Check	Appd.	Date	Revision Description
B	WP	LMc	AP	AP	19/06/2024	RE-ISSUED FOR SWC MOD APPROVAL
A	RL	LMc	AP	AP	24/05/2024	ISSUED FOR SWC MOD APPROVAL

Disclaimer and Copyright:
ALL DIMENSIONS TO BE CHECKED ON SITE BY THE CONTRACTOR PRIOR TO CONSTRUCTION.
USE WRITTEN DIMENSIONS ONLY, DO NOT SCALE.
THESE DRAWINGS, PLANS, AND SPECIFICATIONS AND THE COPYRIGHT ARE THE PROPERTY OF ORION CONSULTING ENGINEERS PTY LTD AND MUST NOT BE REPRODUCED OR COPIED WHOLLY OR IN PART WITHOUT THE PERMISSION OF ORION CONSULTING ENGINEERS PTY LTD

Scale:
0 2.0 4.0 6.0 8.0 10.0 12.0 14.0 16.0 18.0 20.0
SCALE 1:200 (A1) SCALE 1:400 (A3)

For: mirvac

By: ORION
ABN:25 604 069 981 **PO Box:**7936, BAULKHAM HILLS NSW 2153 **T:**(02) 8660 0035 **E:**info@theoriongroup.au

Project:
589, 591 & 593 COBBITTY ROAD, COBBITTY
(TRANCHE 4, STAGE 3a.)
ROAD & DRAINAGE DESIGN

Title: ROUNDABOUT SPLITTER ISLAND PLAN

Project No.	Set No.	Milestone	Plan	Revision
23-0563	02	MOD	410	B

CAMDEN COUNCIL
Approved by the Council of Camden under the provisions of the Environment Planning and Assessment Act 1979
APPROVAL

02/07/2024

SUBDIVISION WORKS CERTIFICATE

DA/DA/2023/215/2 SWC.16.2023.215.2

WORKS AS EXECUTED
WORKS AS EXECUTED INFORMATION SHOWN IN RED.
DATE: 07/02/2025
REGISTERED SURVEYOR ID: 8890
ORION GROUP

NOTE:
- KERB RETURNS ARE SET OUT TO THE LIP OF GUTTER.
- MOUNTABLE KERBS ARE SET OUT TO THE NOMINAL KERB LINE.
- FOR RAB4 KR SETOUT PLAN REFER TO SHEET SWC 410.

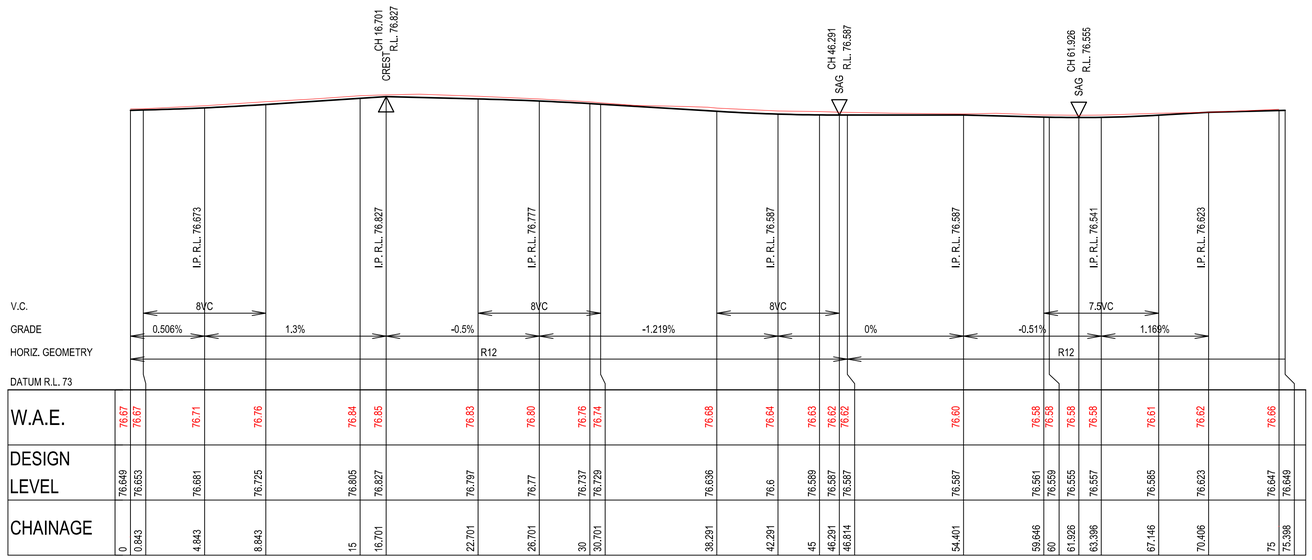

KERB RETURN RAB4 CL01
SCALE 1:200 (H)
SCALE 1:40 (V)

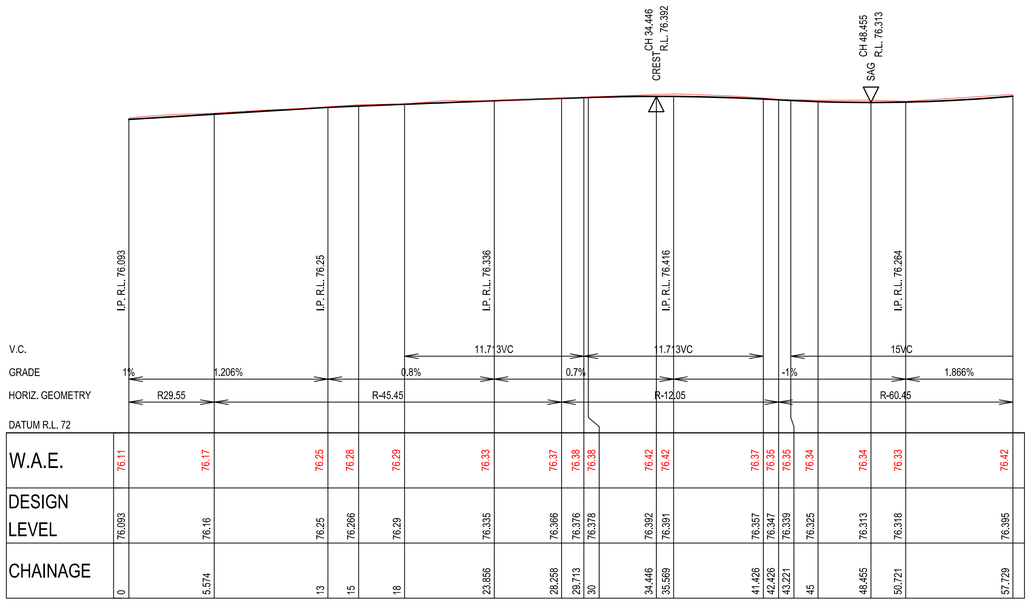

KERB RETURN RAB4 KR01
SCALE 1:200 (H)
SCALE 1:40 (V)

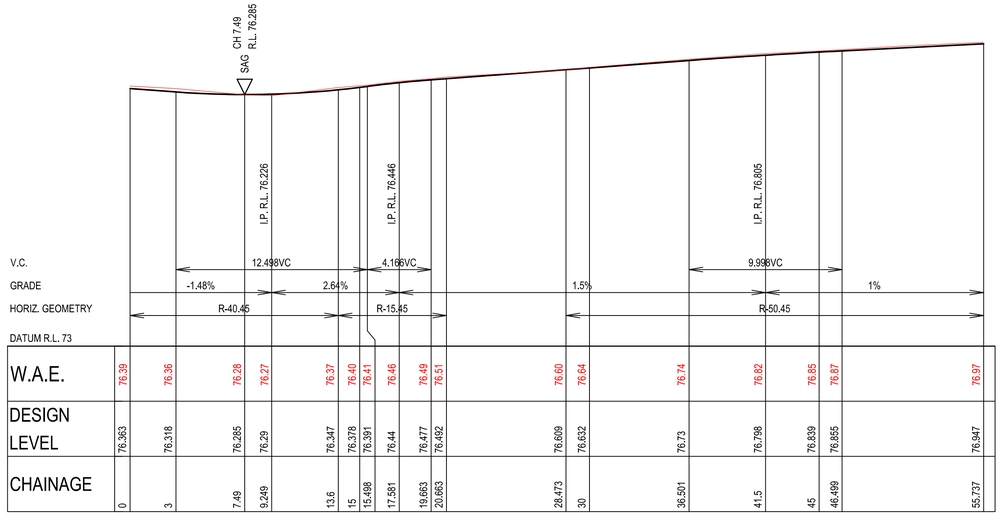

KERB RETURN RAB4 KR02
SCALE 1:200 (H)
SCALE 1:40 (V)

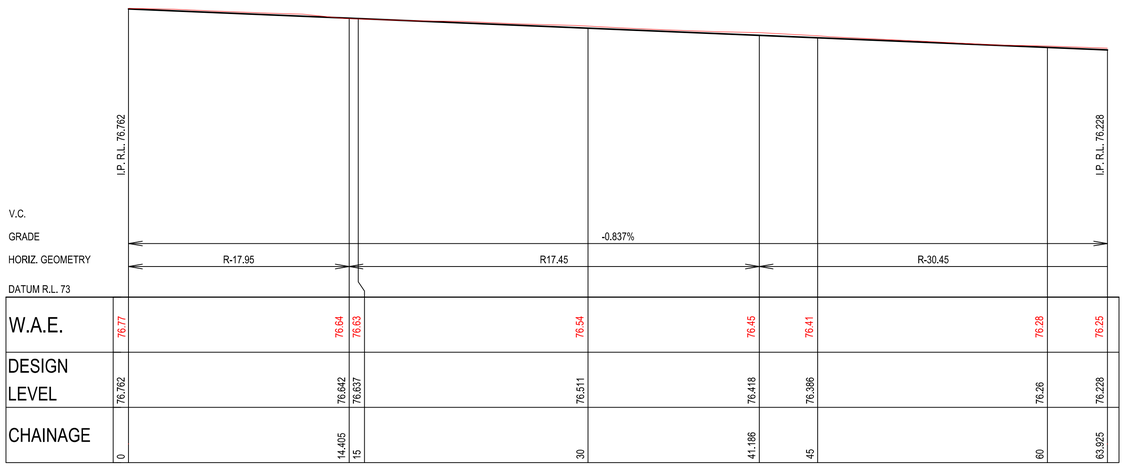

KERB RETURN RAB4 KR03
SCALE 1:200 (H)
SCALE 1:40 (V)

ISSUED FOR SUBDIVISION WORKS CERTIFICATE

Rev	Drawn	Design	Check	Appd.	Date	Revision Description
B	WP	LMc	AP	AP	19/06/2024	RE-ISSUED FOR SWC MOD APPROVAL
A	RL	LMc	AP	AP	24/05/2024	ISSUED FOR SWC MOD APPROVAL

Disclaimer and Copyright:
ALL DIMENSIONS TO BE CHECKED ON SITE BY THE CONTRACTOR PRIOR TO CONSTRUCTION.
USE WRITTEN DIMENSIONS ONLY, DO NOT SCALE.
THESE DRAWINGS, PLANS, AND SPECIFICATIONS AND THE COPYRIGHT ARE THE PROPERTY OF ORION CONSULTING ENGINEERS PTY LTD AND MUST NOT BE REPRODUCED OR COPIED WHOLLY OR IN PART WITHOUT THE PERMISSION OF ORION CONSULTING ENGINEERS PTY LTD

Scale:
0 0.4 0.8 1.2 1.6 2 2.4 2.8 3.2 3.6 4
SCALE 1:40 (A1) SCALE 1:80 (A3)
0 2.0 4.0 6.0 8.0 10.0 12.0 14.0 16.0 18.0 20.0
SCALE 1:200 (A1) SCALE 1:400 (A3)

For: mirvac

By: ORION
ABN:25 604 069 981 PO Box:7936, BAULKHAM HILLS NSW 2153 T:(02) 8660 0035 E:info@theoriongroup.au

Project: 589, 591 & 593 COBBITTY ROAD, COBBITTY (TRANCHE 4, STAGE 3a.) ROAD & DRAINAGE DESIGN

Title: ROUNDABOUT SPLITTER ISLAND PROFILES

Project No.	Set No.	Milestone	Plan	Revision
23-0563	02	MOD	411	B

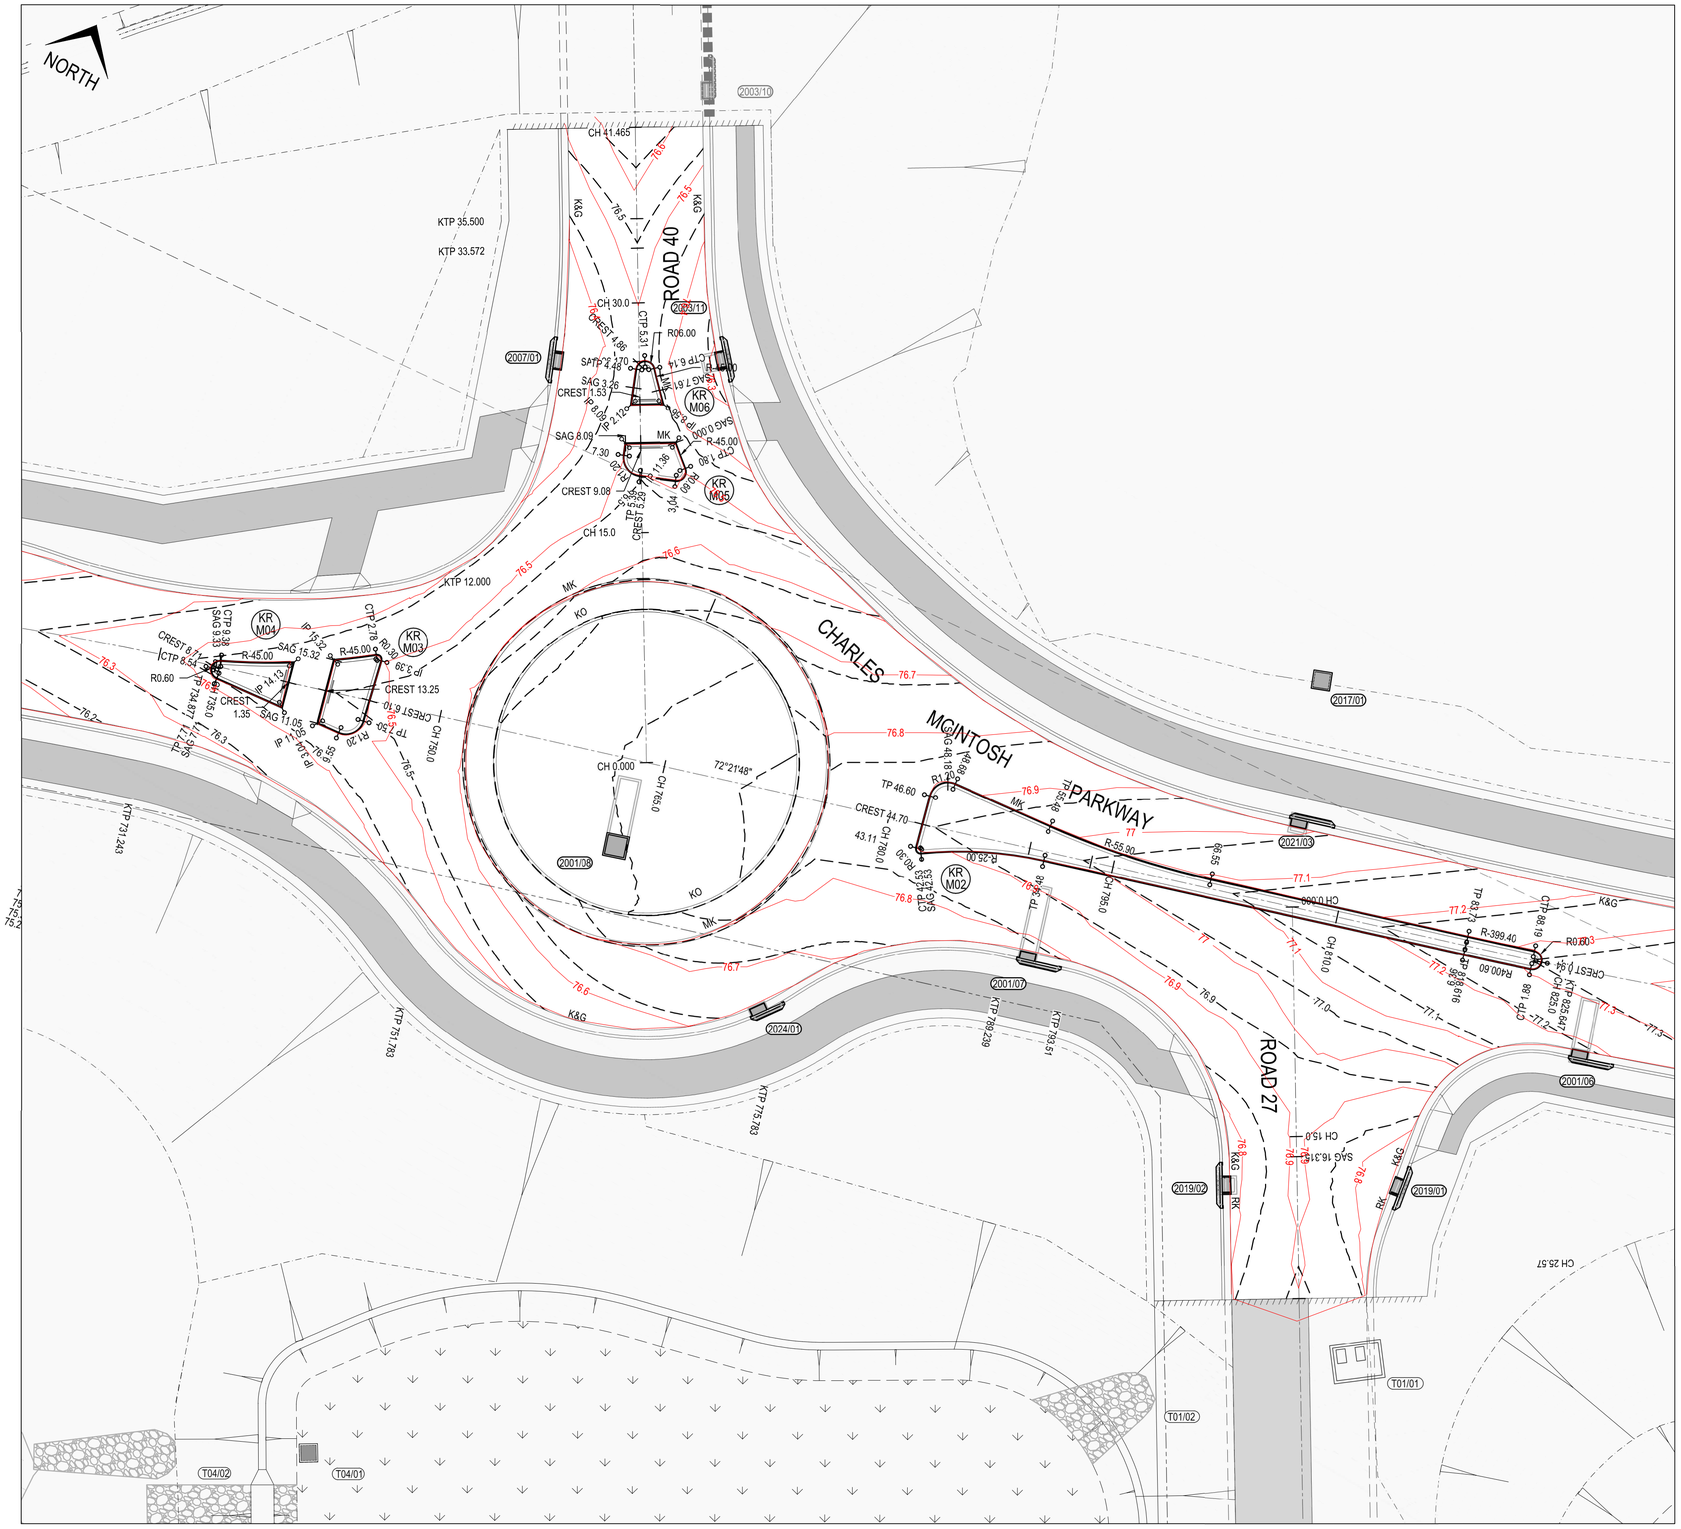

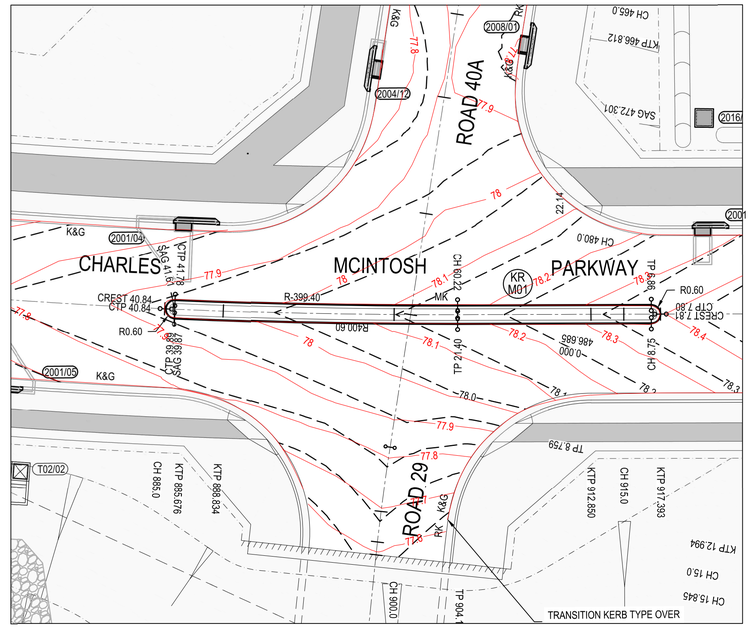

KERB RETURN M01 - PLAN VIEW

SCALE 1:200

CAMDEN COUNCIL
Approved by the Council of Camden under the provisions of the Environment Planning and Assessment Act 1979
APPROVAL

02/07/2024

SUBDIVISION WORKS CERTIFICATE

DA/DA/2023/215/2 SWC.16.2023.215.2

WORKS AS EXECUTED
WORKS AS EXECUTED INFORMATION SHOWN IN RED.
DATE: 07/02/2025

REGISTERED SURVEYOR ID: 8890
ORION GROUP

ISSUED FOR **SUBDIVISION WORKS CERTIFICATE**

Rev	Drawn	Design	Check	Appd.	Date	Revision Description
B	WP	LMc	AP	AP	19/06/2024	RE-ISSUED FOR SWC MOD APPROVAL
A	RL	LMc	AP	AP	24/05/2024	ISSUED FOR SWC MOD APPROVAL

Disclaimer and Copyright:
ALL DIMENSIONS TO BE CHECKED ON SITE BY THE CONTRACTOR PRIOR TO CONSTRUCTION.
USE WRITTEN DIMENSIONS ONLY, DO NOT SCALE.
THESE DRAWINGS, PLANS, AND SPECIFICATIONS AND THE COPYRIGHT ARE THE PROPERTY OF ORION CONSULTING ENGINEERS PTY LTD AND MUST NOT BE REPRODUCED OR COPIED WHOLLY OR IN PART WITHOUT THE PERMISSION OF ORION CONSULTING ENGINEERS PTY LTD

Scale:
0 2.0 4.0 6.0 8.0 10.0 12.0 14.0 16.0 18.0 20.0
SCALE 1:200 (A1) SCALE 1:400 (A3)

For: mirvac

By: ORION

ABN:25 604 069 981 **PO Box:**7936, BAULKHAM HILLS NSW 2153 **T:**(02) 8660 0035 **E:**info@theoriongroup.au

Project:
589, 591 & 593 COBBITTY ROAD, COBBITTY
(TRANCHE 4, STAGE 3a.)
ROAD & DRAINAGE DESIGN

Title: SPLITTER ISLAND PLAN

Project No.	Set No.	Milestone	Plan	Revision
23-0563	02	MOD	420	B

CAMDEN COUNCIL
Approved by the Council of Camden under the provisions of the Environment Planning and Assessment Act 1979
APPROVAL

22/03/2024

SUBDIVISION WORKS CERTIFICATE

DA/2023/215/1 SWC.16.2023.215.1

WORKS AS EXECUTED
WORKS AS EXECUTED INFORMATION SHOWN IN RED.
DATE: 07/02/2025
REGISTERED SURVEYOR ID: 8890
ORION GROUP

NOTE:
- MOUNTABLE KERBS ARE SET OUT TO THE NOMINAL KERB LINE.

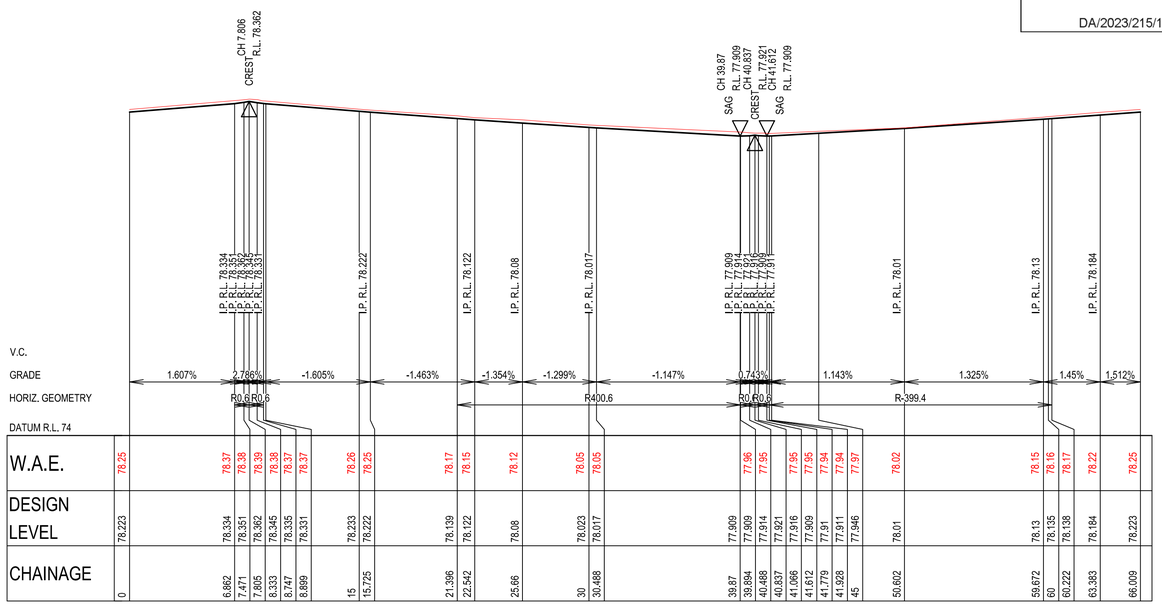

| | | |

CAMDEN COUNCIL
Approved by the Council of Camden under the provisions of the Environment Planning and Assessment Act 1979
APPROVAL

22/03/2024

SUBDIVISION WORKS CERTIFICATE

DA/2023/215/1 SWC.16.2023.215.1

WORKS AS EXECUTED
WORKS AS EXECUTED INFORMATION SHOWN IN RED.
DATE: 07/02/2025

REGISTERED SURVEYOR ID: 8890
ORION GROUP

NOTE:

STORMWATER LONGITUDINAL SECTIONS REFLECT ULTIMATE PIT AND PIPE NETWORK. HYDROLOGY DOCUMENTED IS BASED ON ULTIMATE STORM EVENT = 5 YEAR ARI

LEGEND

- EXISTING SURFACE
- DESIGN SURFACE
- INTERIM SURFACE
- 5yr HGL
- 100yr HGL
- DESIGN PIPE AND PIT
- DESIGN TEMPORARY PIPE AND PIT
- EXISTING PIPE AND PIT
- FUTURE PIPE AND PIT

G

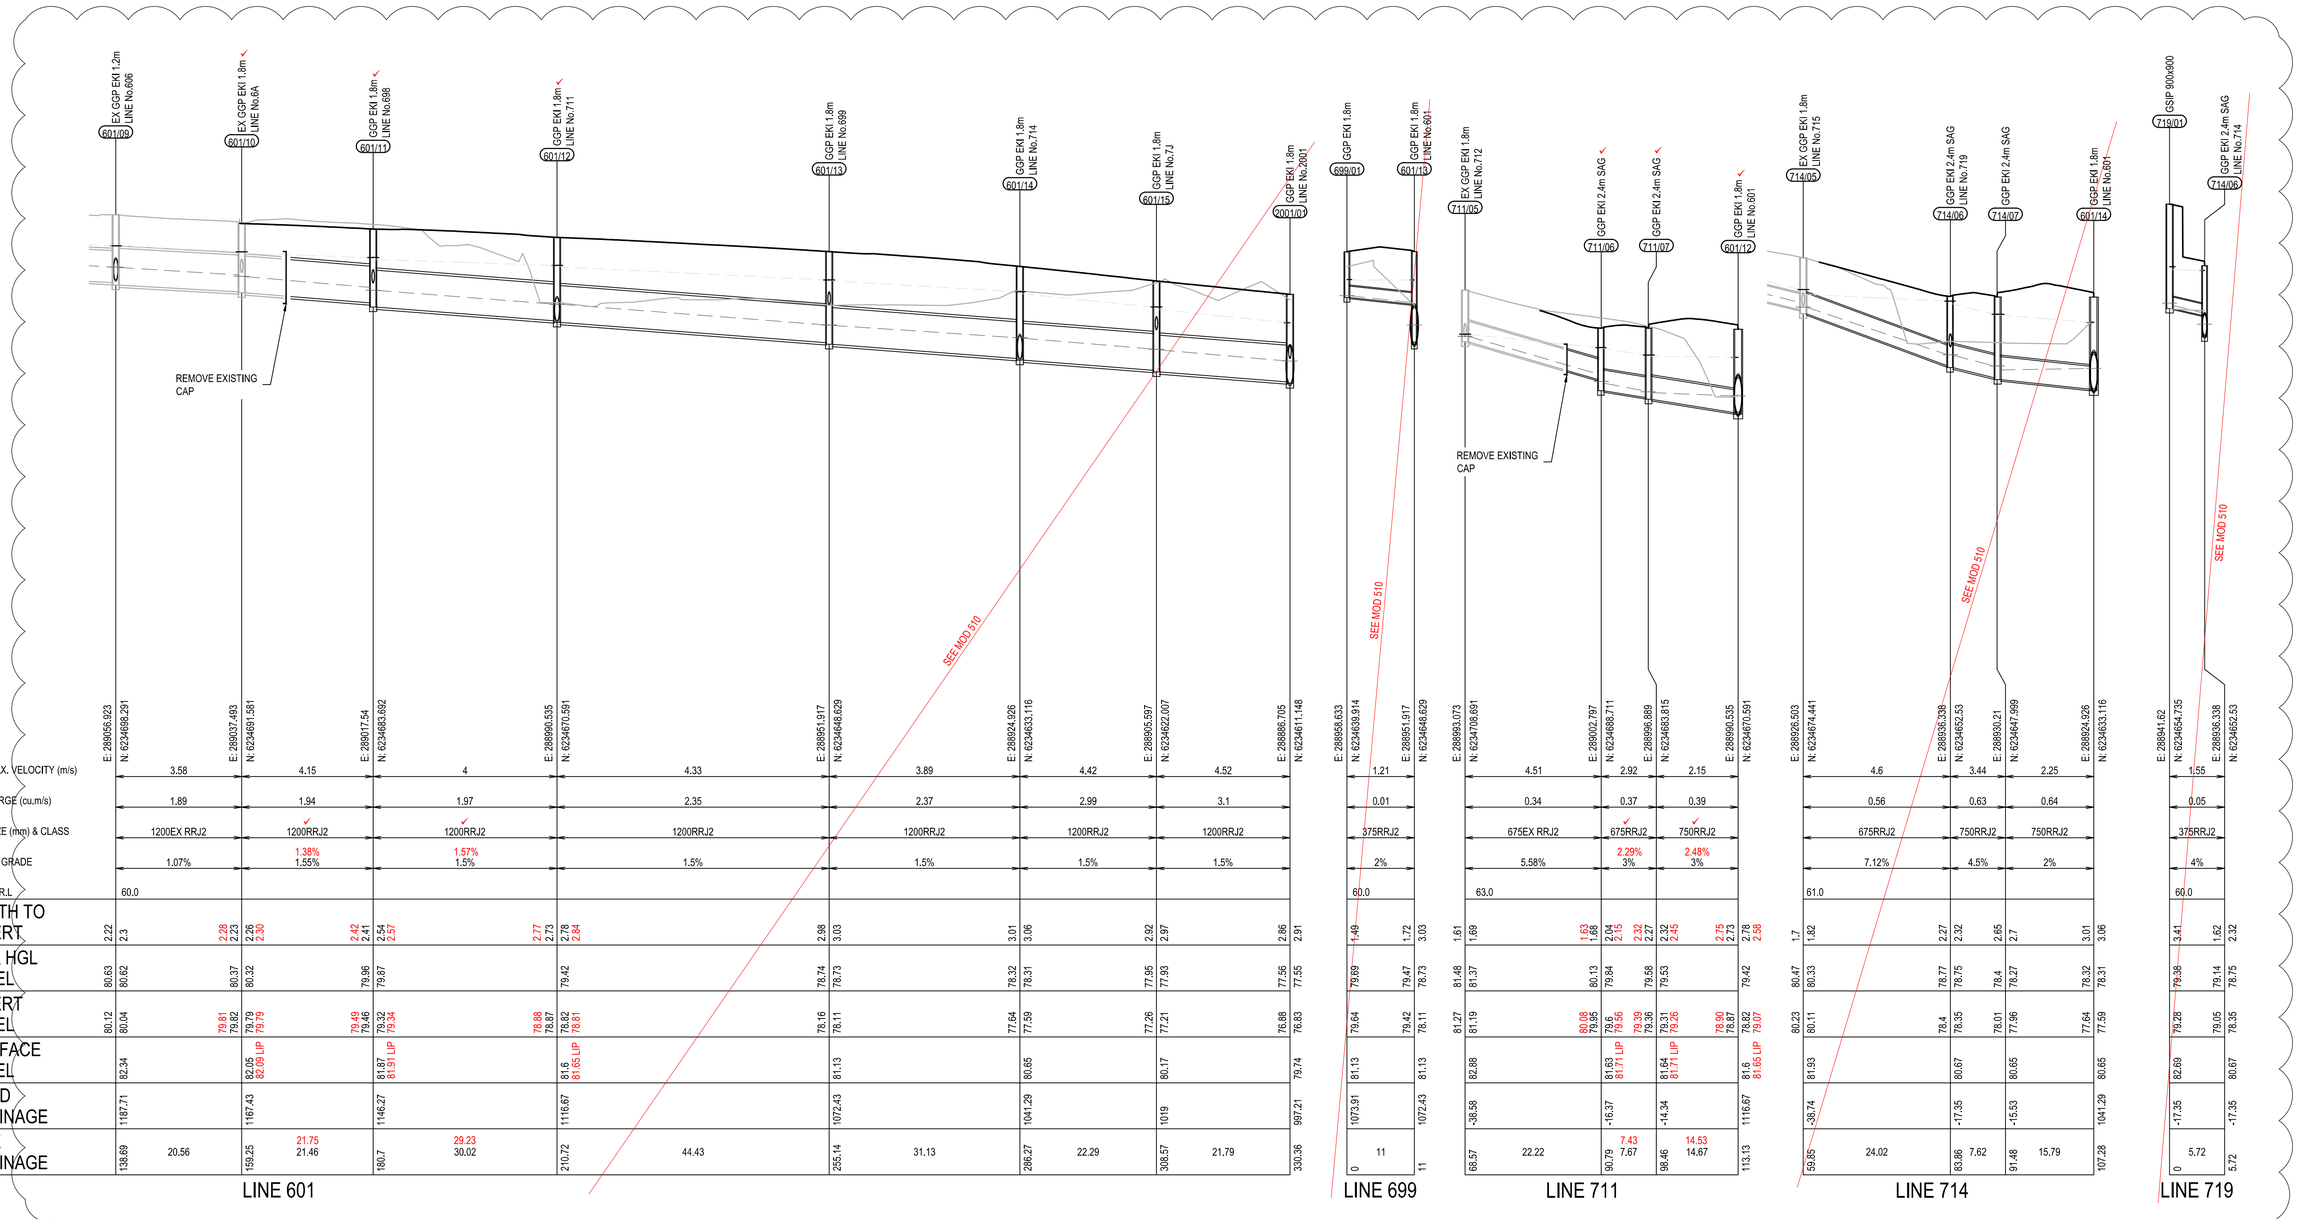

| | | |

CAMDEN COUNCIL
Approved by the Council of Camden under the provisions of the Environment Planning and Assessment Act 1979
APPROVAL

02/07/2024

SUBDIVISION WORKS CERTIFICATE

DA/DA2023/215/2 SWC.16.2023.215.2

WORKS AS EXECUTED

WORKS AS EXECUTED INFORMATION SHOWN IN RED.
DATE: 07/02/2025

REGISTERED SURVEYOR ID: 8890
ORION GROUP

NOTE:

STORMWATER LONGITUDINAL SECTIONS REFLECT ULTIMATE PIT AND PIPE NETWORK. HYDROLOGY DOCUMENTED IS BASED ON ULTIMATE STORM EVENT = 5 YEAR ARI

LEGEND

EXISTING SURFACE	
DESIGN SURFACE	
INTERIM SURFACE	
5yr HGL	
100yr HGL	
DESIGN PIPE AND PIT	
DESIGN TEMPORARY PIPE AND PIT	
EXISTING PIPE AND PIT	
FUTURE PIPE AND PIT	

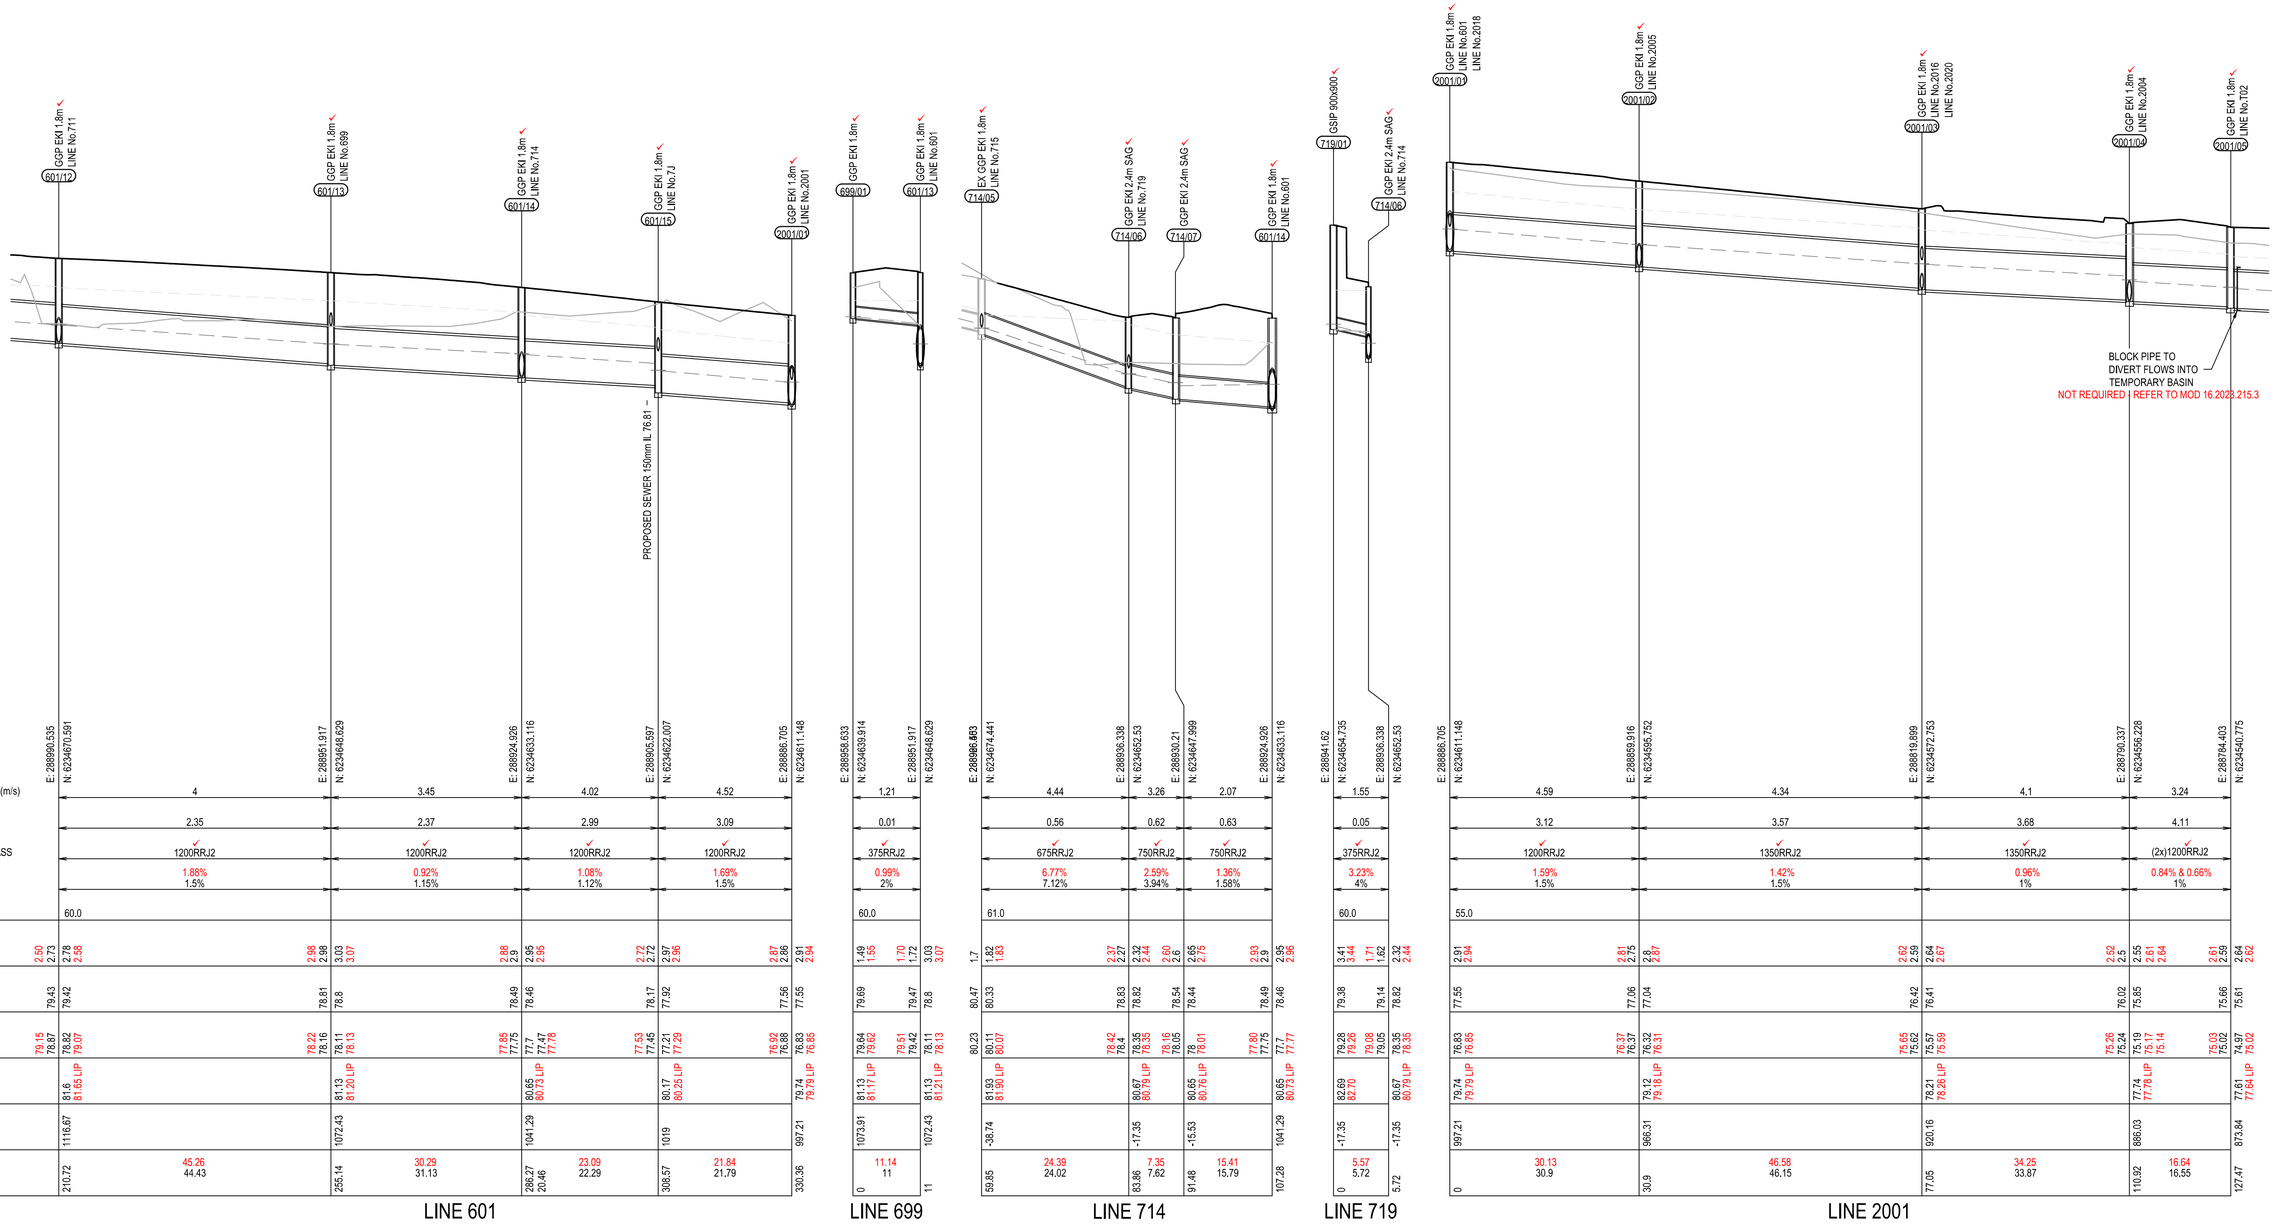

LINE 601

| | | |

CAMDEN COUNCIL
Approved by the Council of Camden under the provisions of the Environment Planning and Assessment Act 1979
APPROVAL

22/03/2024

SUBDIVISION WORKS CERTIFICATE

DA/2023/215/1 SWC.16.2023.215.1

WORKS AS EXECUTED
WORKS AS EXECUTED INFORMATION SHOWN IN RED.
DATE: 07/02/2025

REGISTERED SURVEYOR ID: 8890
ORION GROUP

NOTE:

STORMWATER LONGITUDINAL SECTIONS REFLECT ULTIMATE PIT AND PIPE NETWORK. HYDROLOGY DOCUMENTED IS BASED ON ULTIMATE STORM EVENT = 5 YEAR ARI

LEGEND

- EXISTING SURFACE
- DESIGN SURFACE
- INTERIM SURFACE
- 5yr HGL
- 100yr HGL
- DESIGN PIPE AND PIT
- DESIGN TEMPORARY PIPE AND PIT
- EXISTING PIPE AND PIT
- FUTURE PIPE AND PIT

G

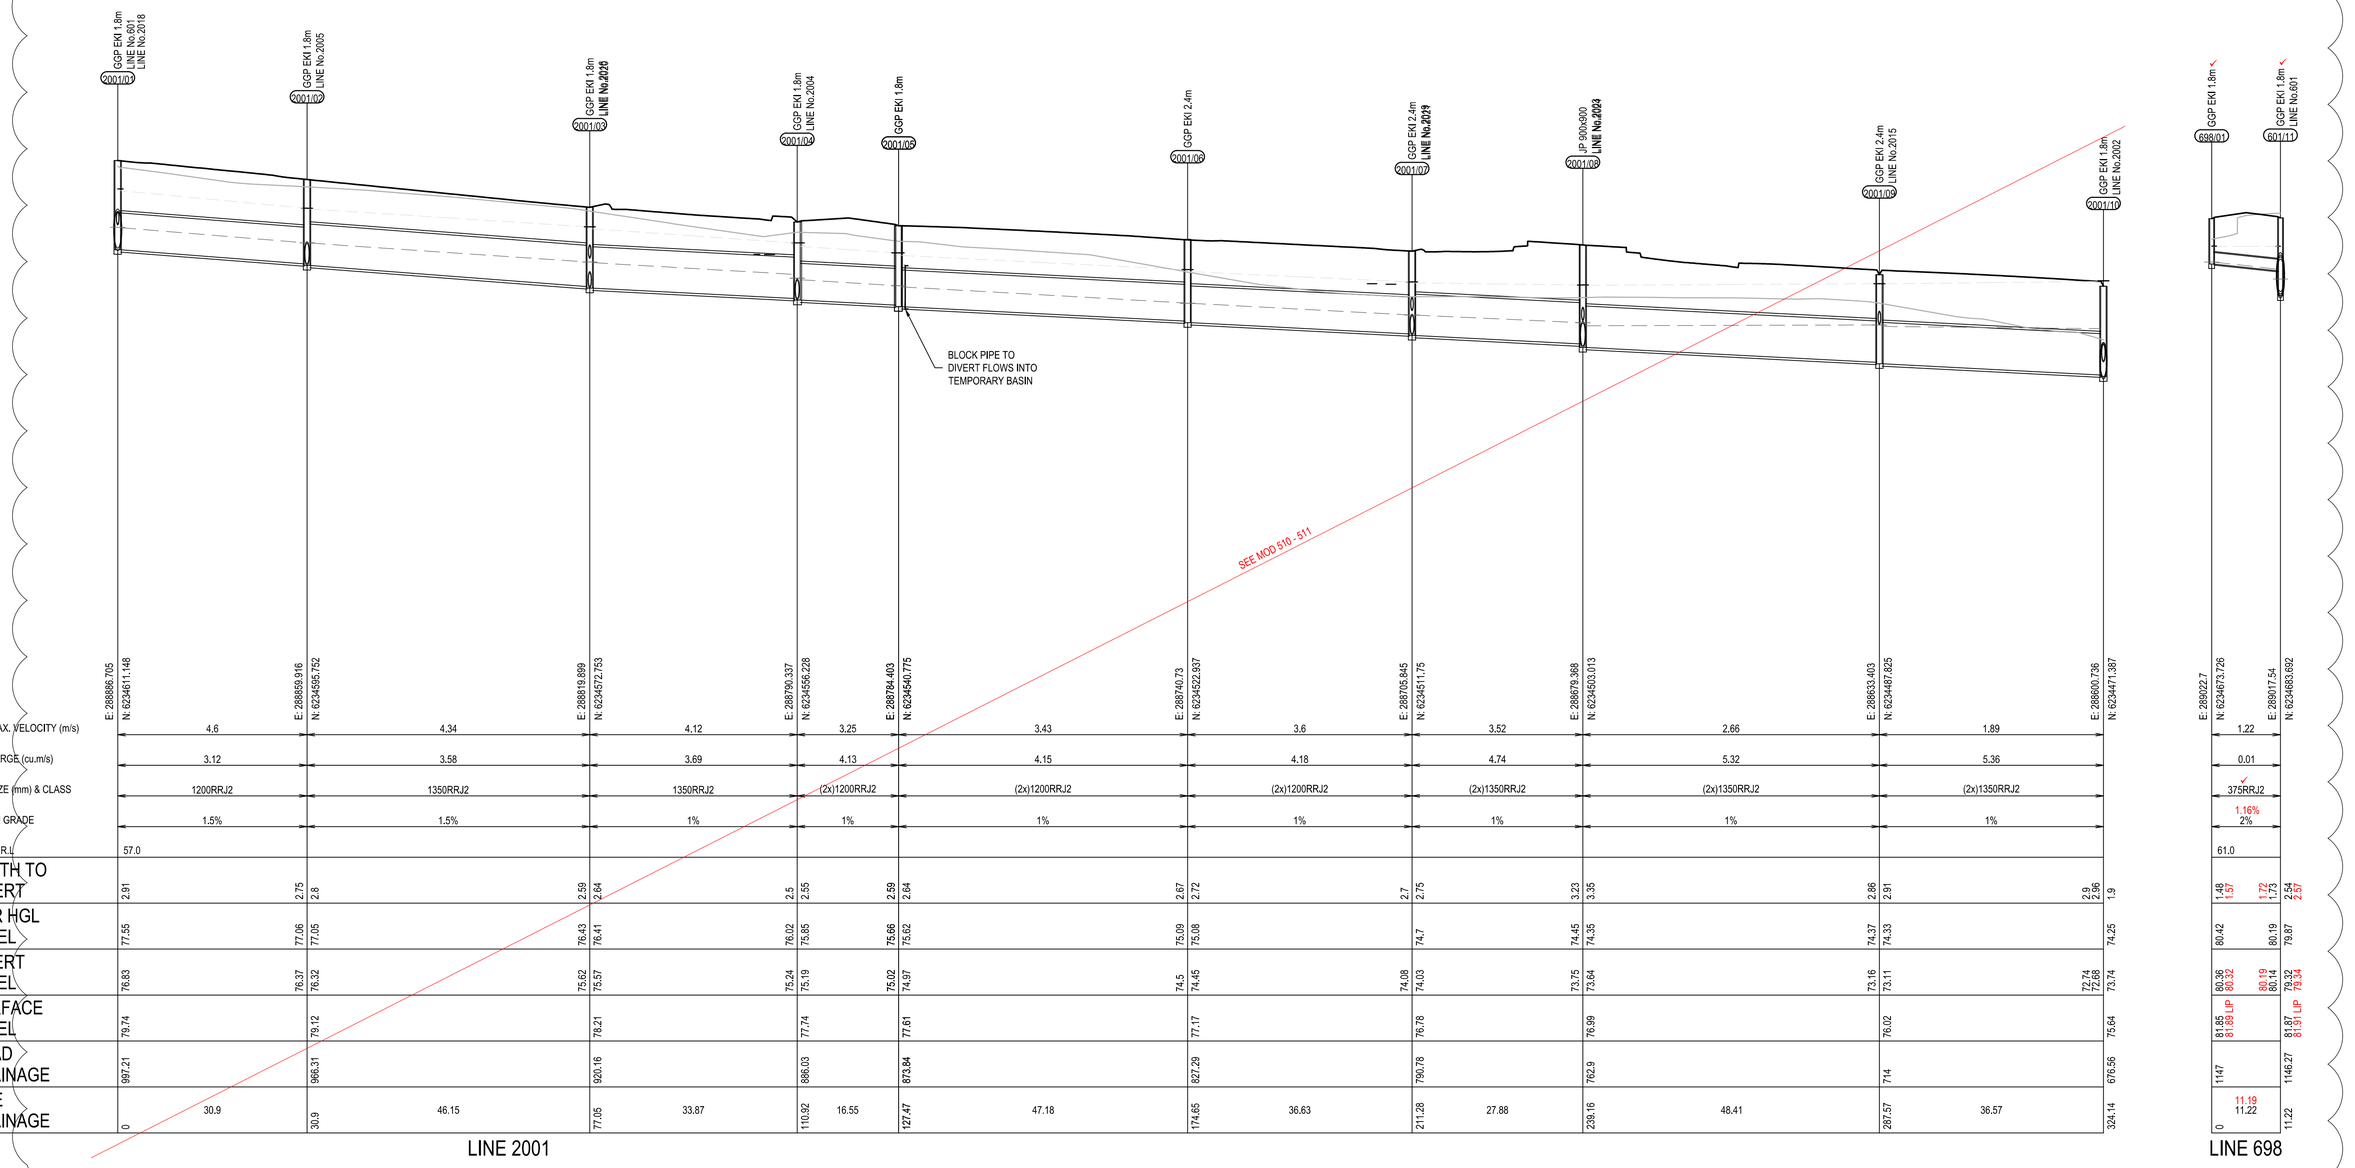

| | | |

CAMDEN COUNCIL
Approved by the Council of Camden under the provisions of the Environment Planning and Assessment Act 1979
APPROVAL

02/07/2024

SUBDIVISION WORKS CERTIFICATE

DA/DA/2023/215/2 SWC.16.2023.215.2

WORKS AS EXECUTED

WORKS AS EXECUTED INFORMATION SHOWN IN RED.
DATE: 07/02/2025

REGISTERED SURVEYOR ID: 8890
ORION GROUP

NOTE:

STORMWATER LONGITUDINAL SECTIONS REFLECT ULTIMATE PIT AND PIPE NETWORK. HYDROLOGY DOCUMENTED IS BASED ON ULTIMATE STORM EVENT = 5 YEAR ARI

LEGEND

- EXISTING SURFACE
- DESIGN SURFACE
- INTERIM SURFACE
- 5yr HGL
- 100yr HGL
- DESIGN PIPE AND PIT
- DESIGN TEMPORARY PIPE AND PIT
- EXISTING PIPE AND PIT
- FUTURE PIPE AND PIT

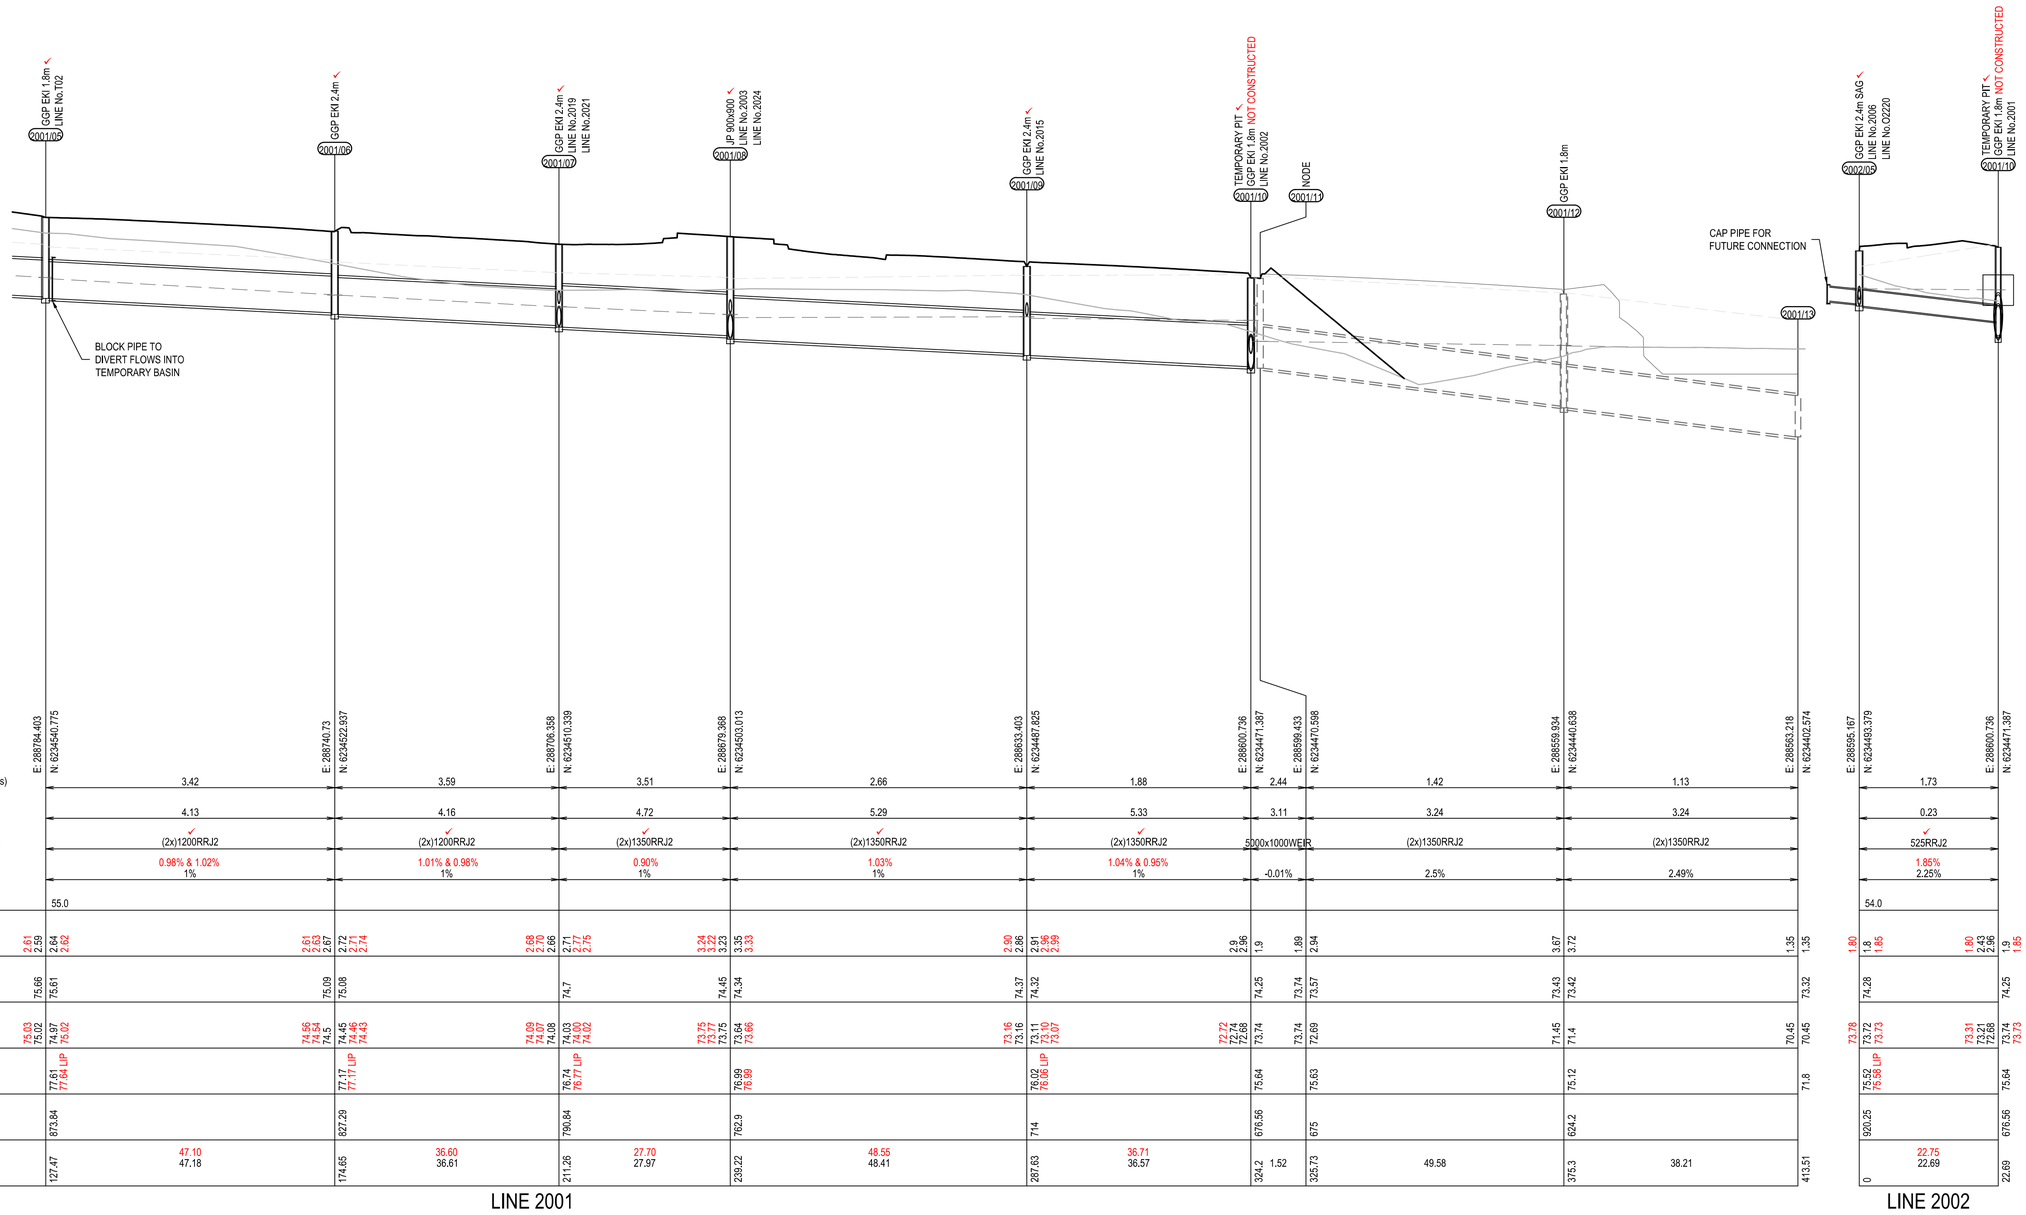

| | | |

CAMDEN COUNCIL
Approved by the Council of Camden under the provisions of the Environment Planning and Assessment Act 1979
APPROVAL

02/07/2024

SUBDIVISION WORKS CERTIFICATE

DA/DA/2023/215/2 SWC.16.2023.215.2

WORKS AS EXECUTED
WORKS AS EXECUTED INFORMATION SHOWN IN RED.
DATE: 07/02/2025

REGISTERED SURVEYOR ID: 8890
ORION GROUP

NOTE:

STORMWATER LONGITUDINAL SECTIONS REFLECT ULTIMATE PIT AND PIPE NETWORK. HYDROLOGY DOCUMENTED IS BASED ON ULTIMATE STORM EVENT = 5 YEAR ARI

LEGEND

- EXISTING SURFACE
- DESIGN SURFACE
- INTERIM SURFACE
- 5yr HGL
- 100yr HGL
- DESIGN PIPE AND PIT
- DESIGN TEMPORARY PIPE AND PIT
- EXISTING PIPE AND PIT
- FUTURE PIPE AND PIT

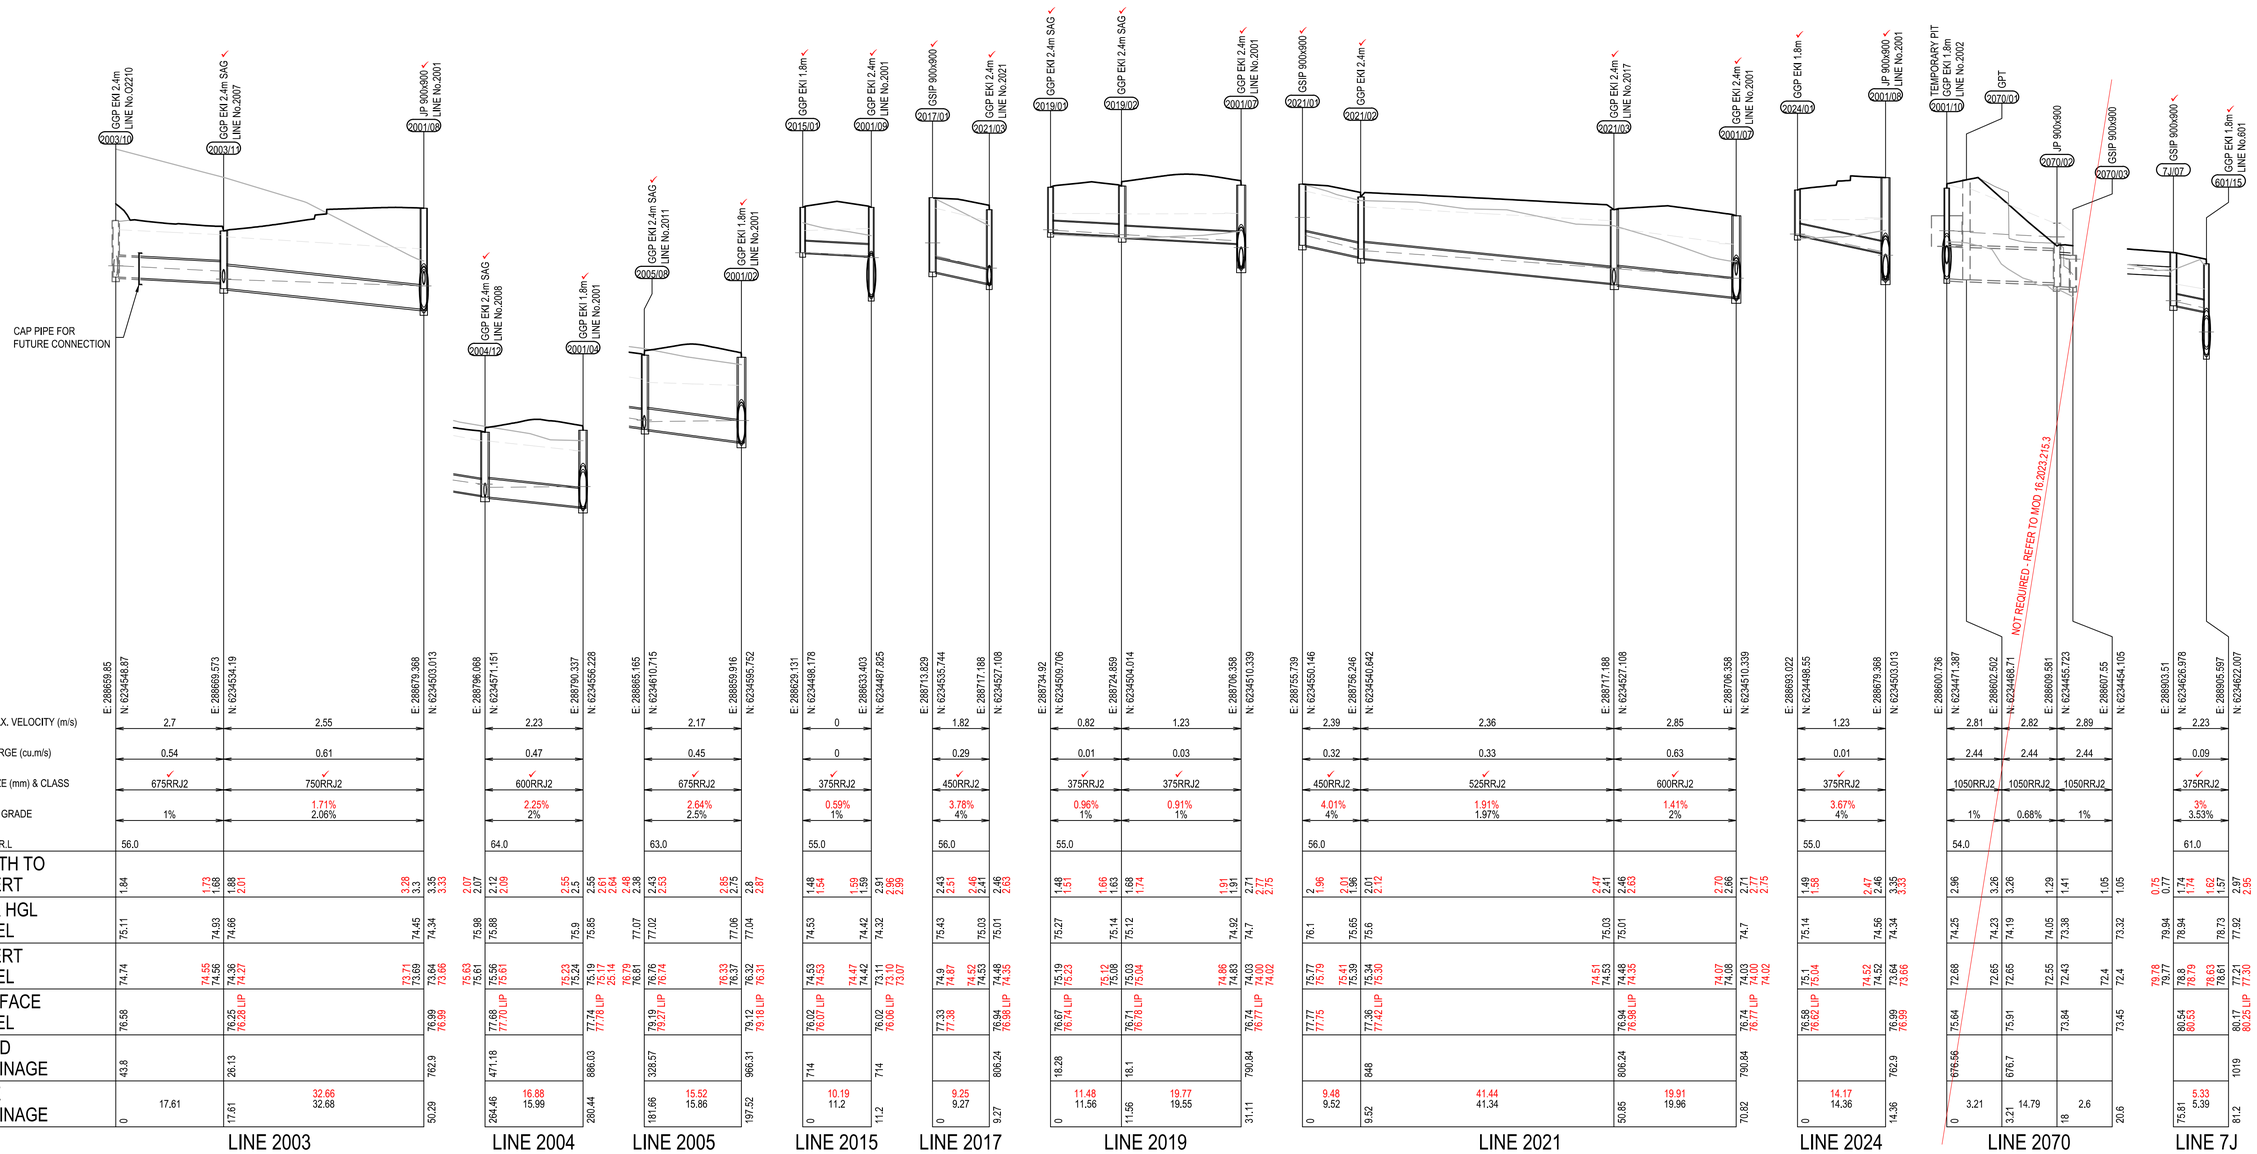

ISSUED FOR SUBDIVISION WORKS CERTIFICATE

Rev	Drawn	Design	Check	Appd.	Date	Revision Description
B	WP	LMc	AP	AP	19/06/2024	RE-ISSUED FOR SWC MOD APPROVAL
A	RL	LMc	AP	AP	24/05/2024	ISSUED FOR SWC MOD APPROVAL

Disclaimer and Copyright:
ALL DIMENSIONS TO BE CHECKED ON SITE BY THE CONTRACTOR PRIOR TO CONSTRUCTION.
USE WRITTEN DIMENSIONS ONLY, DO NOT SCALE.
THESE DRAWINGS, PLANS, AND SPECIFICATIONS AND THE COPYRIGHT ARE THE PROPERTY OF ORION CONSULTING ENGINEERS PTY LTD AND MUST NOT BE REPRODUCED OR COPIED WHOLLY OR IN PART WITHOUT THE PERMISSION OF ORION CONSULTING ENGINEERS PTY LTD

Scale:
0 5 10 15 20 25 30 35 40 45 50
SCALE 1:500 (A1) SCALE 1:1000 (A3)
0 1 2 3 4 5 6 7 8 9 10
SCALE 1:100 (A1) SCALE 1:200 (A3)

For: mirvac

By: ORION

ABN:25 604 069 981 PO Box:7936, BAULKHAM HILLS NSW 2153 T:(02) 8660 0035 E:info@theoriongroup.au

Project:
589, 591 & 593 COBBITTY ROAD, COBBITTY
(TRANCHE 4, STAGE 3a.)
ROAD & DRAINAGE DESIGN

Title:
DRAINAGE LONGITUDINAL SECTIONS
SHEET 03

Project No.	Set No.	Milestone	Plan	Revision
23-0563	02	MOD	512	B

WORKS AS EXECUTED

WORKS AS EXECUTED INFORMATION SHOWN IN RED.
DATE: 07/02/2025

REGISTERED SURVEYOR ID: 8890
ORION GROUP

NOTE:

STORMWATER LONGITUDINAL SECTIONS REFLECT ULTIMATE PIT AND PIPE NETWORK. HYDROLOGY DOCUMENTED IS BASED ON ULTIMATE STORM EVENT = 5 YEAR ARI

LEGEND

EXISTING SURFACE	
DESIGN SURFACE	
INTERIM SURFACE	
5yr HGL	
100yr HGL	
DESIGN PIPE AND PIT	
DESIGN TEMPORARY PIPE AND PIT	
EXISTING PIPE AND PIT	
FUTURE PIPE AND PIT	

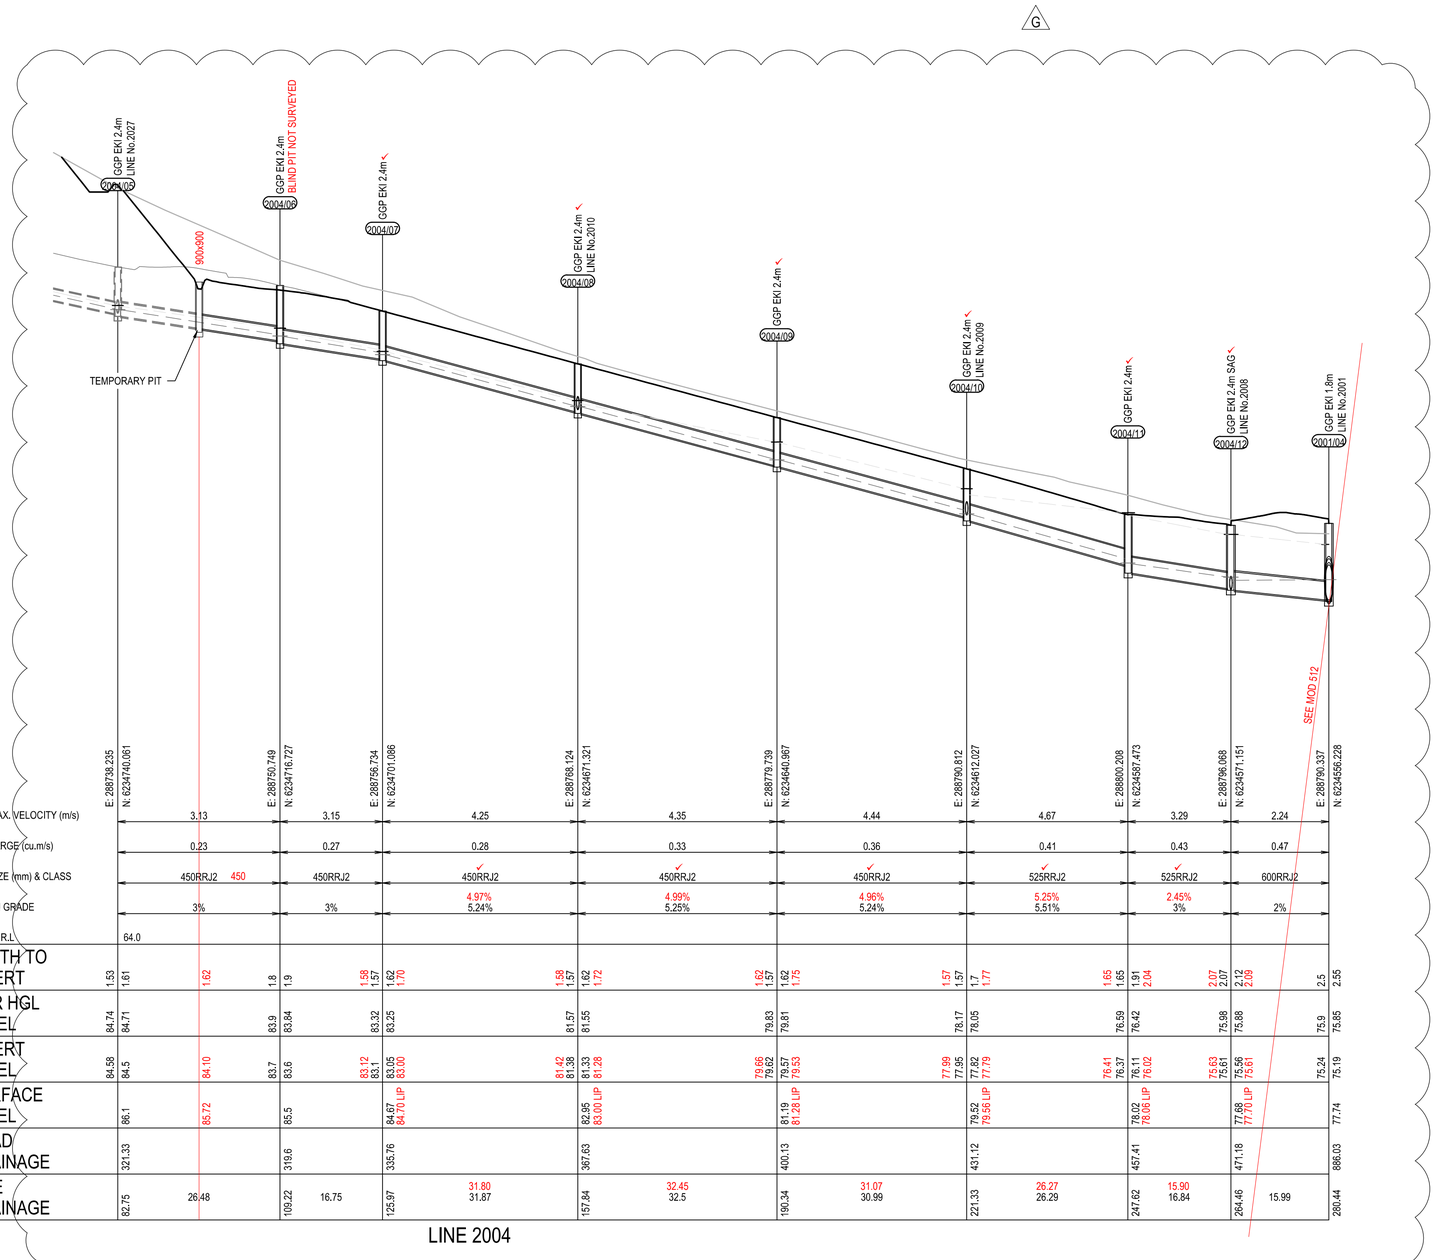

| | | |

WORKS AS EXECUTED

WORKS AS EXECUTED INFORMATION SHOWN IN RED.
DATE: 07/02/2025

REGISTERED SURVEYOR ID: 8890
ORION GROUP

NOTE:

STORMWATER LONGITUDINAL SECTIONS REFLECT ULTIMATE PIT AND PIPE NETWORK. HYDROLOGY DOCUMENTED IS BASED ON ULTIMATE STORM EVENT = 5 YEAR ARI

LEGEND

- EXISTING SURFACE
- DESIGN SURFACE
- INTERIM SURFACE
- 5yr HGL
- 100yr HGL
- DESIGN PIPE AND PIT
- DESIGN TEMPORARY PIPE AND PIT
- EXISTING PIPE AND PIT
- FUTURE PIPE AND PIT

CAMDEN COUNCIL
Approved by the Council of Camden under the provisions
of the Environment Planning and Assessment Act 1979
APPROVAL

03/09/2024

SUBDIVISION WORKS CERTIFICATE

DA/2023/215/2 SWC.16.2023.215.3

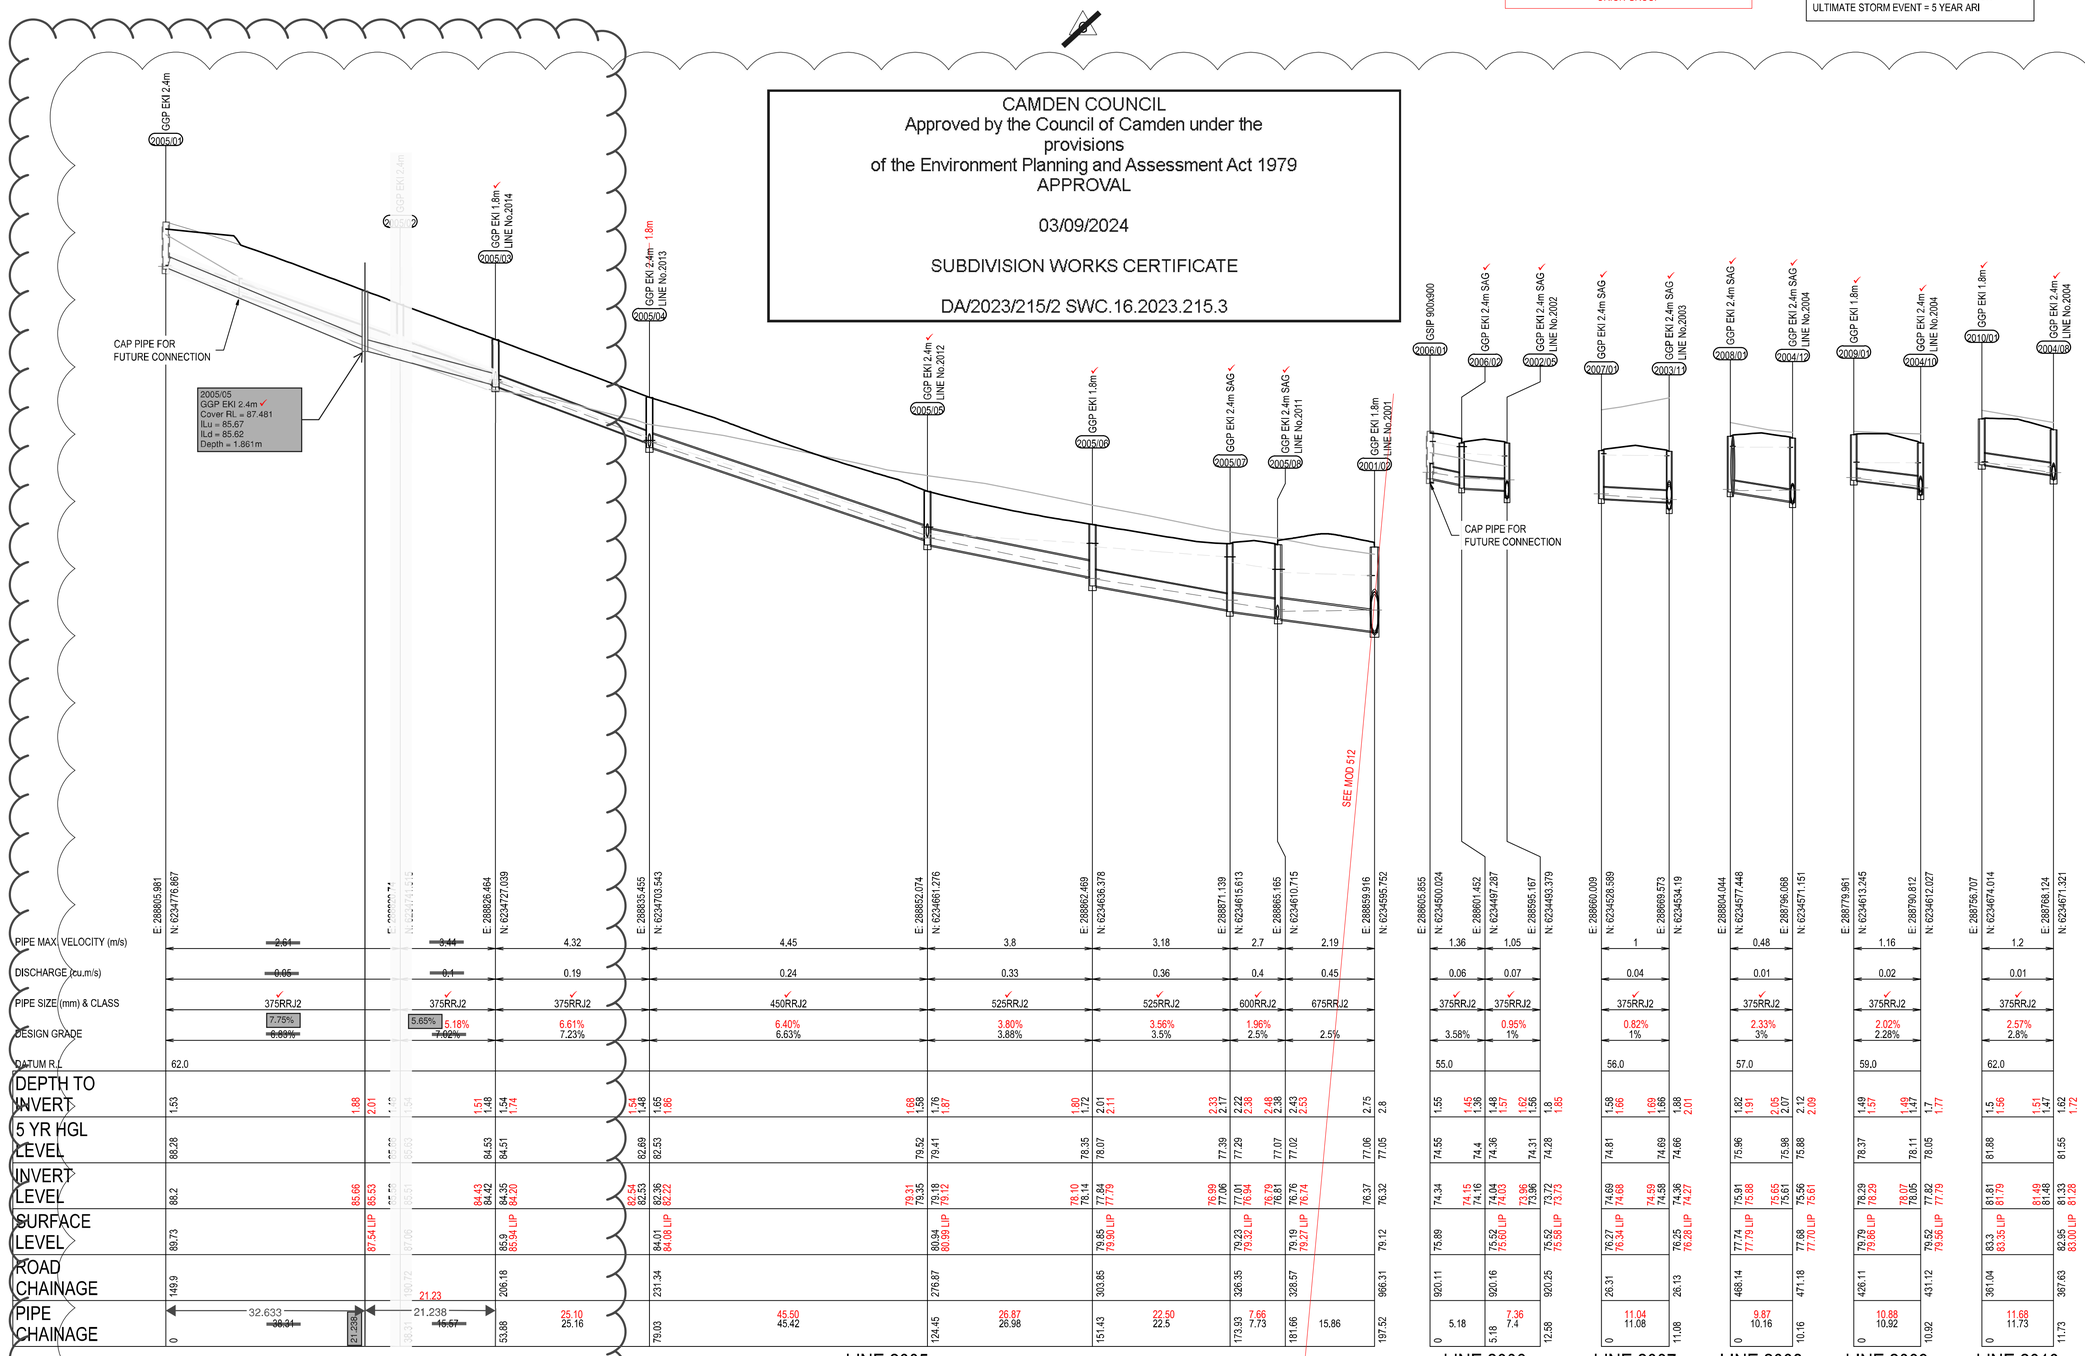

ISSUED FOR SUBDIVISION WORKS CERTIFICATE

H	AP	AP	WA	WA	16/07/2024	SWC MOD FOR ROAD 24 DRAINAGE NETWORK ADJUSTMENTS
G	RL/WP	LMc	AP	AP	20/03/2024	ISSUED FOR SUBDIVISION WORKS CERTIFICATE
F	WP	LMc	AP	AP	07/03/2024	ISSUED FOR SUBDIVISION WORKS CERTIFICATE
E	WP	LMc	AP	AP	27/02/2024	ISSUED FOR SUBDIVISION WORKS CERTIFICATE
D	RL	LMc	AP	AP	07/02/2024	ISSUED FOR SUBDIVISION WORKS CERTIFICATE
C	RL	LMc	AP	AP	23/01/2024	ISSUED FOR SUBDIVISION WORKS CERTIFICATE
B	RL	LMc	MP	AP	01/12/2023	ISSUED FOR SUBDIVISION WORKS CERTIFICATE
A	RL	LM/YK	MP	AP	27/11/2023	ISSUED FOR SUBDIVISION WORKS CERTIFICATE
Rev	Drawn	Design	Check	Appd.	Date	Revision Description

Disclaimer and Copyright:
ALL DIMENSIONS TO BE CHECKED ON SITE BY THE CONTRACTOR PRIOR TO CONSTRUCTION.
USE WRITTEN DIMENSIONS ONLY, DO NOT SCALE.
THESE DRAWINGS, PLANS, AND SPECIFICATIONS AND THE COPYRIGHT ARE THE PROPERTY OF ORION CONSULTING ENGINEERS PTY LTD AND MUST NOT BE REPRODUCED OR COPIED WHOLLY OR IN PART WITHOUT THE PERMISSION OF ORION CONSULTING ENGINEERS PTY LTD

Scale:
SCALE 1:500 (A1) SCALE 1:1000 (A3)
SCALE 1:100 (A1) SCALE 1:200 (A3)

For: mirvac

By: ORION

ABN:25 604 069 981 PO Box:7936, BAULKHAM HILLS NSW 2153 T:(02) 8660 0035 E:info@theoriongroup.au

Project: 589, 591 & 593 COBBITTY ROAD, COBBITTY (TRANCHE 4, STAGE 3a.) ROAD & DRAINAGE DESIGN

Title: DRAINAGE LONGITUDINAL SECTIONS SHEET 05

Project No.	Set No.	Milestone	Plan	Revision
23-0563	01	SWC	514	H

WORKS AS EXECUTED

WORKS AS EXECUTED INFORMATION SHOWN IN RED.
DATE: 07/02/2025

REGISTERED SURVEYOR ID: 8890
ORION GROUP

CAMDEN COUNCIL
Approved by the Council of Camden under the provisions of the Environment Planning and Assessment Act 1979
APPROVAL

03/09/2024

SUBDIVISION WORKS CERTIFICATE

DA/2023/215/2 SWC.16.2023.215.3

NOTE:

STORMWATER LONGITUDINAL SECTIONS REFLECT ULTIMATE PIT AND PIPE NETWORK. HYDROLOGY DOCUMENTED IS BASED ON ULTIMATE STORM EVENT = 5 YEAR ARI

LEGEND

- EXISTING SURFACE
- DESIGN SURFACE
- INTERIM SURFACE
- 5yr HGL
- 100yr HGL
- DESIGN PIPE AND PIT
- DESIGN TEMPORARY PIPE AND PIT
- EXISTING PIPE AND PIT
- FUTURE PIPE AND PIT

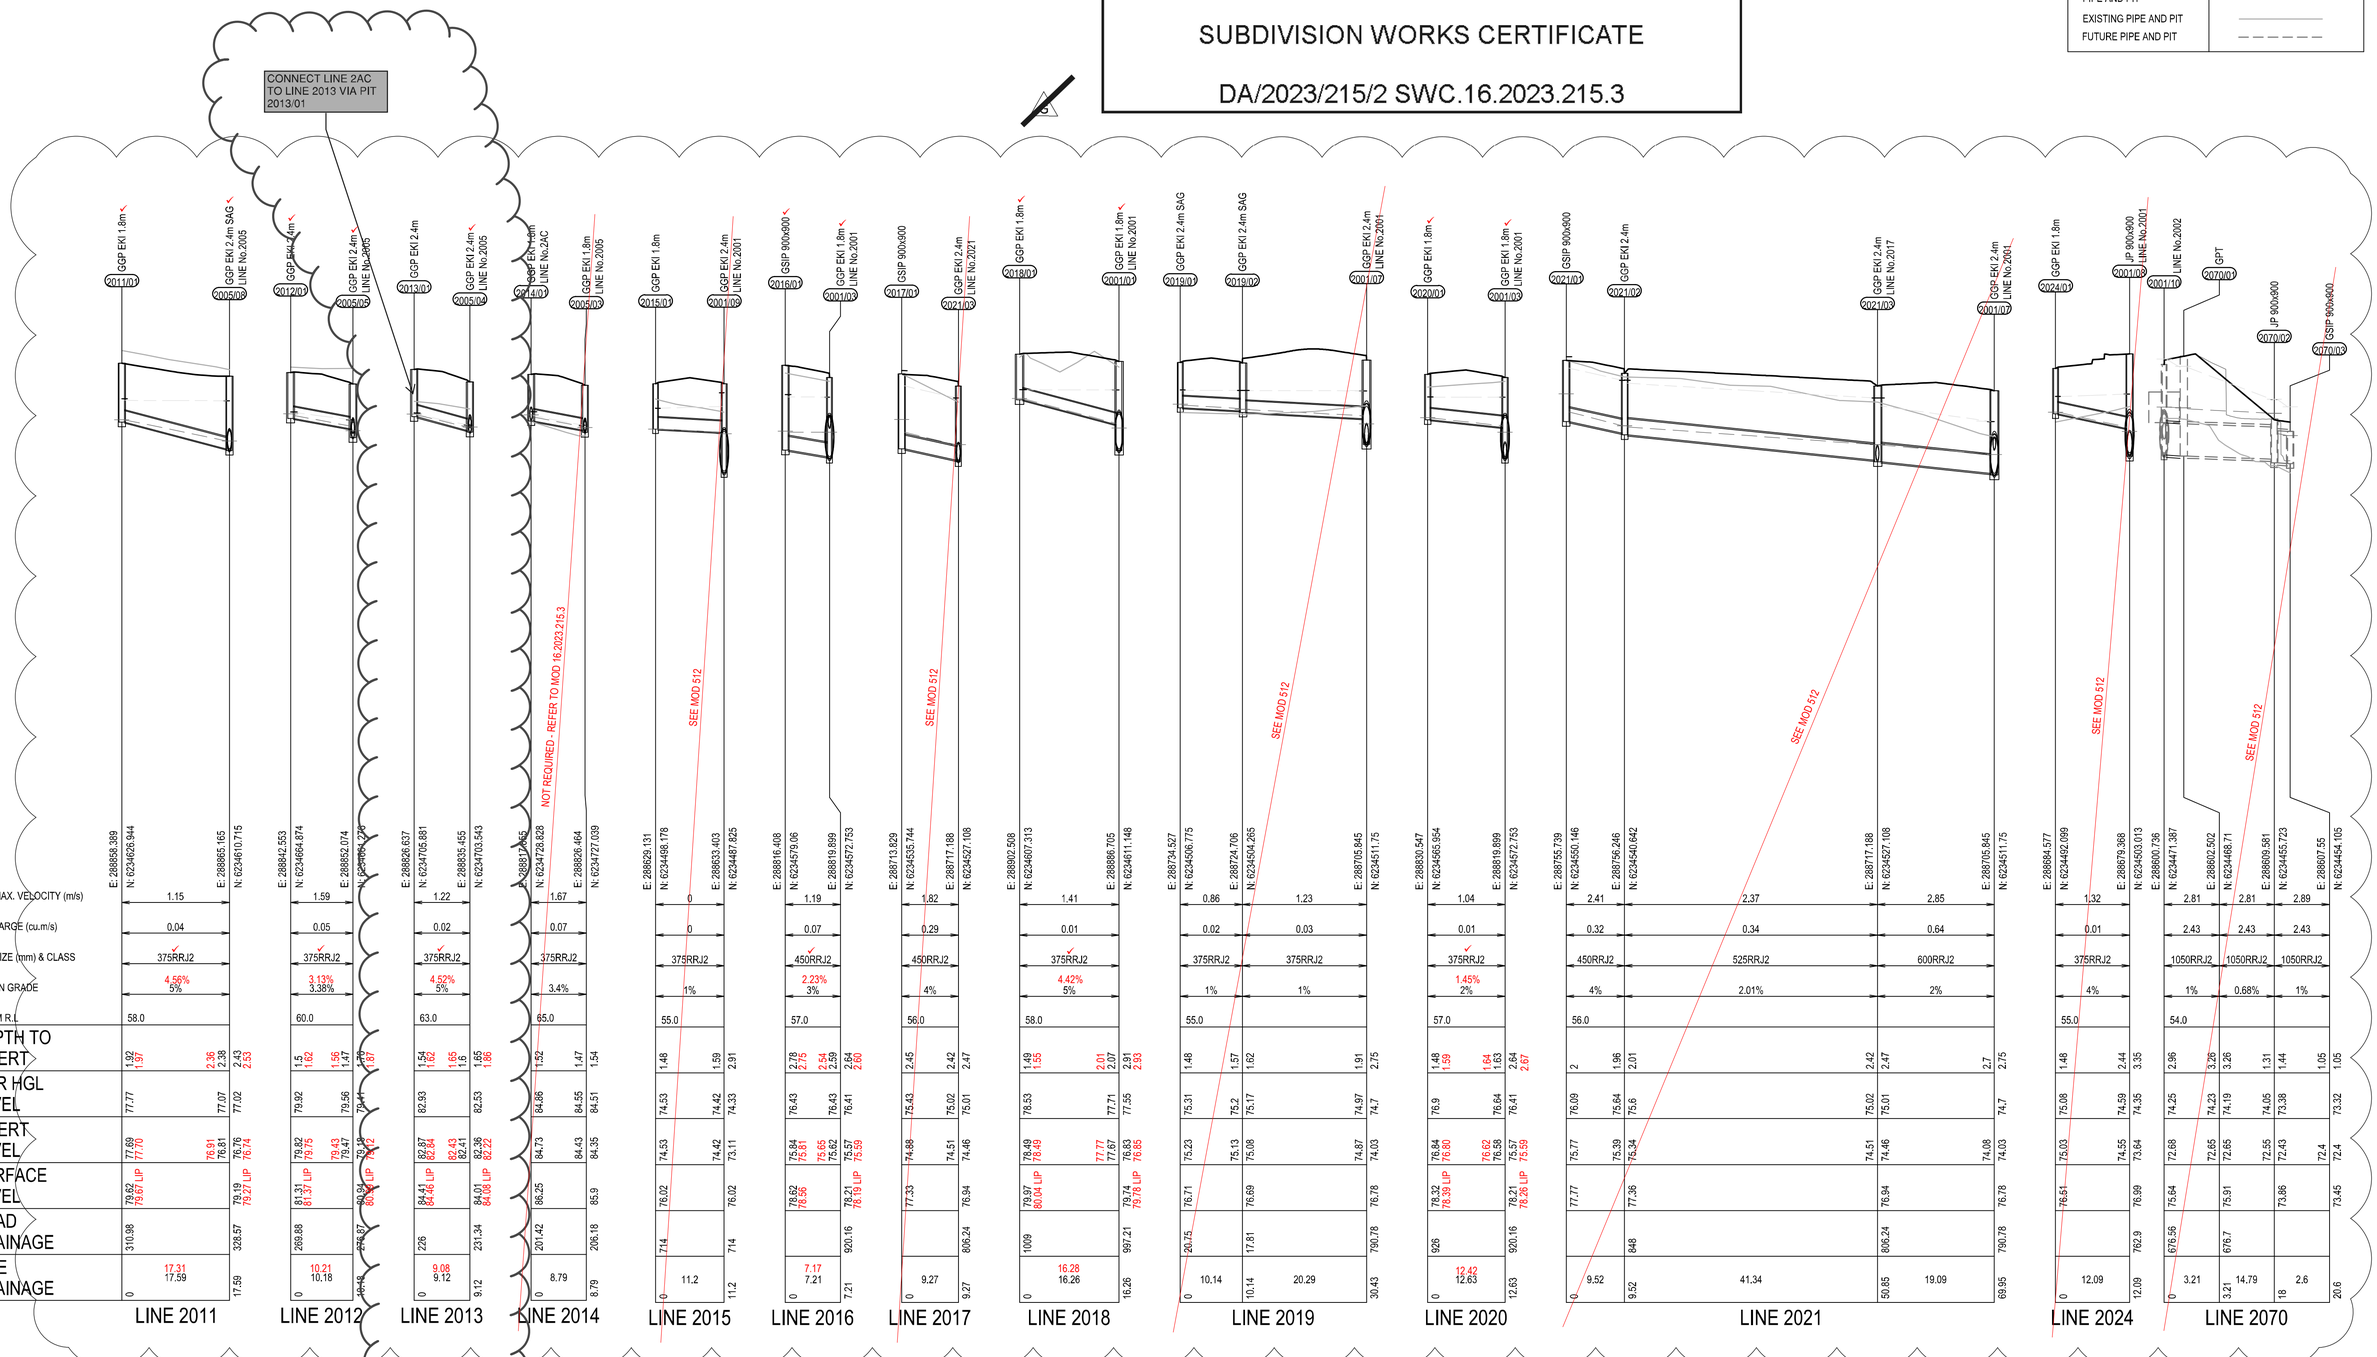

ISSUED FOR SUBDIVISION WORKS CERTIFICATE

Rev	Drawn	Design	Check	Appd.	Date	Revision Description
H	AP	AP	WA	WA	16/07/2024	SWC MOD FOR ROAD 24 DRAINAGE NETWORK ADJUSTMENTS
G	RL/WP	LMc	AP	AP	20/03/2024	ISSUED FOR SUBDIVISION WORKS CERTIFICATE
F	WP	LMc	AP	AP	07/03/2024	ISSUED FOR SUBDIVISION WORKS CERTIFICATE
E	WP	LMc	AP	AP	27/02/2024	ISSUED FOR SUBDIVISION WORKS CERTIFICATE
D	RL	LMc	AP	AP	07/02/2024	ISSUED FOR SUBDIVISION WORKS CERTIFICATE
C	RL	LMc	AP	AP	23/01/2024	ISSUED FOR SUBDIVISION WORKS CERTIFICATE
B	RL	LMc	MP	AP	01/12/2023	ISSUED FOR SUBDIVISION WORKS CERTIFICATE
A	RL	LM/YK	MP	AP	27/11/2023	ISSUED FOR SUBDIVISION WORKS CERTIFICATE

Disclaimer and Copyright:
ALL DIMENSIONS TO BE CHECKED ON SITE BY THE CONTRACTOR PRIOR TO CONSTRUCTION.
USE WRITTEN DIMENSIONS ONLY. DO NOT SCALE.
THESE DRAWINGS, PLANS, AND SPECIFICATIONS AND THE COPYRIGHT ARE THE PROPERTY OF ORION CONSULTING ENGINEERS PTY LTD AND MUST NOT BE REPRODUCED OR COPIED WHOLLY OR IN PART WITHOUT THE PERMISSION OF ORION CONSULTING ENGINEERS PTY LTD

Scale:
0 5 10 15 20 25 30 35 40 45 50
SCALE 1:500 (A1) SCALE 1:1000 (A3)
0 1 2 3 4 5 6 7 8 9 10
SCALE 1:100 (A1) SCALE 1:200 (A3)

For: mirvac

By: ORION

ABN:25 604 069 981 PO Box:7936, BAULKHAM HILLS NSW 2153 T:(02) 8660 0035 E:info@theoriongroup.au

Project:
589, 591 & 593 COBBITTY ROAD, COBBITTY
(TRANCHE 4, STAGE 3a.)
ROAD & DRAINAGE DESIGN

Title:
DRAINAGE LONGITUDINAL SECTIONS
SHEET 06

Project No.	Set No.	Milestone	Plan	Revision
23-0563	01	SWC	515	H

WORKS AS EXECUTED

WORKS AS EXECUTED INFORMATION SHOWN IN RED.
DATE: 07/02/2025

REGISTERED SURVEYOR ID: 8890
ORION GROUP

NOTE:

STORMWATER LONGITUDINAL SECTIONS REFLECT ULTIMATE PIT AND PIPE NETWORK. HYDROLOGY DOCUMENTED IS BASED ON ULTIMATE STORM EVENT = 5 YEAR ARI

LEGEND

EXISTING SURFACE	
DESIGN SURFACE	
INTERIM SURFACE	
5yr HGL	
100yr HGL	
DESIGN PIPE AND PIT	
DESIGN TEMPORARY PIPE AND PIT	
EXISTING PIPE AND PIT	
FUTURE PIPE AND PIT	

Refer to new long section for updated Line 2AC

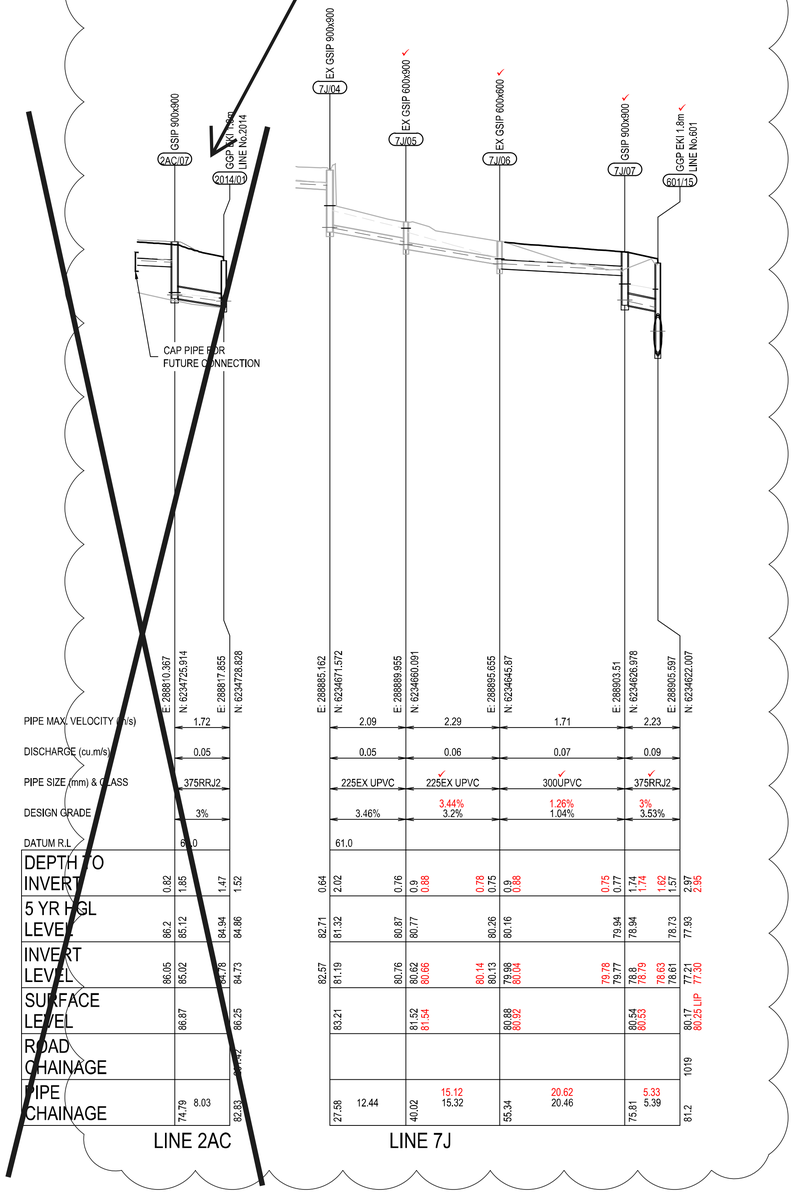

| | | |

WORKS AS EXECUTED

WORKS AS EXECUTED INFORMATION SHOWN IN RED.
DATE: 07/02/2025

REGISTERED SURVEYOR ID: 8890
ORION GROUP

NOTE:

STORMWATER LONGITUDINAL SECTIONS REFLECT INTERIM PIT AND PIPE NETWORK.

LEGEND

EXISTING SURFACE	
DESIGN SURFACE	
INTERIM SURFACE	
5yr HGL	
100yr HGL	
DESIGN PIPE AND PIT	
DESIGN TEMPORARY PIPE AND PIT	
EXISTING PIPE AND PIT	
FUTURE PIPE AND PIT	

F

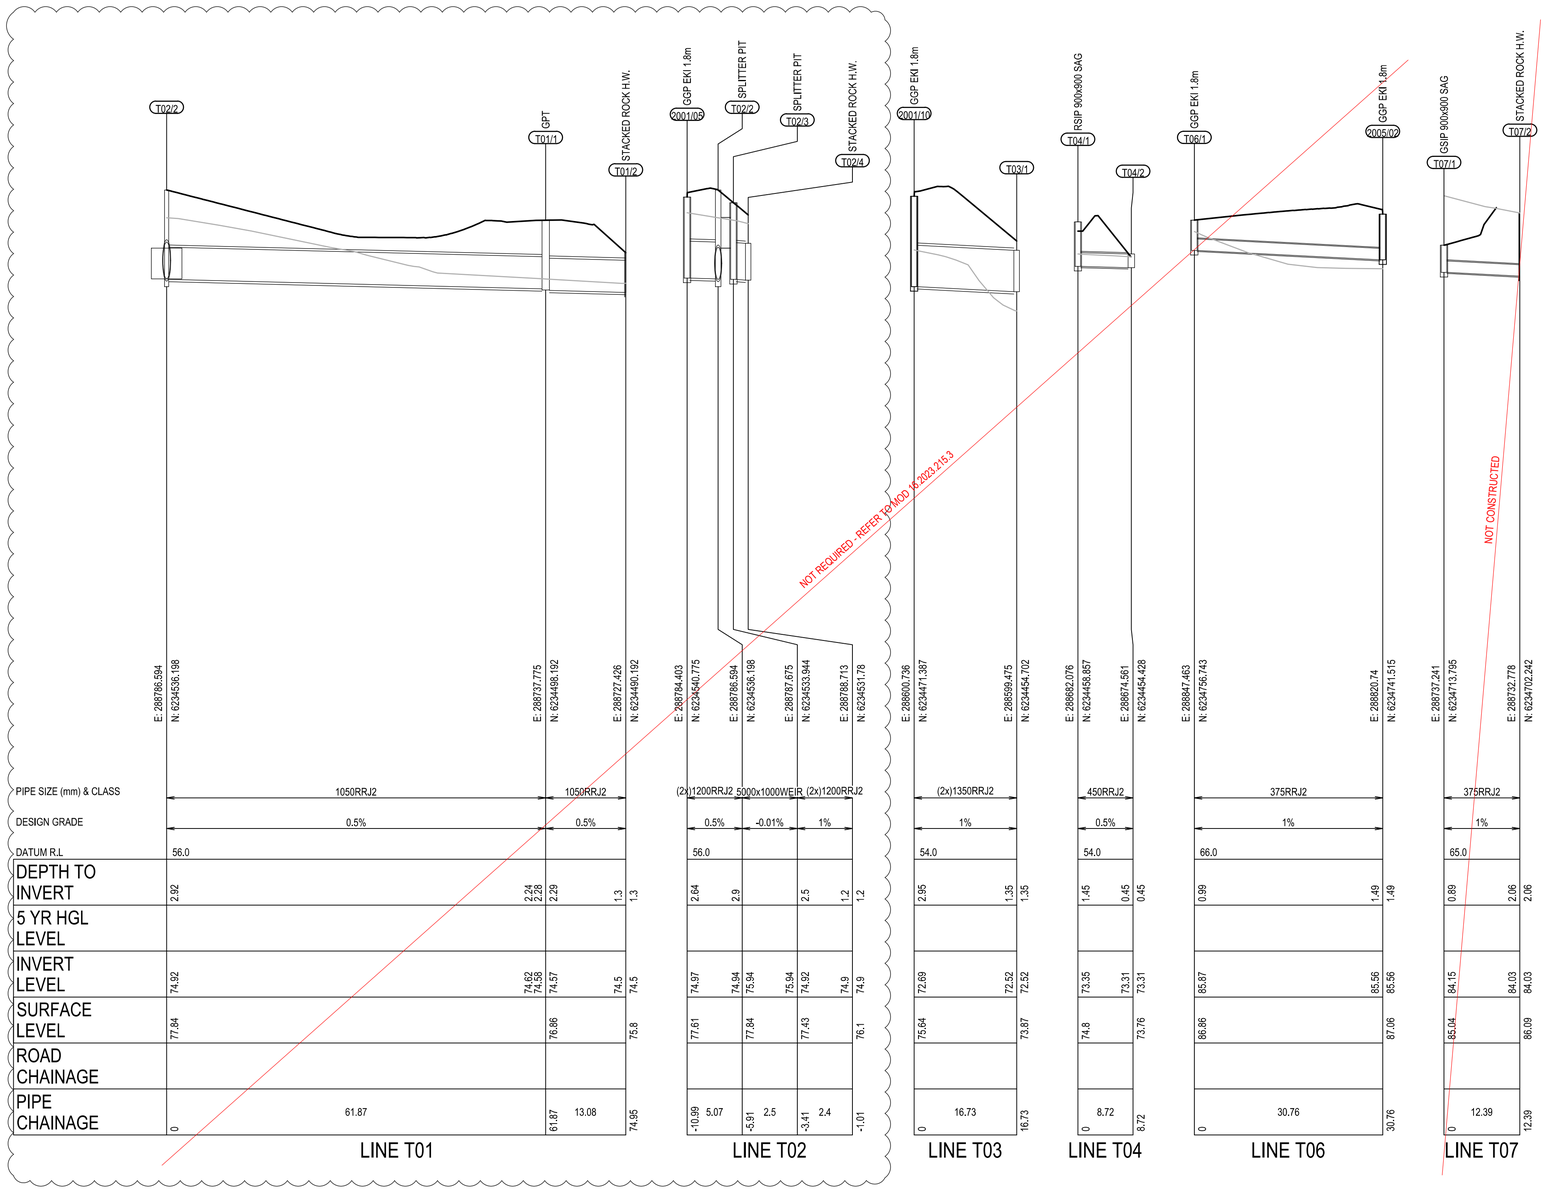

	LINE T01					LINE T02						LINE T03		LINE T04		LINE T06		LINE T07	
E:	288786.594		288737.775		288727.426	288784.403		288786.594	288787.675		288788.713	288600.736	288599.475	288682.076	288674.561	288847.463	288820.74	288737.241	288732.778
N:	6234536.198		6234498.192		6234490.192	6234540.775		6234536.198	6234533.944		6234531.78	6234471.387	6234454.702	6234458.857	6234454.428	6234756.743	6234741.515	6234713.795	6234702.242
PIPE SIZE (mm) & CLASS	1050RRJ2		1050RRJ2			(2x)1200RRJ2	5000x1000WEIR	(2x)1200RRJ2				(2x)1350RRJ2		450RRJ2		375RRJ2		375RRJ2	
DESIGN GRADE	0.5%		0.5%			0.5%	-0.01%	1%				1%		0.5%		1%		1%	
DATUM R.L	56.0					56.0						54.0		54.0		66.0		65.0	
DEPTH TO INVERT	2.92		2.24	2.28	2.29	2.64	2.9		2.5	1.2	1.2	2.95	1.35	1.45	0.45	0.99	1.49	0.89	2.06
5 YR HGL LEVEL																			
INVERT LEVEL	74.92		74.68	74.58	74.57	74.97	74.94	75.94	75.94	74.9	74.9	72.69	72.52	73.35	73.31	85.87	85.56	84.15	84.03
SURFACE LEVEL	77.84				76.86	77.61		77.84	77.43		76.1	75.64	73.87	74.8	73.76	86.86	87.06	85.04	86.09
ROAD CHAINAGE																			
PIPE CHAINAGE	0	61.87	61.87	13.08	74.95	-10.39	5.07	-5.91	2.5	-3.41	2.4	-1.01	16.73	0	8.72	0	30.76	0	12.39

CAMDEN COUNCIL
Approved by the Council of Camden under the provisions of the Environment Planning and Assessment Act 1979
APPROVAL

22/03/2024

SUBDIVISION WORKS CERTIFICATE

DA/2023/215/1 SWC.16.2023.215.1

ISSUED FOR SUBDIVISION WORKS CERTIFICATE

Rev	Drawn	Design	Check	Appd.	Date	Revision Description
F	WP	LMc	AP	AP	07/03/2024	ISSUED FOR SUBDIVISION WORKS CERTIFICATE
E	WP	LMc	AP	AP	27/02/2024	ISSUED FOR SUBDIVISION WORKS CERTIFICATE
D	RL	LMc	AP	AP	07/02/2024	ISSUED FOR SUBDIVISION WORKS CERTIFICATE
C	RL	LMc	AP	AP	23/01/2024	ISSUED FOR SUBDIVISION WORKS CERTIFICATE
B	RL	LMc	MP	AP	01/12/2023	ISSUED FOR SUBDIVISION WORKS CERTIFICATE
A	RL	LM/YK	MP	AP	27/11/2023	ISSUED FOR SUBDIVISION WORKS CERTIFICATE

Disclaimer and Copyright:
ALL DIMENSIONS TO BE CHECKED ON SITE BY THE CONTRACTOR PRIOR TO CONSTRUCTION.
USE WRITTEN DIMENSIONS ONLY. DO NOT SCALE.
THESE DRAWINGS, PLANS, AND SPECIFICATIONS AND THE COPYRIGHT ARE THE PROPERTY OF ORION CONSULTING ENGINEERS PTY LTD AND MUST NOT BE REPRODUCED OR COPIED WHOLLY OR IN PART WITHOUT THE PERMISSION OF ORION CONSULTING ENGINEERS PTY LTD

Scale:
0 5 10 15 20 25 30 35 40 45 50
SCALE 1:500 (A1) SCALE 1:1000 (A3)
0 1 2 3 4 5 6 7 8 9 10
SCALE 1:100 (A1) SCALE 1:200 (A3)

For: mirvac

By: ORION
ABN:25 604 069 981 PO Box:7936, BAULKHAM HILLS NSW 2153 T:(02) 8660 0035 E:info@theoriongroup.au

Project:
589, 591 & 593 COBBITTY ROAD, COBBITTY
(TRANCHE 4, STAGE 3a.)
ROAD & DRAINAGE DESIGN

Title:
DRAINAGE LONGITUDINAL SECTIONS
SHEET 08

Project No.	Set No.	Milestone	Plan	Revision
23-0563	01	SWC	517	F

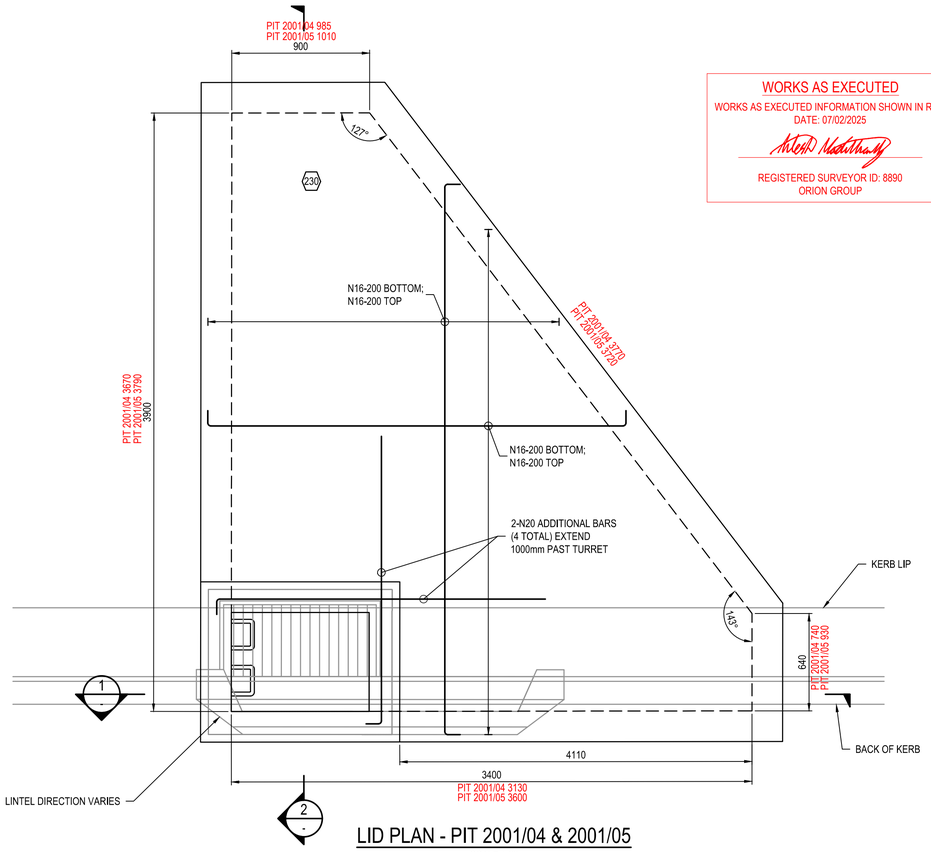

LID PLAN - PIT 2001/04 & 2001/05

SCALE 1:20

WORKS AS EXECUTED

WORKS AS EXECUTED INFORMATION SHOWN IN RED.
DATE: 07/02/2025

REGISTERED SURVEYOR ID: 8890
ORION GROUP

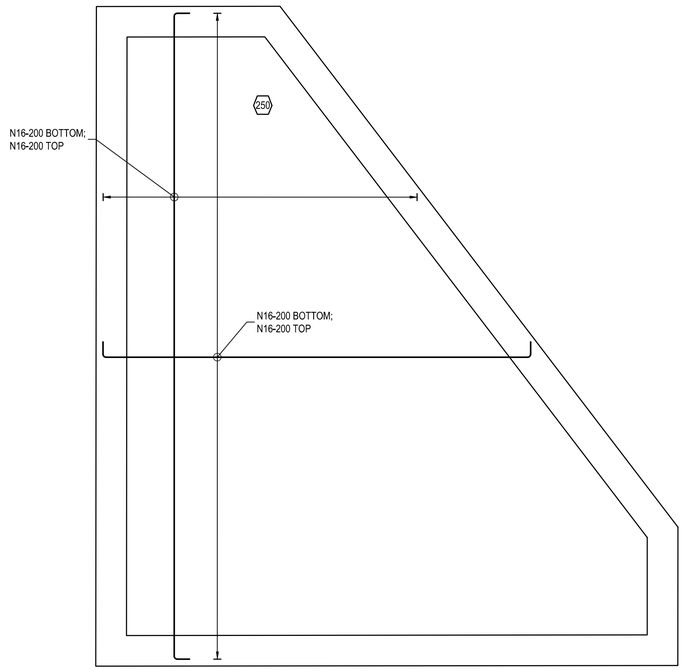

BASE PLAN - PIT 2001/04 & 2001/05

SCALE 1:20

NOTE:

1. FOUNDATION MIN. BEARING CAPACITY 150 kPa - TO BE CONFIRMED BY GEOTECHNICAL CONSULTANT.
2. READ THIS DRAWING IN CONJUNCTION WITH CONSTRUCTION NOTES ON DRG SWC-002.
3. CONFIRM DIMENSIONS OF ALL PRECAST ITEMS PRIOR TO FABRICATING REINFORCEMENT AND SETTING OUT FORM WORK.
4. READ THIS DRG IN CONJUNCTION WITH DRAINAGE PIT SCHEDULE AND DRAINAGE PIT SECTIONS.

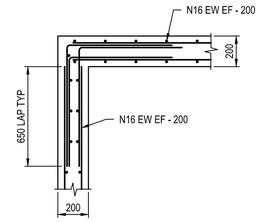

TYPICAL CORNER DETAIL

SCALE 1:20

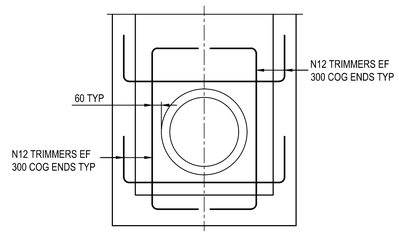

TYPICAL PIPE ENTRY/EXIT FROM PIT

SCALE 1:20

E

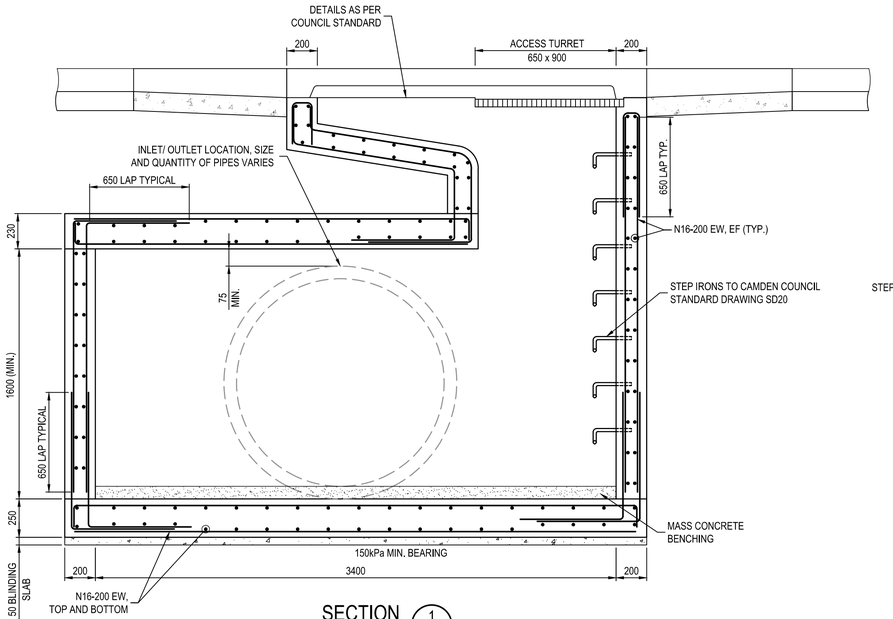

SECTION 1 - SCALE 1:20

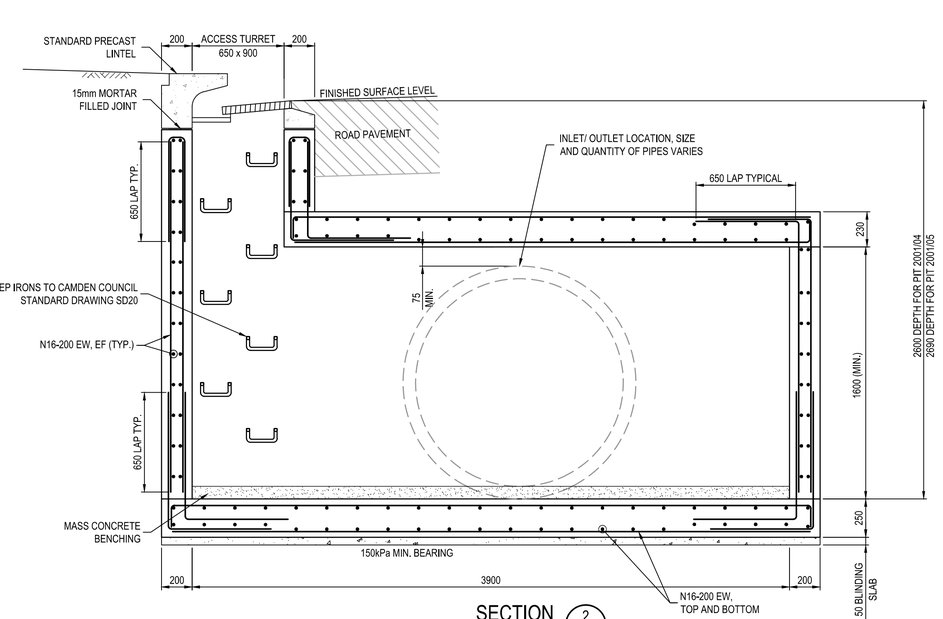

SECTION 2 - SCALE 1:20

CAMDEN COUNCIL
Approved by the Council of Camden under the provisions of the Environment Planning and Assessment Act 1979
APPROVAL

22/03/2024

SUBDIVISION WORKS CERTIFICATE

DA/2023/215/1 SWC.16.2023.215.1

ISSUED FOR SUBDIVISION WORKS CERTIFICATE

Rev	Drawn	Design	Check	Appd.	Date	Revision Description
E	WP	MS	NW	NW	20/03/2024	ISSUED FOR SUBDIVISION WORKS CERTIFICATE
D	RL	MS	NW	NW	23/02/2024	ISSUED FOR SUBDIVISION WORKS CERTIFICATE
-	-	-	-	-	-	-
B	RL	LMc	MP	AP	01/12/2023	ISSUED FOR SUBDIVISION WORKS CERTIFICATE
-	-	-	-	-	-	-

Disclaimer and Copyright:
ALL DIMENSIONS TO BE CHECKED ON SITE BY THE CONTRACTOR PRIOR TO CONSTRUCTION.
USE WRITTEN DIMENSIONS ONLY, DO NOT SCALE.
THESE DRAWINGS, PLANS, AND SPECIFICATIONS AND THE COPYRIGHT ARE THE PROPERTY OF ORION CONSULTING ENGINEERS PTY LTD AND MUST NOT BE REPRODUCED OR COPIED WHOLLY OR IN PART WITHOUT THE PERMISSION OF ORION CONSULTING ENGINEERS PTY LTD

Scale:
0 0.2 0.4 0.6 0.8 1.0 1.2 1.4 1.6 1.8 2.0
SCALE 1:20 (A1) SCALE 1:40 (A3)

For: mirvac

By: ORION

ABN:25 604 069 981 PO Box:7936, BAULKHAM HILLS NSW 2153 T:(02) 8660 0035 E:info@theoriongroup.au

Project:
589, 591 & 593 COBBITTY ROAD, COBBITTY
(TRANCHE 4, STAGE 3a.)
ROAD & DRAINAGE DESIGN

Title:
SPECIAL PIT DETAILS
PIT 2001/04 & 2001/05

Project No.	Set No.	Milestone	Plan	Revision
23-0563	01	SWC	545	E

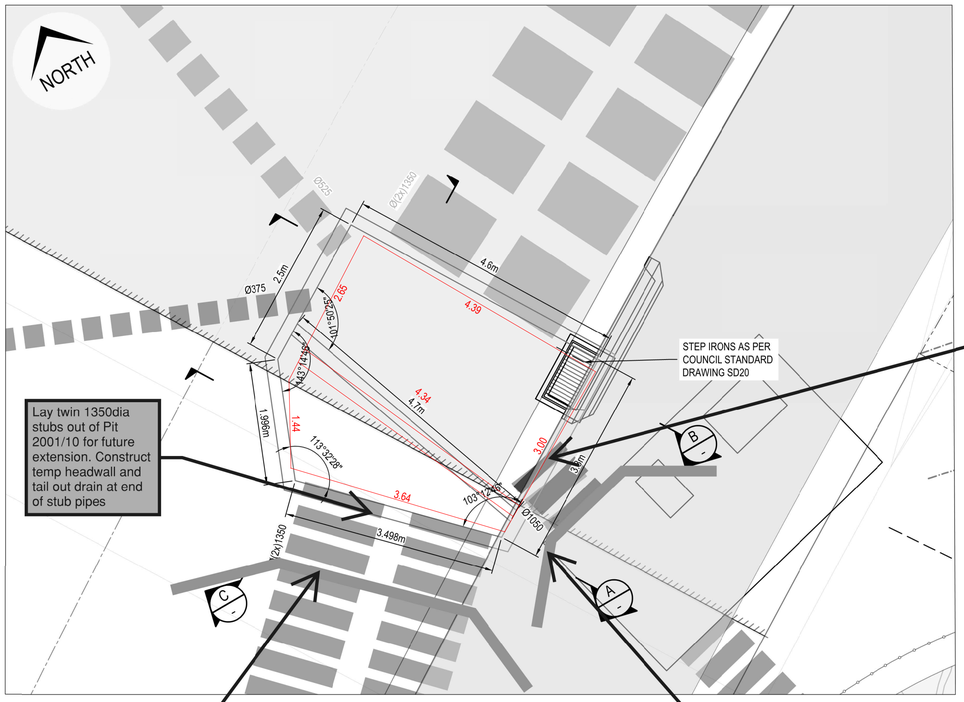

SPLITTER PIT 2001/10 - PLAN VIEW

SCALE 1:50

Lay twin 1350dia stubs out of Pit 2001/10 for future extension. Construct temp headwall and tail out drain at end of stub pipes

Lay 1050dia stub out of Temporary Pit 2001/10 for future connection. Construct temp headwall and tail out drain at end of stub pipe

For Structural Details refer to Structural Drawings - plans 652456-S17 and 652456-S18

Provide temporary stacked rock headwall to twin 1350dia stubs out of Pit 2001/10. Construct tail out drain at end of stub pipes

Provide temporary stacked rock headwall to 1050dia stub out of Pit 2001/10. Construct tail out drain at end of stub pipes

Note: Pit 2001/10 to be constructed in accordance with approval under DA 2023/461/1

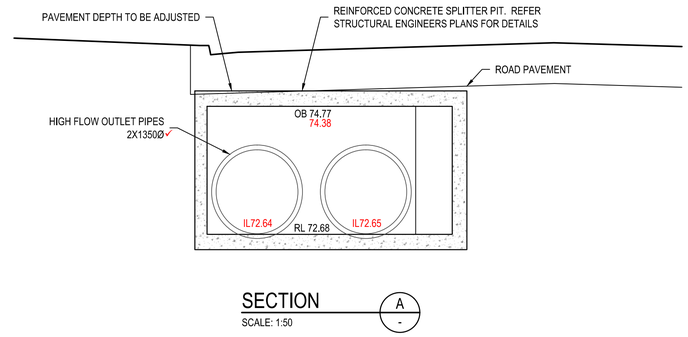

SECTION A

SCALE: 1:50

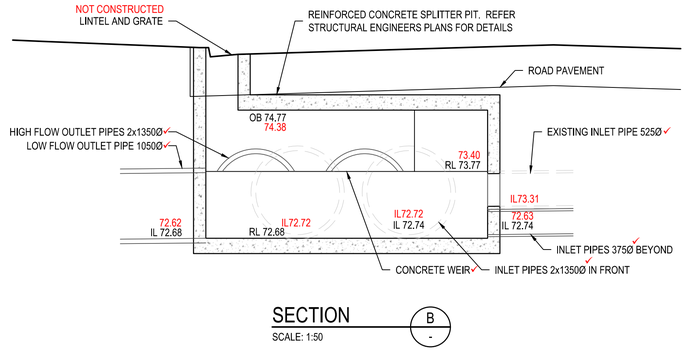

SECTION B

SCALE: 1:50

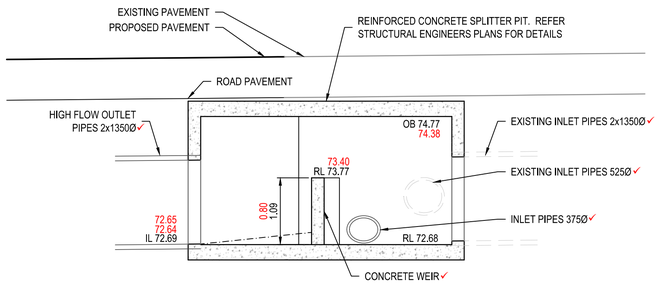

SECTION C

SCALE: 1:50

WORKS AS EXECUTED

WORKS AS EXECUTED INFORMATION SHOWN IN RED.
DATE: 07/02/2025

REGISTERED SURVEYOR ID: 8890
ORION GROUP

ISSUED FOR SUBDIVISION WORKS CERTIFICATE

Rev	Drawn	Design	Check	Appd.	Date	Revision Description
A	RL	LMc	MP	MP	25/07/2024	ISSUED FOR SUBDIVISION WORKS CERTIFICATE

Disclaimer and Copyright:
ALL DIMENSIONS TO BE CHECKED ON SITE BY THE CONTRACTOR PRIOR TO CONSTRUCTION.
USE WRITTEN DIMENSIONS ONLY, DO NOT SCALE.
THESE DRAWINGS, PLANS, AND SPECIFICATIONS AND THE COPYRIGHT ARE THE PROPERTY OF ORION CONSULTING ENGINEERS PTY LTD AND MUST NOT BE REPRODUCED OR COPIED WHOLLY OR IN PART WITHOUT THE PERMISSION OF ORION CONSULTING ENGINEERS PTY LTD

Scale:
0 0.5 1.0 1.5 2.0 2.5 3.0 3.5 4.0 4.5 5.0
SCALE 1:50 (A1) SCALE 1:100 (A3)

For: mirvac

By: ORION

ABN:25 604 069 981 PO Box:7936, BAULKHAM HILLS NSW 2153 T:(02) 8660 0035 E:info@theoriongroup.au

Project: 591, 593 COBBITTY ROAD & 1 FRESHWATER DRIVE, COBBITTY (PRECINCT 2A STAGE 1 & TRANCHE 5a STAGE 1) ROAD & DRAINAGE DESIGN

Title: SPLITTER PIT O2001/10 PLAN & DETAILS

Project No.	Set No.	Milestone	Plan	Revision
23-0579	01	SWC	554	A

SWALE 1 - PLAN VIEW

SCALE 1:500

WORKS AS EXECUTED

WORKS AS EXECUTED INFORMATION SHOWN IN RED.
DATE: 07/02/2025

REGISTERED SURVEYOR ID: 8890
ORION GROUP

SETOUT TABLE SWALE 1					
CHAINAGE	EASTING	NORTHING	BEARING	RAD/SPIRAL	A.LENGTH
0	288690.19	6234718.12	73°35'25.38"		
17.26	288706.75	6234723	73°35'25.38"		
27.35	288716.55	6234725.89		-50	20.169
37.43	288724.44	6234732.39	50°28'42.37"		
47.02	288731.83	6234738.49	50°28'42.37"		
60.13	288742.05	6234746.92		75	26.228
73.25	288754.55	6234751.34	70°30'54.14"		
76.38	288757.5	6234752.39	70°30'54.14"		
96.03	288776.27	6234759.03		-100	39.293
115.68	288791.06	6234772.35	48°00'06.18"		
126.44	288799.06	6234779.55	48°00'06.18"		
138.44	288808.15	6234787.73		50	23.998
150.44	288820	6234790.8	75°30'07.05"		
160.92	288830.14	6234793.42	75°30'07.05"		

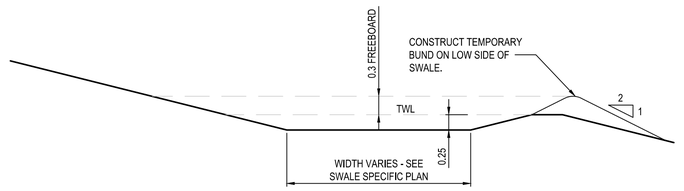

TYPICAL SWALE SECTION

NTS

LEGEND

- DESIGN SURFACE
- EXISTING SURFACE
- FUTURE SURFACE

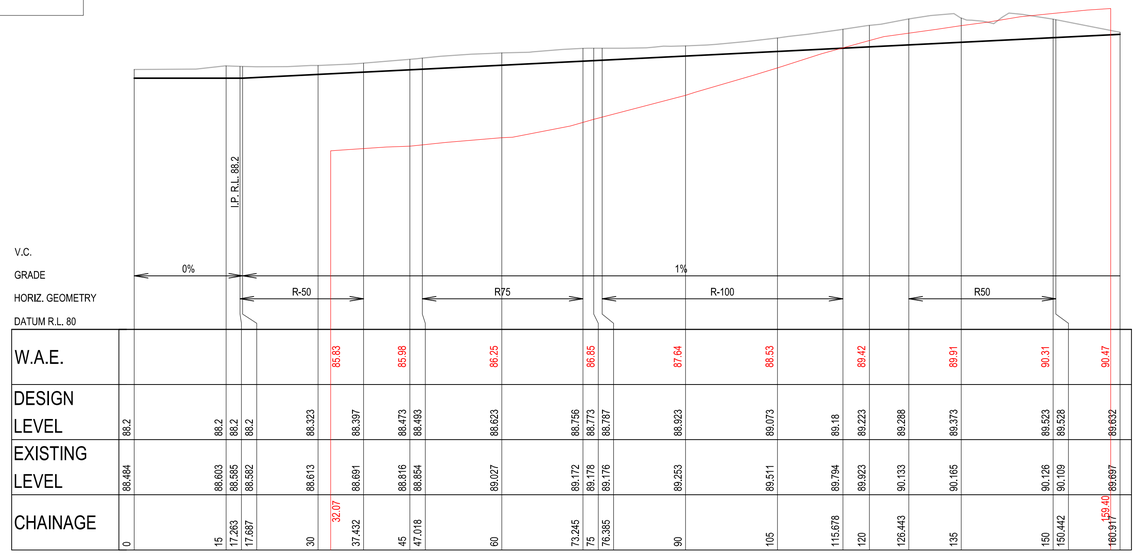

| | | | | |

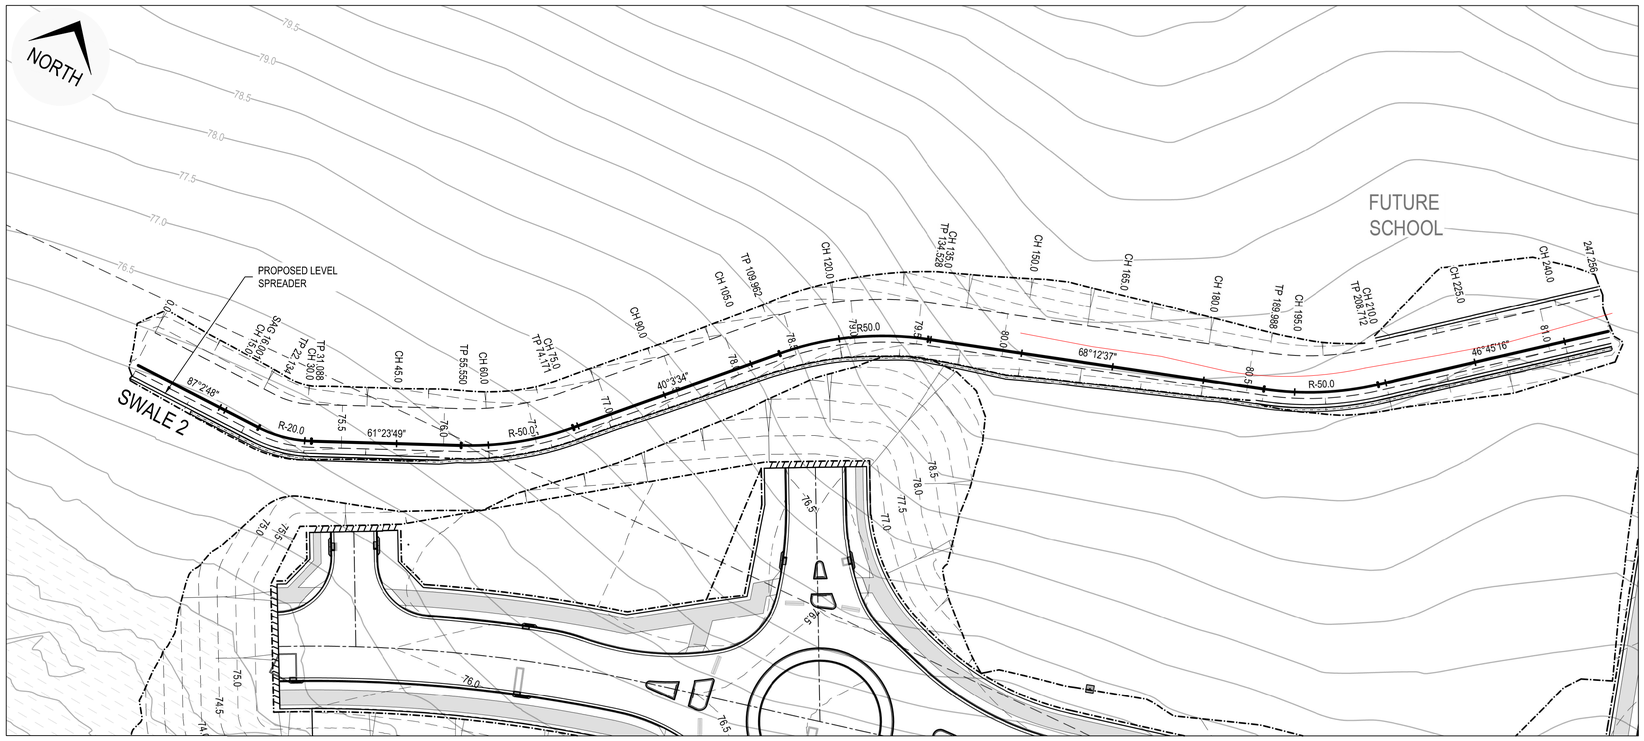

SWALE 2 - PLAN VIEW

SCALE 1:500

SETOUT TABLE SWALE 2					
CHAINAGE	EASTING	NORTHING	BEARING	RAD/SPIRAL	A.LENGTH
0	288553.05	6234503.08	87°02'47.61"		
22.13	288575.15	6234504.22	87°02'47.61"		
26.61	288579.7	6234504.46		-20	8.953
31.09	288583.69	6234506.64	61°23'48.94"		
55.55	288605.17	6234518.35	61°23'48.94"		
64.86	288613.44	6234522.86		-50	18.621
74.17	288619.5	6234530.07	40°03'33.74"		
109.96	288642.54	6234557.46	40°03'33.74"		
122.24	288650.61	6234567.05		50	24.566
134.53	288662.25	6234571.71	68°12'36.94"		
189.99	288713.74	6234592.29	68°12'36.94"		
199.35	288722.54	6234595.81		-50	18.724
208.71	288729.44	6234602.3	46°45'15.56"		
247.26	288757.52	6234628.71	46°45'15.56"		

WORKS AS EXECUTED

WORKS AS EXECUTED INFORMATION SHOWN IN RED.
DATE: 07/02/2025

REGISTERED SURVEYOR ID: 8890
ORION GROUP

CAMDEN COUNCIL
Approved by the Council of Camden under the provisions of the Environment Planning and Assessment Act 1979
APPROVAL

22/03/2024

SUBDIVISION WORKS CERTIFICATE

DA/2023/215/1 SWC.16.2023.215.1

LEGEND

- DESIGN SURFACE
- EXISTING SURFACE
- FUTURE SURFACE

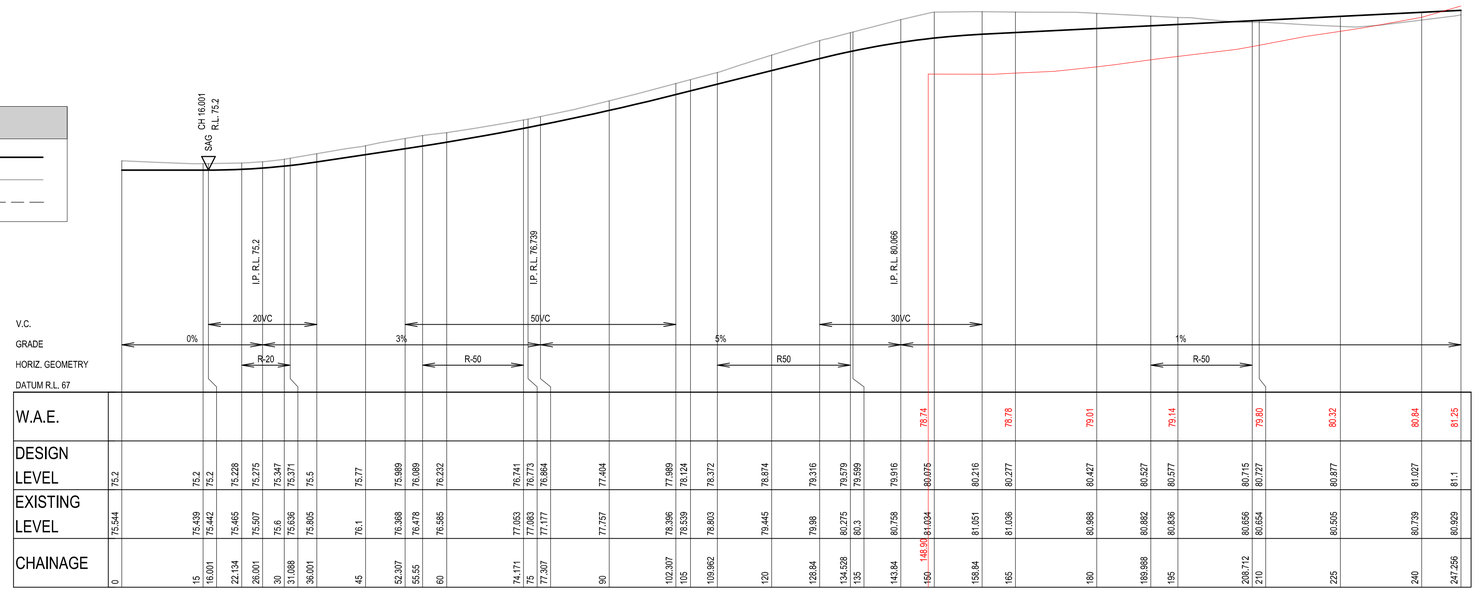

| | | | | |

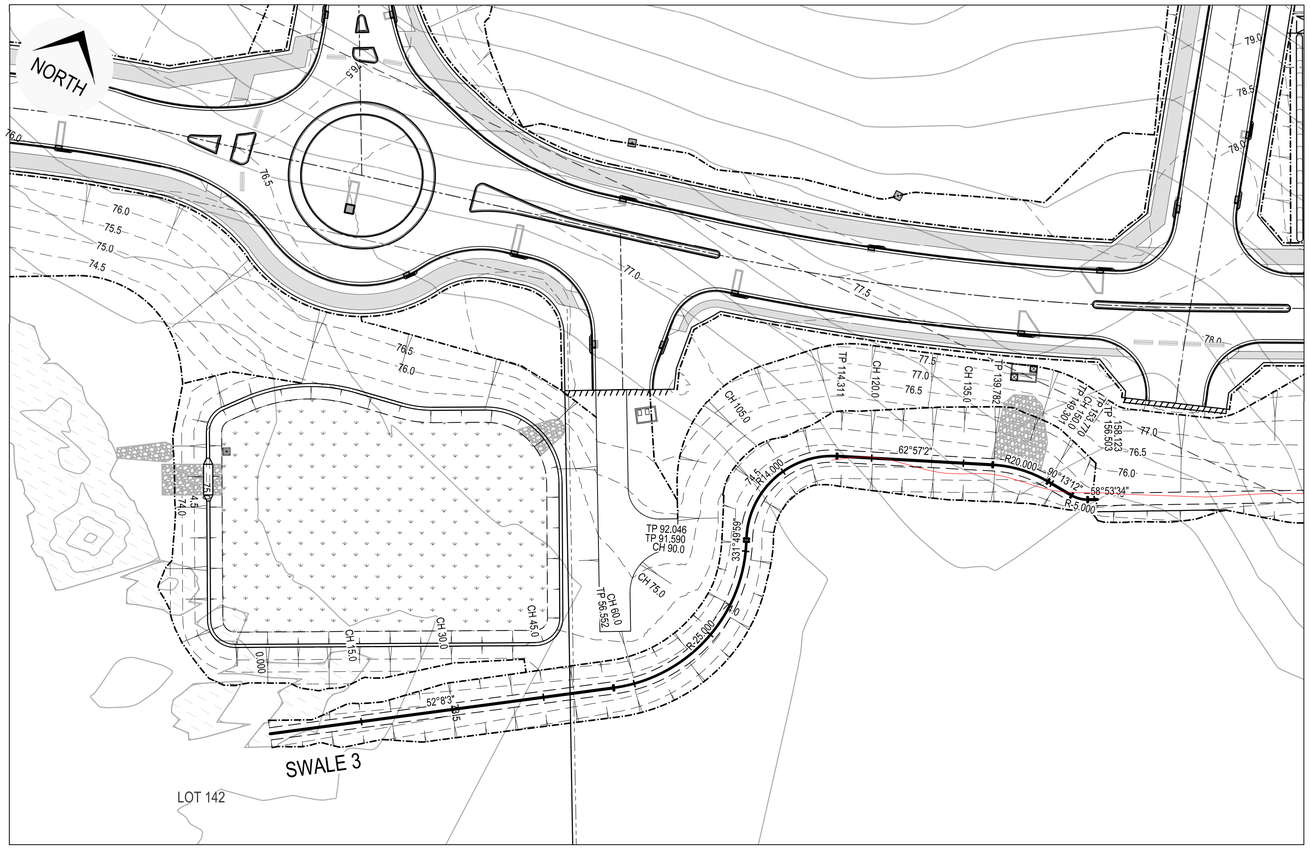

SWALE 3 - PLAN VIEW

SCALE 1:500

WORKS AS EXECUTED

WORKS AS EXECUTED INFORMATION SHOWN IN RED.
DATE: 07/02/2025

REGISTERED SURVEYOR ID: 8890
ORION GROUP

CAMDEN COUNCIL
Approved by the Council of Camden under the provisions of the Environment Planning and Assessment Act 1979
APPROVAL

02/07/2024

SUBDIVISION WORKS CERTIFICATE

DA/DA/2023/215/2 SWC.16.2023.215.2

SETOUT TABLE SWALE 3

CHAINAGE	EASTING	NORTHING	BEARING	RAD/SPIRAL	A.LENGTH
0	288711.44	6234422.64	52°08'03.04"		
56.55	288756.08	6234457.35	52°08'03.04"		
74.07	288772.73	6234470.29		-25	35.038
91.59	288762.78	6234488.89	331°49'59.24"		
92.05	288762.56	6234489.29	331°49'59.24"		
103.18	288755.82	6234501.87		14	22.264
114.31	288768.54	6234508.36	62°57'01.88"		
139.78	288791.22	6234519.95	62°57'01.88"		
144.54	288795.54	6234522.15		20	9.519
149.3	288800.39	6234522.14	90°13'12.21"		
153.77	288804.86	6234522.12	90°13'12.21"		
155.14	288806.27	6234522.11		-5	2.734
156.5	288807.47	6234522.84	58°53'34.48"		
158.12	288808.85	6234523.67	58°53'34.48"		

LEGEND

- DESIGN SURFACE
- EXISTING SURFACE
- FUTURE SURFACE

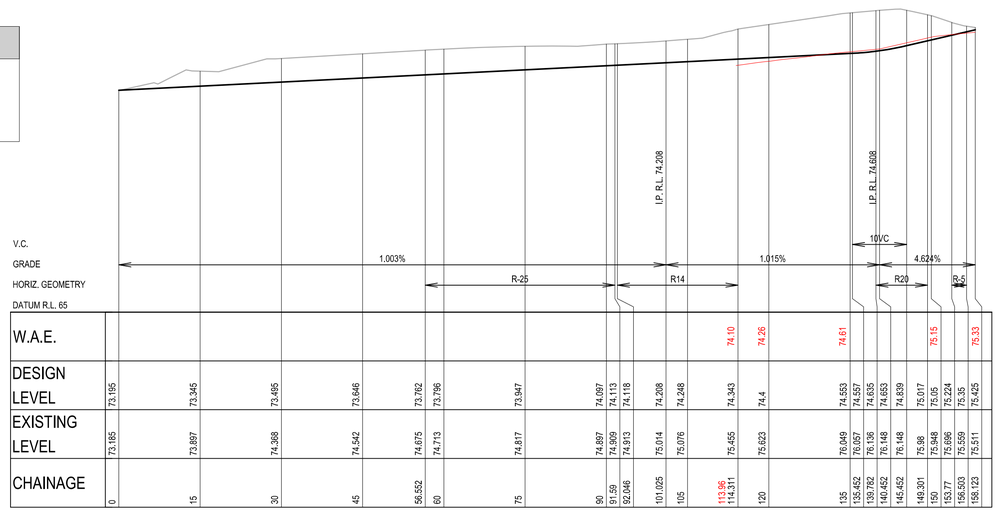

| | | |

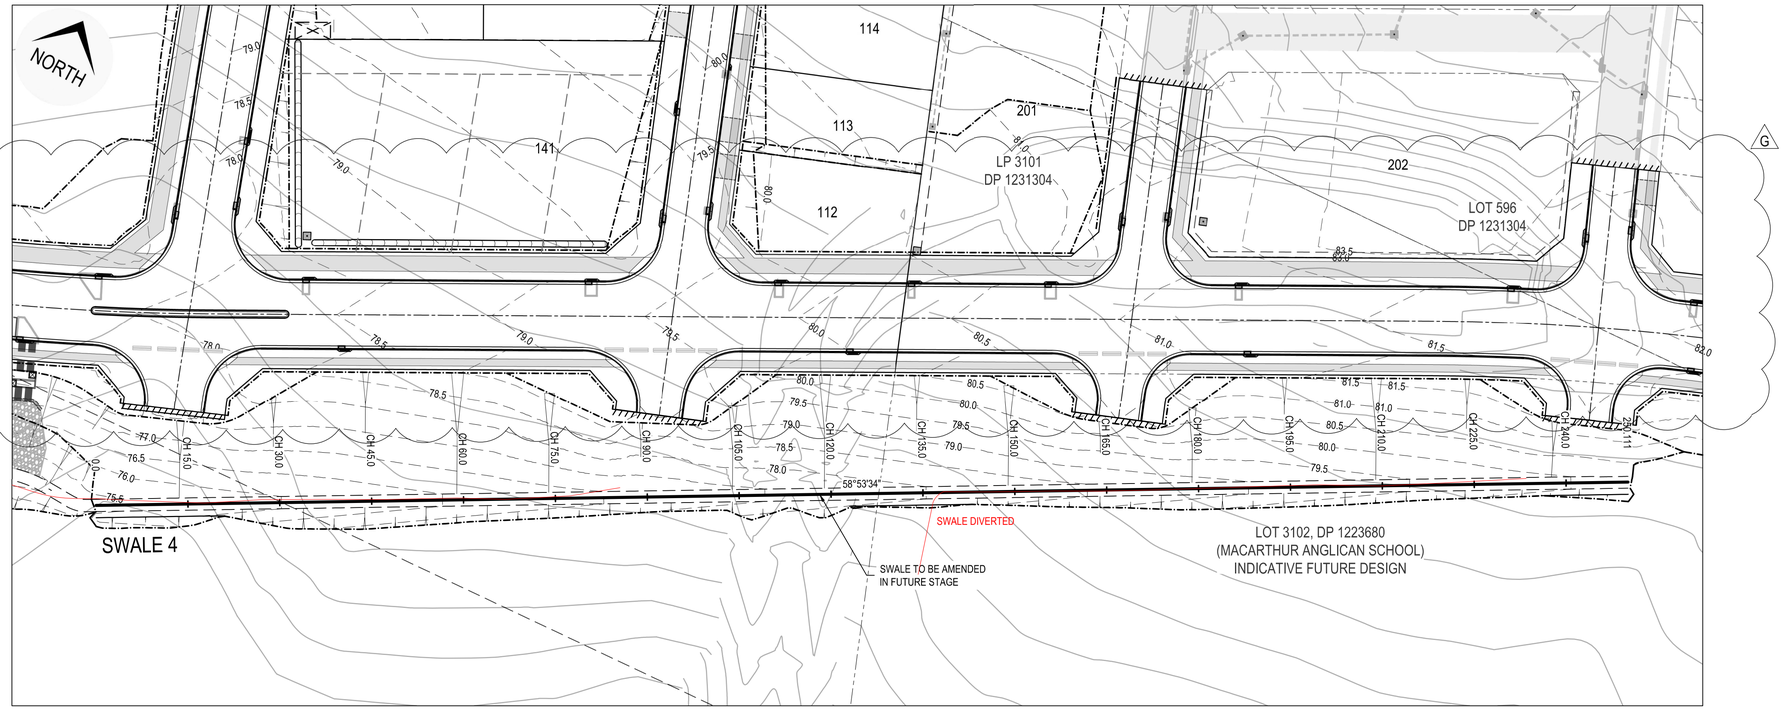

SWALE 4 - PLAN VIEW

SCALE 1:500

CAMDEN COUNCIL
Approved by the Council of Camden under the provisions of the Environment Planning and Assessment Act 1979
APPROVAL

22/03/2024

SUBDIVISION WORKS CERTIFICATE

DA/2023/215/1 SWC.16.2023.215.1

WORKS AS EXECUTED

WORKS AS EXECUTED INFORMATION SHOWN IN RED.
DATE: 07/02/2025

REGISTERED SURVEYOR ID: 8890
ORION GROUP

LEGEND

- DESIGN SURFACE
- EXISTING SURFACE
- FUTURE SURFACE

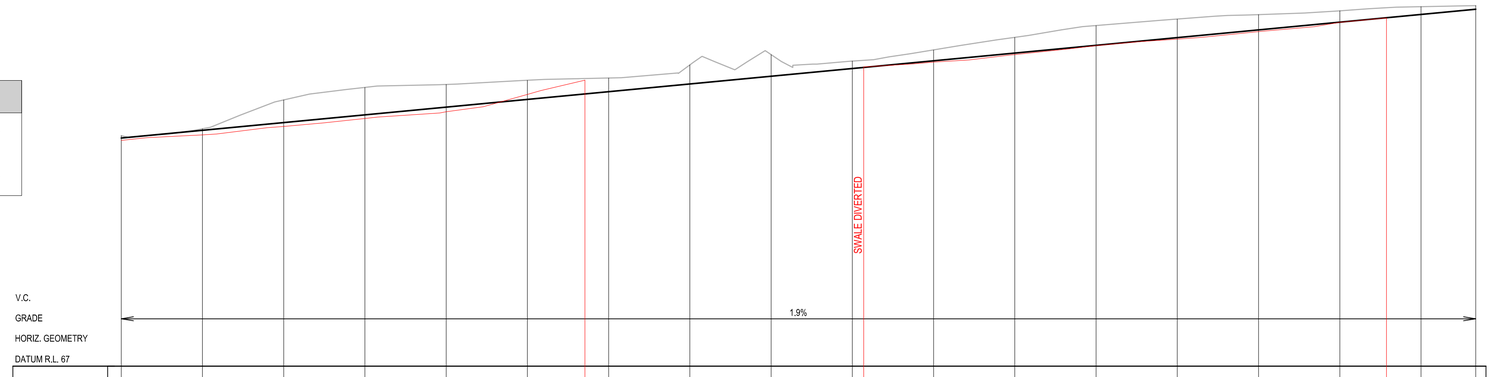

W.A.E.	75.33	75.54	75.85	76.14	76.39	77.03	77.56					78.04	78.22	78.50	78.83	79.07	79.35	79.69	79.85						
DESIGN LEVEL	75.425	75.71	75.995	76.28	76.565	76.85		77.135	77.42	77.705	77.99	78.275	78.56	78.845	79.13	79.415	79.7			79.985	80.177				
EXISTING LEVEL	75.511	75.765	75.829	77.293	77.4	77.556		77.64	78.126	78.502	78.266	78.877	79.14	79.577	79.816	79.981	80.12			80.273	80.313				
CHAINAGE	0	15	30	45	60	75	85.63	90	105	120	135	137.10	150	165	180	195	210	225	233.62	240	250.111				

LONGITUDINAL SECTION - SWALE 4

SCALE 1:500 (H)
SCALE 1:100 (V)

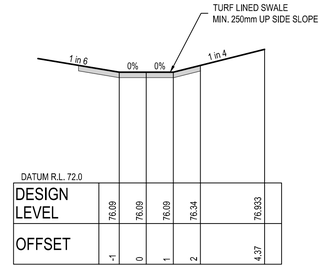

DESIGN LEVEL	76.09	76.09	76.09	76.34	76.933
OFFSET	-1	0	1	2	4.37

SWALE 4 TYPICAL SECTION

SCALE 1:100 NATURAL

ISSUED FOR SUBDIVISION WORKS CERTIFICATE

Rev	Drawn	Design	Check	Appd.	Date	Revision Description
G	RL/WP	LMc	AP	AP	20/03/2024	ISSUED FOR SUBDIVISION WORKS CERTIFICATE
F	WP	LMc	AP	AP	07/03/2024	ISSUED FOR SUBDIVISION WORKS CERTIFICATE
E	WP	LMc	AP	AP	27/02/2024	ISSUED FOR SUBDIVISION WORKS CERTIFICATE
D	RL	LMc	AP	AP	07/02/2024	ISSUED FOR SUBDIVISION WORKS CERTIFICATE
C	RL	LMc	AP	AP	23/01/2024	ISSUED FOR SUBDIVISION WORKS CERTIFICATE
B	RL	LMc	MP	AP	01/12/2023	ISSUED FOR SUBDIVISION WORKS CERTIFICATE
A	RL	LM/YK	MP	AP	27/11/2023	ISSUED FOR SUBDIVISION WORKS CERTIFICATE

Disclaimer and Copyright:
ALL DIMENSIONS TO BE CHECKED ON SITE BY THE CONTRACTOR PRIOR TO CONSTRUCTION.
USE WRITTEN DIMENSIONS ONLY. DO NOT SCALE.
THESE DRAWINGS, PLANS, AND SPECIFICATIONS AND THE COPYRIGHT ARE THE PROPERTY OF ORION CONSULTING ENGINEERS PTY LTD AND MUST NOT BE REPRODUCED OR COPIED WHOLLY OR IN PART WITHOUT THE PERMISSION OF ORION CONSULTING ENGINEERS PTY LTD

Scale:
0 1 2 3 4 5 6 7 8 9 10
SCALE 1:100 (A1) SCALE 1:200 (A3)
0 5 10 15 20 25 30 35 40 45 50
SCALE 1:500 (A1) SCALE 1:1000 (A3)

For: mirvac

By: ORION

ABN:25 604 069 981 **PO Box:**7936, BAULKHAM HILLS NSW 2153 **T:**(02) 8660 0035 **E:**info@theoriongroup.au

Project:
589, 591 & 593 COBBITTY ROAD, COBBITTY
(TRANCHE 4, STAGE 3a.)
ROAD & DRAINAGE DESIGN

Title:
SWALE 4
PLAN & DETAILS

Project No.	Set No.	Milestone	Plan	Revision
23-0563	01	SWC	633	G

NORTH

WORKS AS EXECUTED
WORKS AS EXECUTED INFORMATION SHOWN IN RED.
DATE: 07/02/2025
REGISTERED SURVEYOR ID: 8890
ORION GROUP

CAMDEN COUNCIL
Approved by the Council of Camden under the provisions of the Environment Planning and Assessment Act 1979
APPROVAL

02/07/2024

SUBDIVISION WORKS CERTIFICATE

DA/DA/2023/215/2 SWC.16.2023.215.2

LEGEND

SINGLE TIER CONCRETE I-BEAM RETAINING WALL (REFER DRG SWC 701 FOR DETAIL)	
MASONRY BLOCK RETAINING WALL (REFER DRG SWC 701 FOR DETAIL)	
BATTER VARIES MAX 1V:10H BATTER (4.5m WIDE)	
STANDARD LOT BENCHING BATTER MAX HEIGHT 0.3m AT 1V:2H (TYP.) (REFER TO TYPICAL DETAIL)	
RETAINING WALL EASEMENT FOR SUPPORT, ACCESS AND MAINTENANCE (0.9m WIDE)	(E)
RETAINING WALL EASEMENT FOR SUPPORT OVER RETAINING WALL (0.9m WIDE)	(E1)
RESTRICTION ON THE USE OF LAND - RETAINING WALLS	*

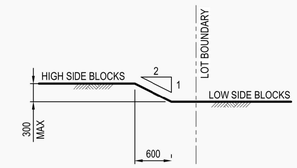

TYPICAL SIDE BOUNDARY 1V:2H BATTER
NOT TO SCALE

MASONRY WALL WITHIN 8m OF ROAD RESERVE (TYP)

FUTURE SCHOOL

ROAD 22
ROAD 40A
ROAD 24
ROAD 27
ROAD 29
ROAD 28
HOOK STREET
WISTERIA RISE
CHARLES MCINTOSH PARKWAY

ARCADIAN HILLS
EXISTING DEVELOPMENT

LP 3101
DP 1231304

LOT 596
DP 1231304

STAIRS TO BE INSTALLED FOR PEDESTRIAN ACCESS TO CHARLES MCINTOSH PARKWAY FOR EACH FUTURE TERRACE LOT. LOCATION AND TYPE BY OTHERS

PT146

ISSUED FOR **SUBDIVISION WORKS CERTIFICATE**

Rev	Drawn	Design	Check	Appd.	Date	Revision Description
B	WP	LMc	AP	AP	19/06/2024	RE-ISSUED FOR SWC MOD APPROVAL
A	RL	LMc	AP	AP	24/05/2024	ISSUED FOR SWC MOD APPROVAL

Disclaimer and Copyright:
ALL DIMENSIONS TO BE CHECKED ON SITE BY THE CONTRACTOR PRIOR TO CONSTRUCTION.
USE WRITTEN DIMENSIONS ONLY, DO NOT SCALE.
THESE DRAWINGS, PLANS, AND SPECIFICATIONS AND THE COPYRIGHT ARE THE PROPERTY OF ORION CONSULTING ENGINEERS PTY LTD AND MUST NOT BE REPRODUCED OR COPIED WHOLLY OR IN PART WITHOUT THE PERMISSION OF ORION CONSULTING ENGINEERS PTY LTD

Scale:
0 5 10 15 20 25 30 35 40 45 50
SCALE 1:500 (A1) SCALE 1:1000 (A3)

For: mirvac

By: ORION
ABN:25 604 069 981 PO Box:7936, BAULKHAM HILLS NSW 2153 T:(02) 8660 0035 E:info@theoriongroup.au

Project:
589, 591 & 593 COBBITTY ROAD, COBBITTY
(TRANCHE 4, STAGE 3a.)
ROAD & DRAINAGE DESIGN

Title:
LOT BENCHING & RETAINING WALL PLAN

Project No.	Set No.	Milestone	Plan	Revision
23-0563	02	MOD	700	B

WORKS AS EXECUTED

WORKS AS EXECUTED INFORMATION SHOWN IN RED.
DATE: 07/02/2025

REGISTERED SURVEYOR ID: 8890
ORION GROUP

NOTE:

- **ALL** RETAINING WALLS TO BE DESIGNED AND CERTIFIED BY A SUITABLY QUALIFIED STRUCTURAL ENGINEER. REFER TO STRUCTURAL PLANS FOR DETAILS.
- WALL DESIGN TO ENSURE NO PIERS ARE POSITIONED OVER PROPOSED STORMWATER PIPES AT CROSSINGS.
- WALLS HAVE BEEN MODELLED TO SUIT BENCH LOCATIONS, WALL STEPS TO STRUCTURAL DESIGN.
- WALL TYPES TO BE IN ACCORDANCE WITH THE 'MIRVAC LOT BENCHING SPECIFICATION'.

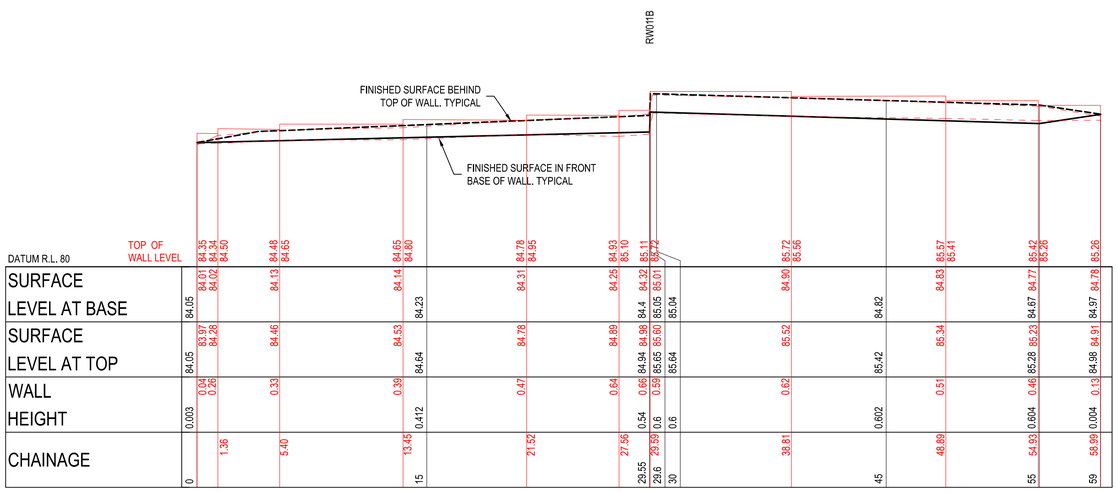

| | | |

NOTE:
- **ALL** RETAINING WALLS TO BE DESIGNED AND CERTIFIED BY A SUITABLY QUALIFIED STRUCTURAL ENGINEER. REFER TO STRUCTURAL PLANS FOR DETAILS.
- WALL DESIGN TO ENSURE NO PIERS ARE POSITIONED OVER PROPOSED STORMWATER PIPES AT CROSSINGS.
- WALLS HAVE BEEN MODELLED TO SUIT BENCH LOCATIONS, WALL STEPS TO STRUCTURAL DESIGN.
- WALL TYPES TO BE IN ACCORDANCE WITH THE 'MIRVAC LOT BENCHING SPECIFICATION'.

WORKS AS EXECUTED
WORKS AS EXECUTED INFORMATION SHOWN IN RED.
DATE: 07/02/2025
REGISTERED SURVEYOR ID: 8890
ORION GROUP

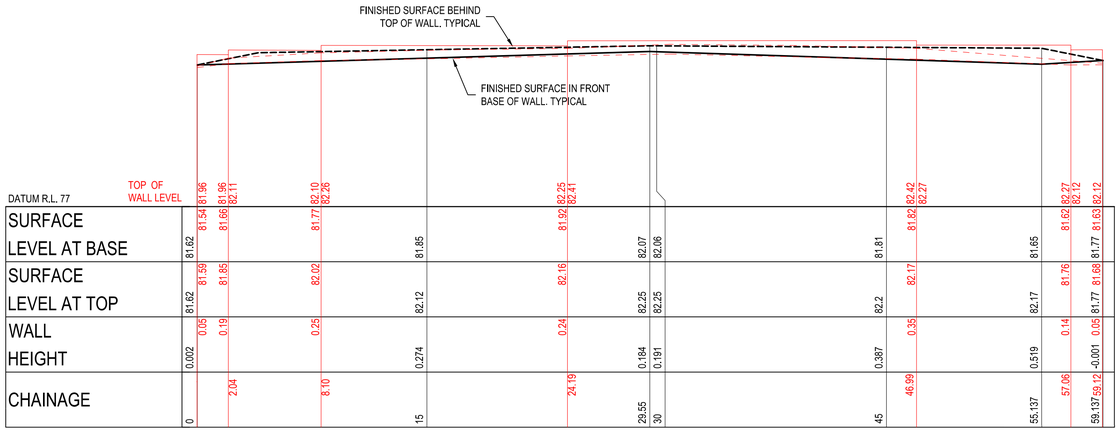

RETAINING WALL PROFILE - RW07
SCALE 1:200 (H)
SCALE 1:100 (V)

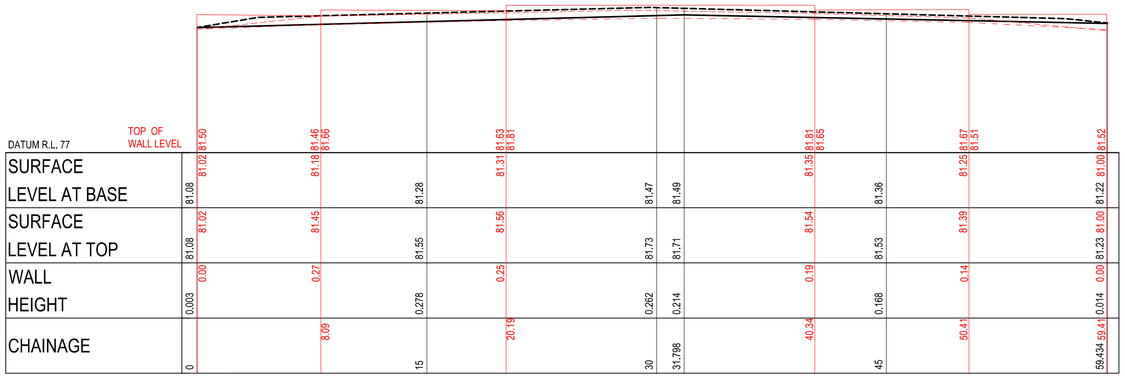

RETAINING WALL PROFILE - RW08
SCALE 1:200 (H)
SCALE 1:100 (V)

CAMDEN COUNCIL
Approved by the Council of Camden under the provisions of the Environment Planning and Assessment Act 1979
APPROVAL
22/03/2024
SUBDIVISION WORKS CERTIFICATE
DA/2023/215/1 SWC.16.2023.215.1

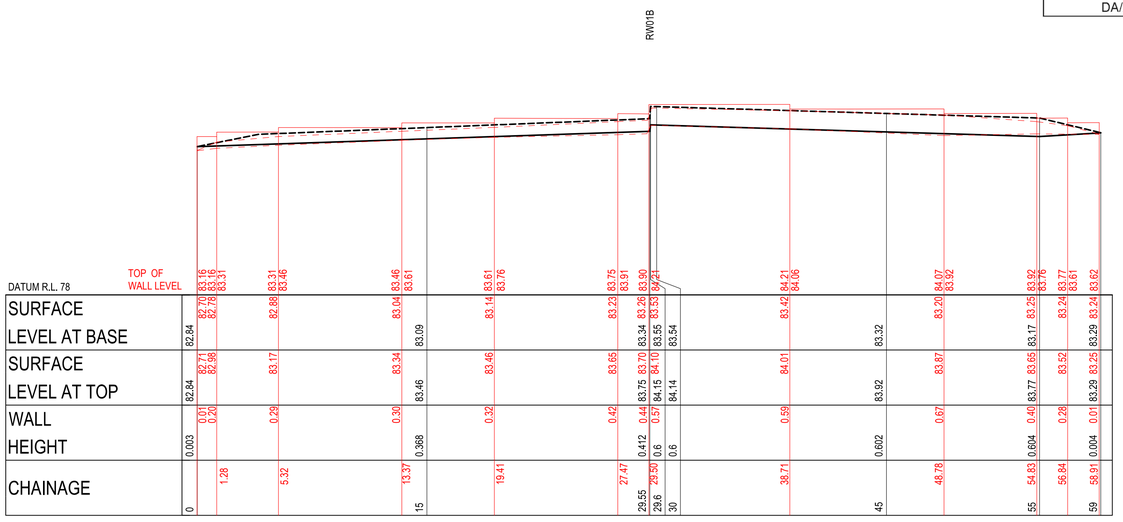

RETAINING WALL PROFILE - RW05
SCALE 1:200 (H)
SCALE 1:100 (V)

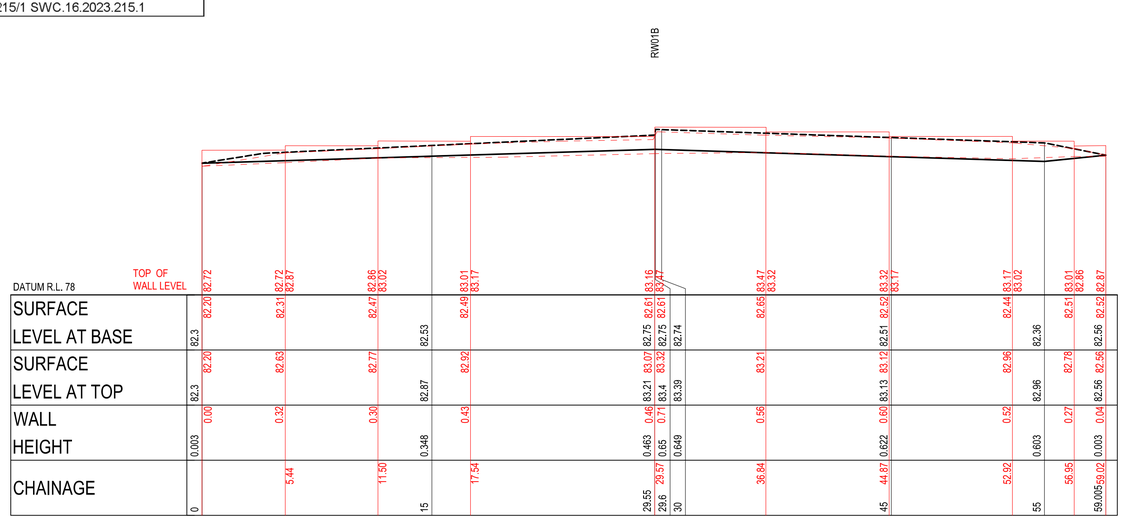

RETAINING WALL PROFILE - RW06
SCALE 1:200 (H)
SCALE 1:100 (V)

ISSUED FOR SUBDIVISION WORKS CERTIFICATE

Rev	Drawn	Design	Check	Appd.	Date	Revision Description
F	WP	LMc	AP	AP	07/03/2024	ISSUED FOR SUBDIVISION WORKS CERTIFICATE
E	WP	LMc	AP	AP	27/02/2024	ISSUED FOR SUBDIVISION WORKS CERTIFICATE
D	RL	LMc	AP	AP	07/02/2024	ISSUED FOR SUBDIVISION WORKS CERTIFICATE
C	RL	LMc	AP	AP	23/01/2024	ISSUED FOR SUBDIVISION WORKS CERTIFICATE
B	RL	LMc	MP	AP	01/12/2023	ISSUED FOR SUBDIVISION WORKS CERTIFICATE
A	RL	LM/YK	MP	AP	27/11/2023	ISSUED FOR SUBDIVISION WORKS CERTIFICATE

Disclaimer and Copyright:
ALL DIMENSIONS TO BE CHECKED ON SITE BY THE CONTRACTOR PRIOR TO CONSTRUCTION.
USE WRITTEN DIMENSIONS ONLY, DO NOT SCALE.
THESE DRAWINGS, PLANS, AND SPECIFICATIONS AND THE COPYRIGHT ARE THE PROPERTY OF ORION CONSULTING ENGINEERS PTY LTD AND MUST NOT BE REPRODUCED OR COPIED WHOLLY OR IN PART WITHOUT THE PERMISSION OF ORION CONSULTING ENGINEERS PTY LTD

Scale:
0 1 2 3 4 5 6 7 8 9 10
SCALE 1:100 (A1) SCALE 1:200 (A3)
0 5 10 15 20 25 30 35 40 45 50
SCALE 1:500 (A1) SCALE 1:1000 (A3)

For: mirvac

By: ORION
ABN:25 604 069 981 PO Box:7936, BAULKHAM HILLS NSW 2153 T:(02) 8660 0035 E:info@theoriongroup.au

Project:
589, 591 & 593 COBBITTY ROAD, COBBITTY
(TRANCHE 4, STAGE 3a.)
ROAD & DRAINAGE DESIGN

Title:
RETAINING WALL PROFILES SHEET 02

Project No.	Set No.	Milestone	Plan	Revision
23-0563	01	SWC	703	F

CAMDEN COUNCIL
Approved by the Council of Camden under the provisions of the Environment Planning and Assessment Act 1979
APPROVAL

22/03/2024

SUBDIVISION WORKS CERTIFICATE

DA/2023/215/1 SWC.16.2023.215.1

WORKS AS EXECUTED
WORKS AS EXECUTED INFORMATION SHOWN IN RED.
DATE: 07/02/2025

REGISTERED SURVEYOR ID: 8890
ORION GROUP

NOTE:
- **ALL** RETAINING WALLS TO BE DESIGNED AND CERTIFIED BY A SUITABLY QUALIFIED STRUCTURAL ENGINEER. REFER TO STRUCTURAL PLANS FOR DETAILS.
- WALL DESIGN TO ENSURE NO PIERS ARE POSITIONED OVER PROPOSED STORMWATER PIPES AT CROSSINGS.
- WALLS HAVE BEEN MODELLED TO SUIT BENCH LOCATIONS, WALL STEPS TO STRUCTURAL DESIGN.
- WALL TYPES TO BE IN ACCORDANCE WITH THE 'MIRVAC LOT BENCHING SPECIFICATION'.

RW40B

RETAINING WALL PROFILE - RW30
SCALE 1:200 (H)
SCALE 1:100 (V)

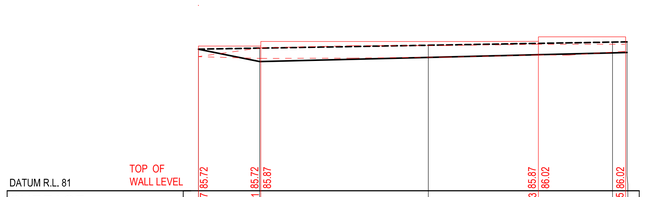

RETAINING WALL PROFILE - RW31
SCALE 1:200 (H)
SCALE 1:100 (V)

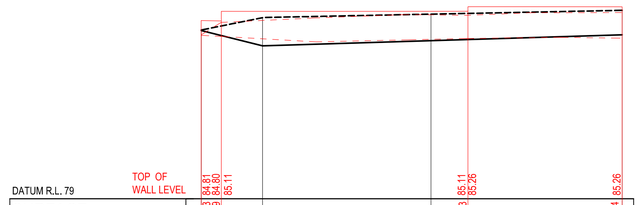

RETAINING WALL PROFILE - RW32
SCALE 1:200 (H)
SCALE 1:100 (V)

RW01B

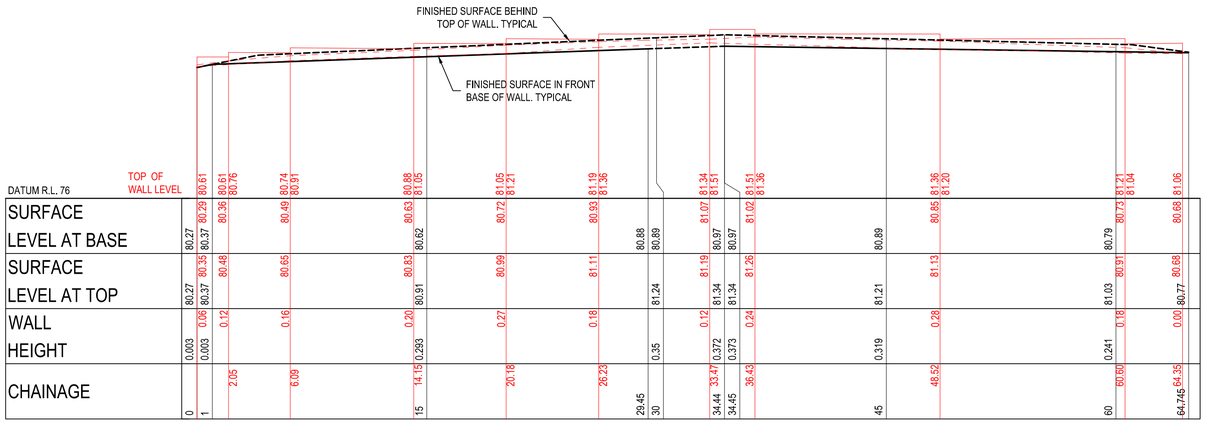

RETAINING WALL PROFILE - RW09
SCALE 1:200 (H)
SCALE 1:100 (V)

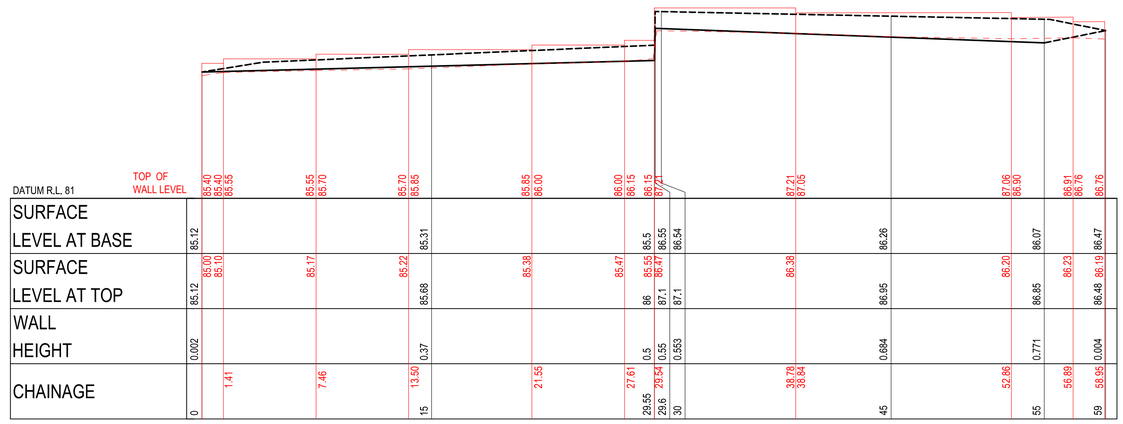

RETAINING WALL PROFILE - RW10
SCALE 1:200 (H)
SCALE 1:100 (V)

ISSUED FOR **SUBDIVISION WORKS CERTIFICATE**

Rev	Drawn	Design	Check	Appd.	Date	Revision Description
F	WP	LMc	AP	AP	07/03/2024	ISSUED FOR SUBDIVISION WORKS CERTIFICATE
E	WP	LMc	AP	AP	27/02/2024	ISSUED FOR SUBDIVISION WORKS CERTIFICATE
D	RL	LMc	AP	AP	07/02/2024	ISSUED FOR SUBDIVISION WORKS CERTIFICATE
C	RL	LMc	AP	AP	23/01/2024	ISSUED FOR SUBDIVISION WORKS CERTIFICATE
B	RL	LMc	MP	AP	01/12/2023	ISSUED FOR SUBDIVISION WORKS CERTIFICATE
A	RL	LM/YK	MP	AP	27/11/2023	ISSUED FOR SUBDIVISION WORKS CERTIFICATE

Disclaimer and Copyright:
ALL DIMENSIONS TO BE CHECKED ON SITE BY THE CONTRACTOR PRIOR TO CONSTRUCTION.
USE WRITTEN DIMENSIONS ONLY, DO NOT SCALE.
THESE DRAWINGS, PLANS, AND SPECIFICATIONS AND THE COPYRIGHT ARE THE PROPERTY OF ORION CONSULTING ENGINEERS PTY LTD AND MUST NOT BE REPRODUCED OR COPIED WHOLLY OR IN PART WITHOUT THE PERMISSION OF ORION CONSULTING ENGINEERS PTY LTD

Scale:
0 1 2 3 4 5 6 7 8 9 10
SCALE 1:100 (A1) SCALE 1:200 (A3)
0 5 10 15 20 25 30 35 40 45 50
SCALE 1:500 (A1) SCALE 1:1000 (A3)

For: mirvac

By: ORION
ABN:25 604 069 981 **PO Box:**7936, BAULKHAM HILLS NSW 2153 **T:**(02) 8660 0035 **E:**info@theoriongroup.au

Project:
589, 591 & 593 COBBITTY ROAD, COBBITTY
(TRANCHE 4, STAGE 3a.)
ROAD & DRAINAGE DESIGN

Title:
RETAINING WALL PROFILES SHEET 03

Project No.	Set No.	Milestone	Plan	Revision
23-0563	01	SWC	704	F

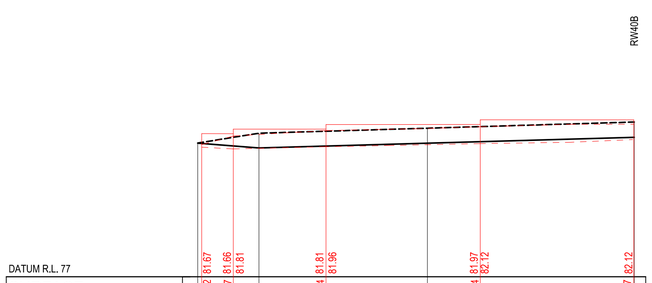

| DATUM R.L. 77 | | |

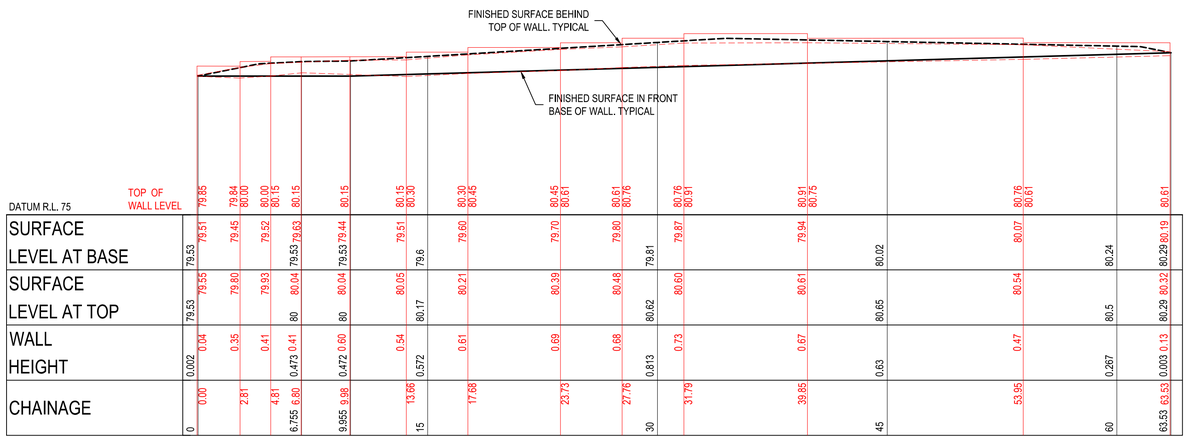
FINISHED SURFACE BEHIND TOP OF WALL. TYPICAL
FINISHED SURFACE IN FRONT BASE OF WALL. TYPICAL

| | | |

WORKS AS EXECUTED

WORKS AS EXECUTED INFORMATION SHOWN IN RED.
DATE: 07/02/2025

REGISTERED SURVEYOR ID: 8890
ORION GROUP

NOTE:

- **ALL** RETAINING WALLS TO BE DESIGNED AND CERTIFIED BY A SUITABLY QUALIFIED STRUCTURAL ENGINEER. REFER TO STRUCTURAL PLANS FOR DETAILS.
- WALL DESIGN TO ENSURE NO PIERS ARE POSITIONED OVER PROPOSED STORMWATER PIPES AT CROSSINGS.
- WALLS HAVE BEEN MODELLED TO SUIT BENCH LOCATIONS, WALL STEPS TO STRUCTURAL DESIGN.
- WALL TYPES TO BE IN ACCORDANCE WITH THE 'MIRVAC LOT BENCHING SPECIFICATION'.

CAMDEN COUNCIL
Approved by the Council of Camden under the provisions of the Environment Planning and Assessment Act 1979
APPROVAL

22/03/2024

SUBDIVISION WORKS CERTIFICATE

DA/2023/215/1 SWC.16.2023.215.1

G

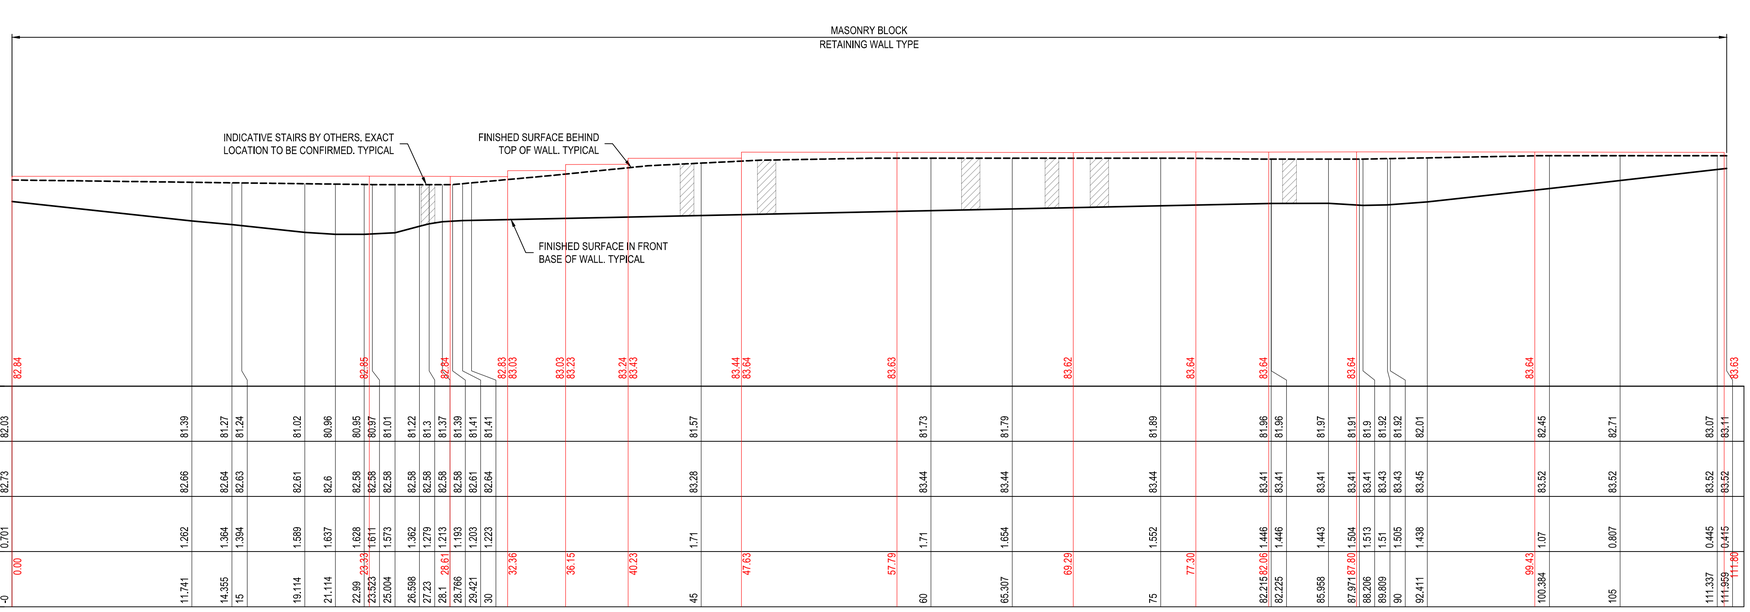

| | | |